
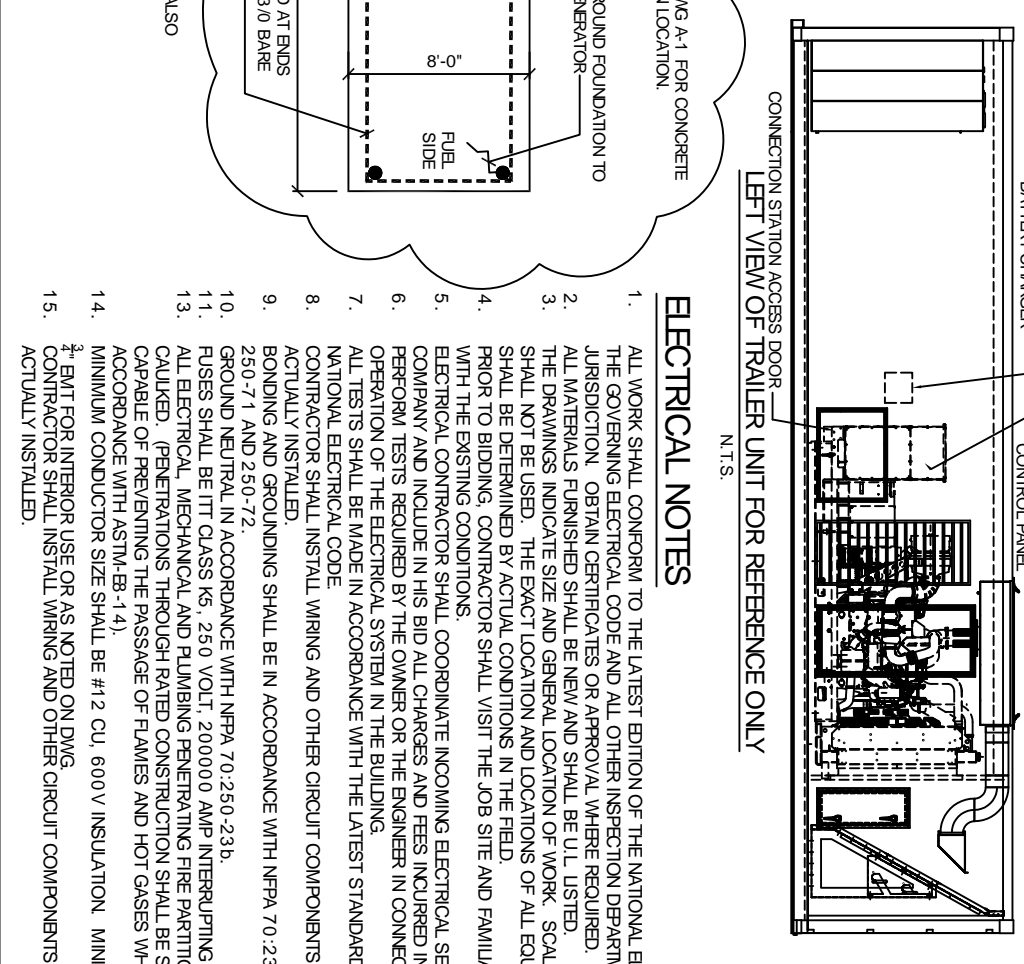





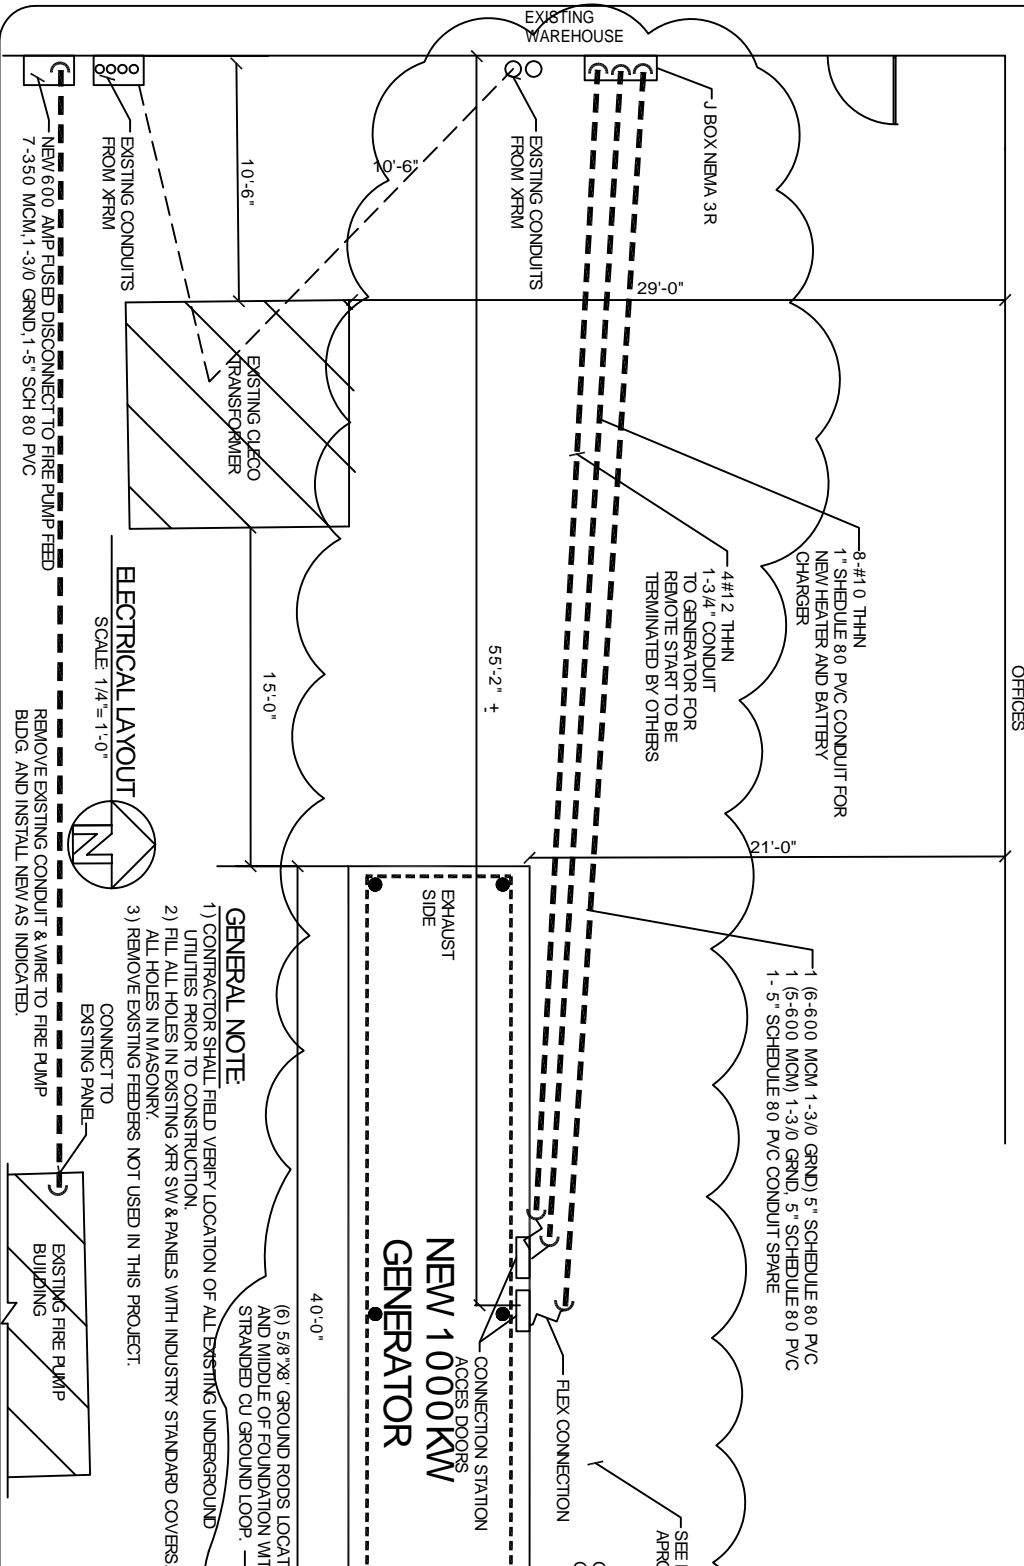

- ELECTRICAL NOTES**
1. ALL WORK SHALL CONFORM TO THE LATEST EDITION OF THE NATIONAL ELECTRICAL CODE THE COVERING ELECTRICAL CODE AND ALL OTHER INSPECTION DEPARTMENTS HAVING JURISDICTION. OBTAIN CERTIFICATES OR APPROVAL WHERE REQUIRED.
 2. ALL MATERIALS FURNISHED SHALL BE NEW AND SHALL BE U.L. LISTED.
 3. THE DRAWINGS INDICATE SIZE AND GENERAL LOCATION OF ALL EQUIPMENT, SHALL NOT BE USED. THE EXACT LOCATION AND LOCATIONS OF ALL EQUIPMENT, SHALL BE DETERMINED BY ACTUAL CONDITIONS IN THE FIELD.
 4. PRIOR TO BIDDING, CONTRACTOR SHALL VISIT THE JOB SITE AND FAMILIARIZE THEMSELVES WITH THE EXISTING CONDITIONS.
 5. ELECTRICAL CONTRACTOR SHALL COORDINATE INCOMING ELECTRICAL SERVICE WITH UTILITY COMPANY AND INCLUDE IN HIS BID ALL CHARGES AND FEES INCURRED IN MODIFICATIONS, PERFORM TESTS REQUIRED BY THE OWNER OR THE ENGINEER IN CONNECTION WITH THE OPERATION OF THE ELECTRICAL SYSTEM IN THE BUILDING.
 6. ALL TESTS SHALL BE MADE IN ACCORDANCE WITH THE LATEST STANDARD OF THE IEEE AND THE NATIONAL ELECTRICAL CODE.
 7. CONTRACTOR SHALL INSTALL WIRING AND OTHER CIRCUIT COMPONENTS TO MATCH EQUIPMENT ACTUALLY INSTALLED.
 8. BONDING AND GROUNDING SHALL BE IN ACCORDANCE WITH NFPA 70:250-23b, NFPA 70:250-23, 250-71 AND 250-72.
 9. GROUND NEUTRAL IN ACCORDANCE WITH NFPA 70:250-23b.
 10. FUSES SHALL BE ITC CLASS K5, 250 VOLT, 200000 AMP INTERRUPTING CAP.
 11. ALL ELECTRICAL, MECHANICAL AND PLUMBING PENETRATING FIRE PARTITIONS SHALL BE FIRE CAULKED. PENETRATIONS THROUGH RATED CONSTRUCTION SHALL BE SEALED WITH A MATERIAL CAPABLE OF PREVENTING THE PASSAGE OF FLAMES AND HOT GASES WHEN TESTED IN ACCORDANCE WITH ASTM-B-14.
 13. CONTRACTOR SHALL INSTALL WIRING AND OTHER CIRCUIT COMPONENTS TO MATCH EQUIPMENT ACTUALLY INSTALLED.


GENERAL NOTE

- 1) CONTRACTOR SHALL FIELD VERIFY LOCATION OF ALL EXISTING UNDERGROUND UTILITIES PRIOR TO CONSTRUCTION.
- 2) FILL ALL HOLES IN EXISTING XFR SW & PANELS WITH INDUSTRY STANDARD COVERS. ALSO ALL HOLES IN MASONRY.
- 3) REMOVE EXISTING FEEDERS NOT USED IN THIS PROJECT. CONNECT TO EXISTING PANEL.



TEXTRON MARINE & LAND 252 STONE ROAD SUDELL, LA 70460	ELECTRICAL LAYOUT	1000KW GENERATOR
REV: 10-28-08	SCALE: AS NOTED	JOB#: 1969
DATE: 10-08-08	SHEET	E-1

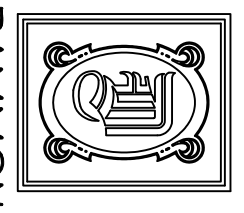

DAMMON ENGINEERING, INC.
 CHIEF ENGINEER
 EMMETT DAMMON, P.E.
 CHIEF ARCHITECT
 ROBERT WILTSE

1095 FLORIDA AVENUE
 SUDELL, LA. 70458
 OFFICE: 905-649-5632
 FAX: 905-641-5950

WEBSITE:
 WWW.DAMMONENGINEERING.COM
 EMAIL:
 DAMMON@BLSOUTH.NET

ARCHITECTURE
 ENGINEERING
 STUDIES
 PLANNING
 INVESTIGATION
 EXPERT WITNESSES