



FRONT ELEVATION 1/8"=1'-0" LEFT SIDE ELEVATION 1/8"=1'-0"

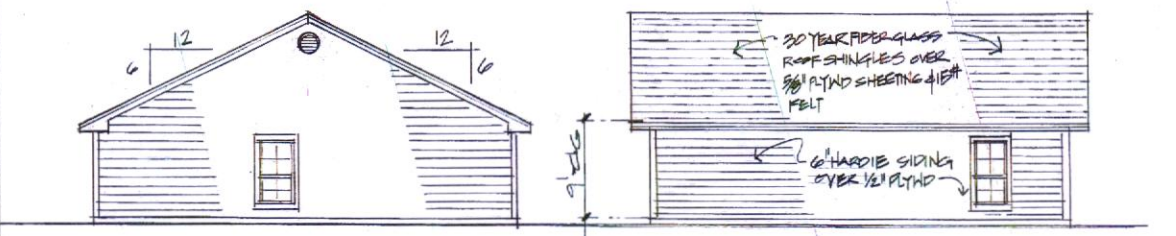


KITCHEN CABINET ELEVATION 1/4"=1'-0" BATH #2 & BATH #1 ELEVATION 1/4"=1'-0"



REAR ELEVATION 1/8"=1'-0" RIGHT SIDE ELEVATION 1/8"=1'-0"

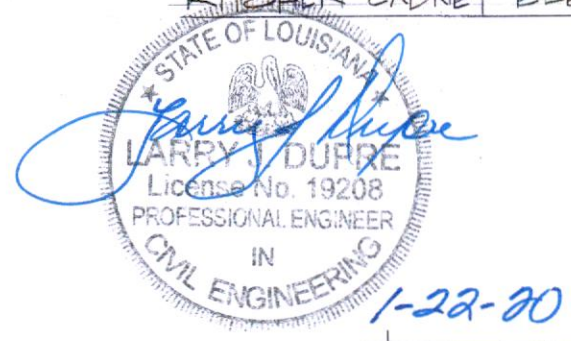


4x12 GLULAM BEAM ABOVE CEILING JOISTS FOR RAFTER BRACING

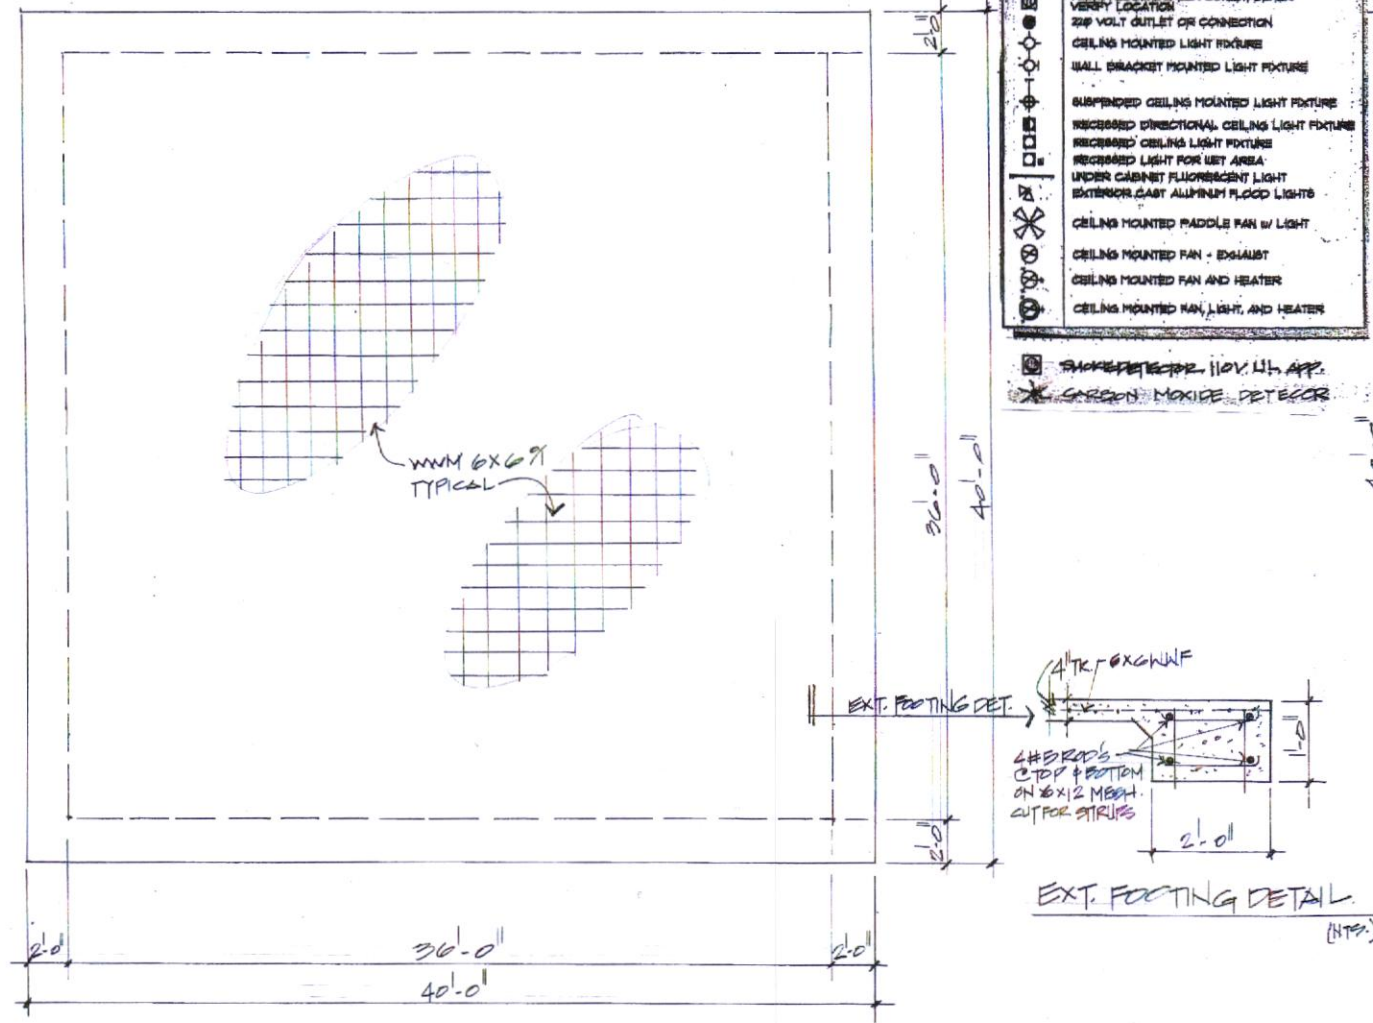

FOUNDATION PLAN 1/4"=1'-0"

SYMBOL	DESCRIPTION
[Symbol]	DUPLEX OUTLET (GROUNDING TYPE)
[Symbol]	WEATHER PROOF DUPLEX OUTLET ABOVE COUNTER LOCATION
[Symbol]	FLOOR FLOOR DUPLEX OUTLET, OTHER VERT. LOCATION
[Symbol]	240 VOLT OUTLET OR CONNECTION
[Symbol]	CEILING MOUNTED LIGHT FIXTURE
[Symbol]	WALL BRACKET MOUNTED LIGHT FIXTURE
[Symbol]	SUSPENDED CEILING MOUNTED LIGHT FIXTURE
[Symbol]	RECESSED DIRECTIONAL CEILING LIGHT FIXTURE
[Symbol]	RECESSED CEILING LIGHT FIXTURE
[Symbol]	RECESSED LIGHT FOR WET AREA
[Symbol]	UNDER CABINET FLUORESCENT LIGHT
[Symbol]	EXTERIOR CABT ALUMINUM FLOOD LIGHTS
[Symbol]	CEILING MOUNTED PADDLE FAN w/ LIGHT
[Symbol]	CEILING MOUNTED FAN - EXHAUST
[Symbol]	CEILING MOUNTED FAN AND HEATER
[Symbol]	CEILING MOUNTED FAN, LIGHT, AND HEATER
[Symbol]	SMOKE DETECTOR, 110V. W/ APP.

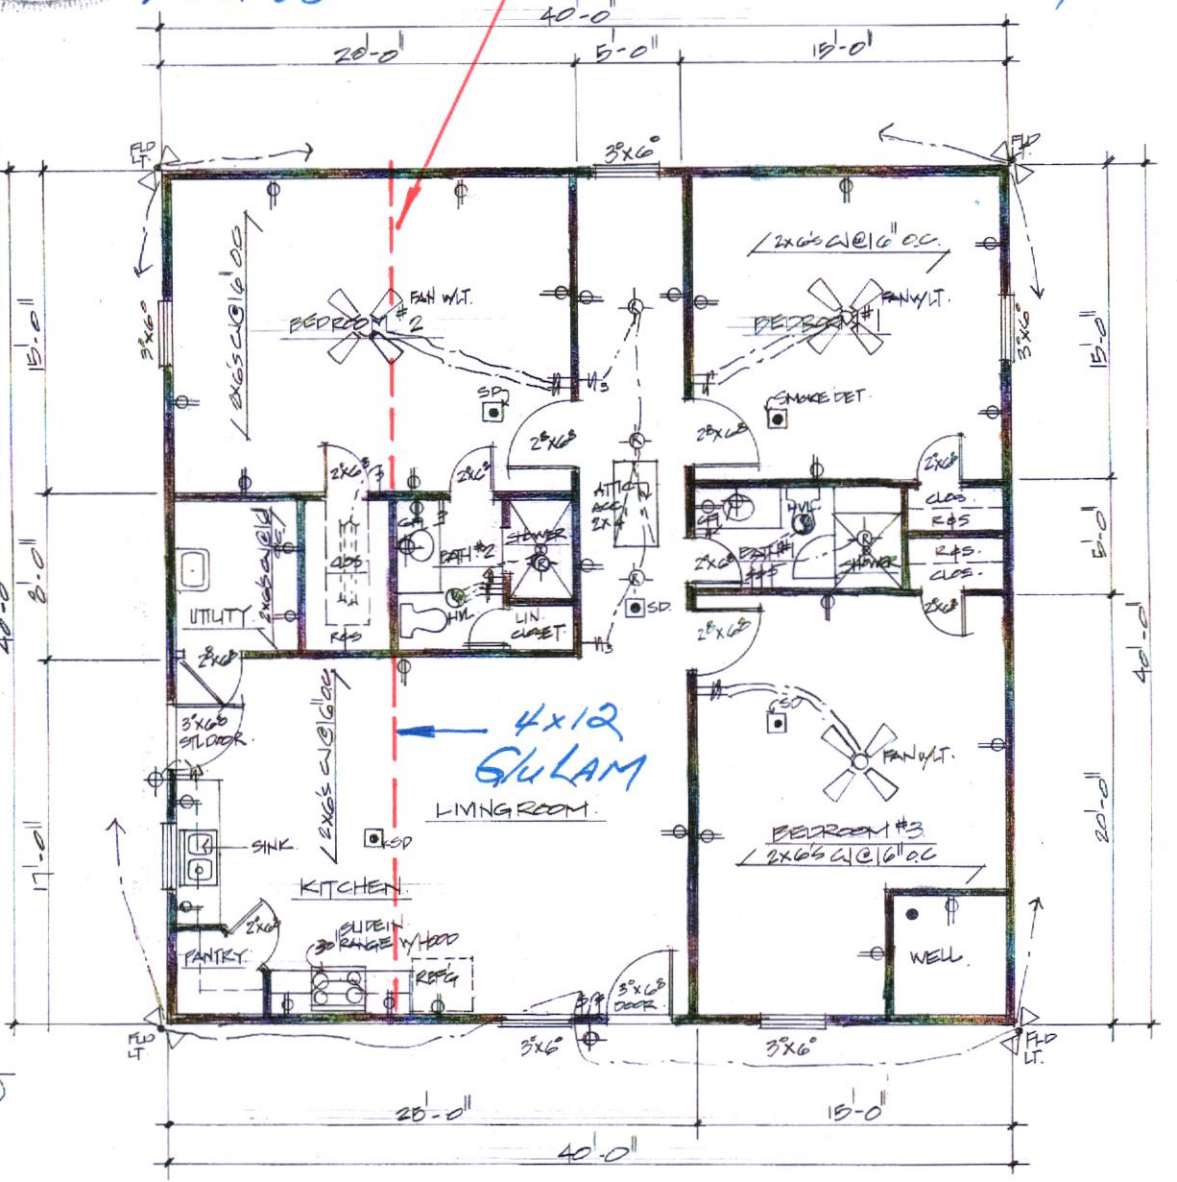

FLOOR PLAN 1/4"=1'-0"

TOTAL AREA = 1600 ±

REVISIONS	BY

PROPOSED: GUEST HOUSE BUILDING FOR: MR. ANTONIO MENDOZA LOT: 20 RAMSEY ESTATES SUBDIVISION PHASE II, STAMMANT.

DRAWN	NPL
CHECKED	
DATE	JAN 13 2020
SCALE	AS SHOWN
JOB NO.	1-1-2020
SHEET	