


12 MONTHS OLD

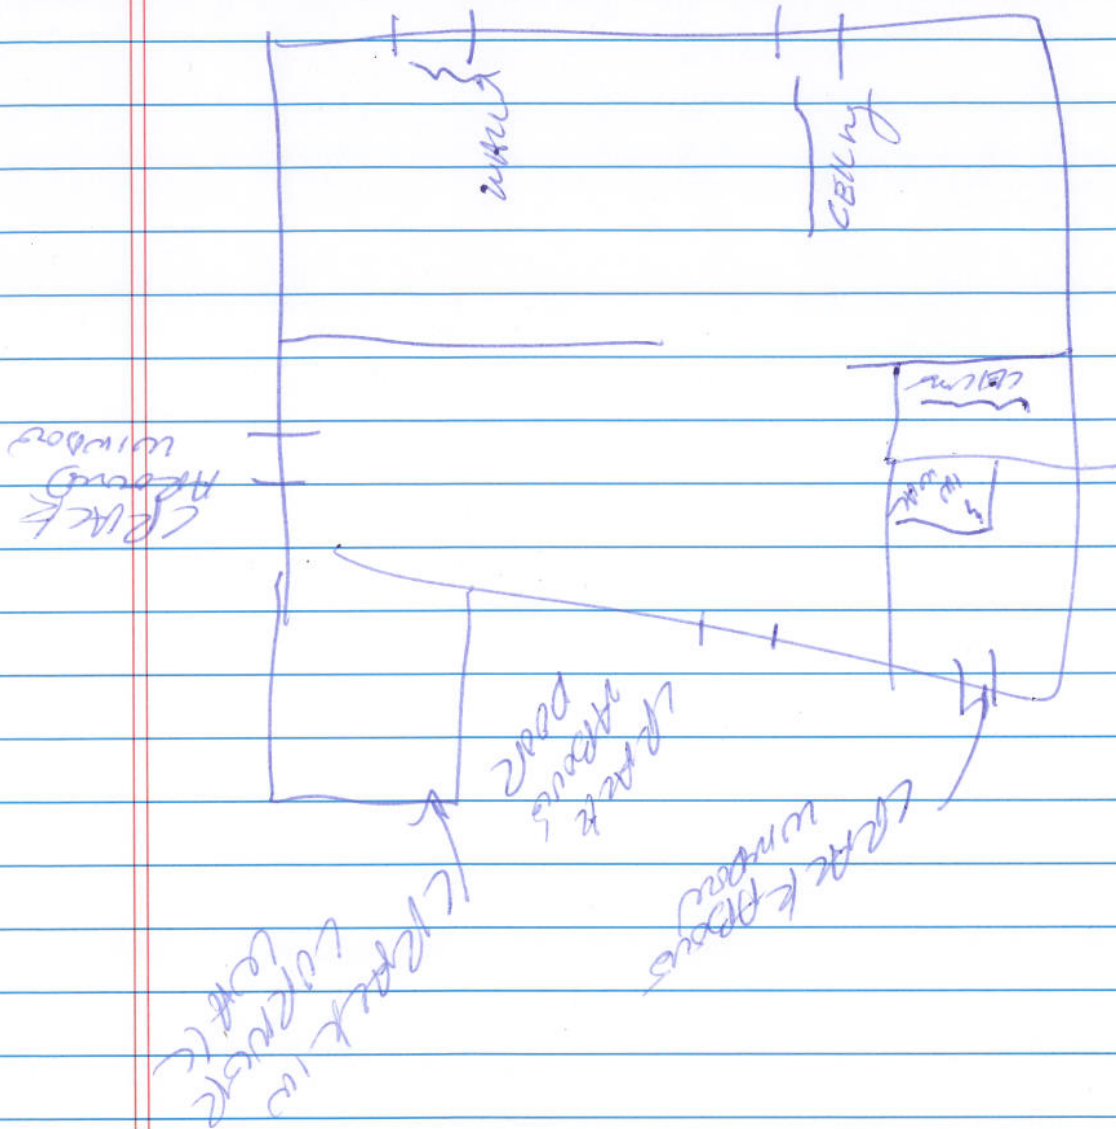

RESIDENTIAL DEMO.
DEMOLITION
COMPANY
RLS Tommy GRIFFITH
639-3433