


CERAMIC  
WOOD & CARPET

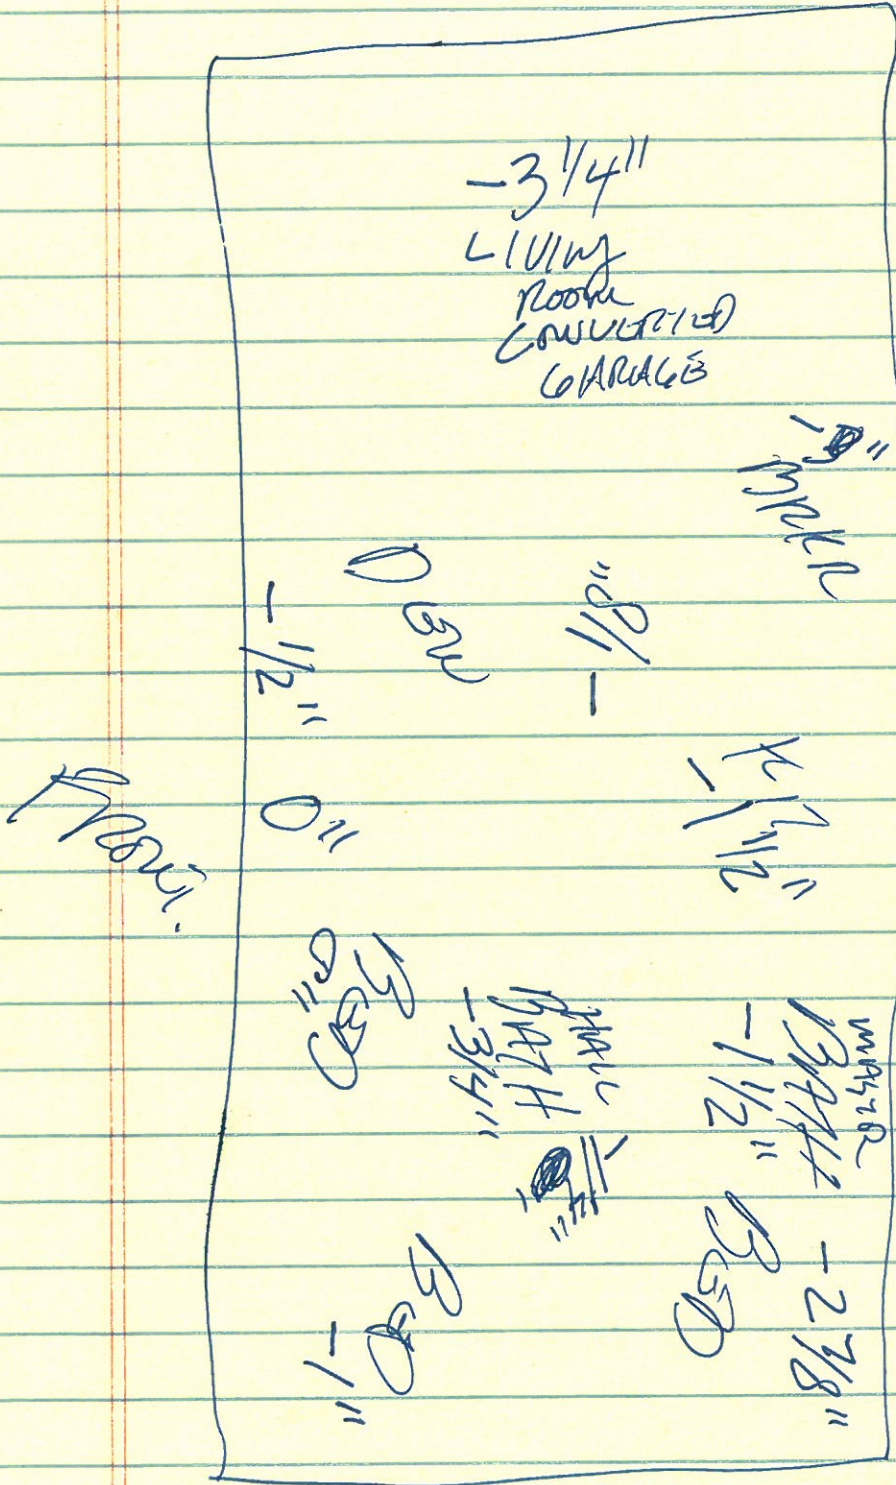

Casey Crosby  
125 Royal Oak Dr  
Slidell, LA

70460

985-640-7083