


First Floor

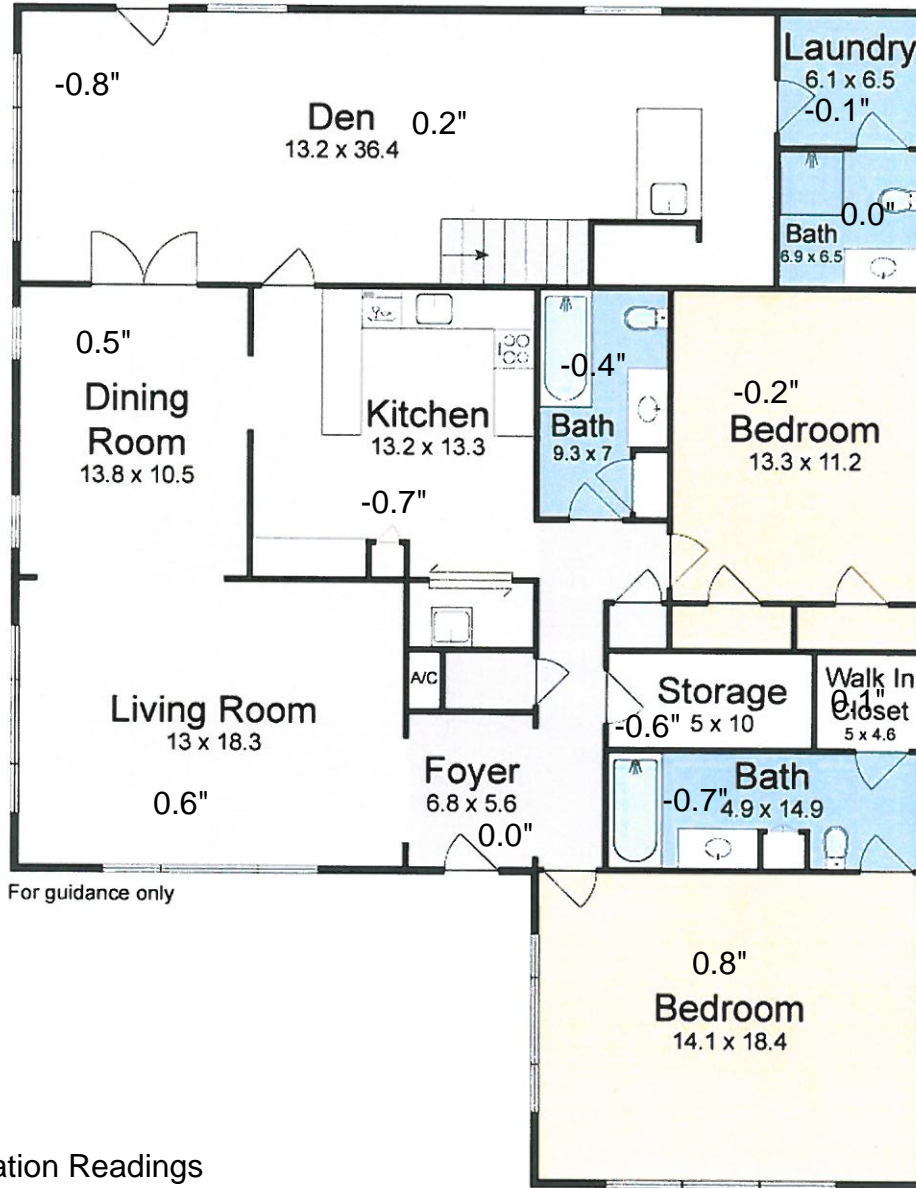

For guidance only

Elevation Readings