


FIRST FLOOR

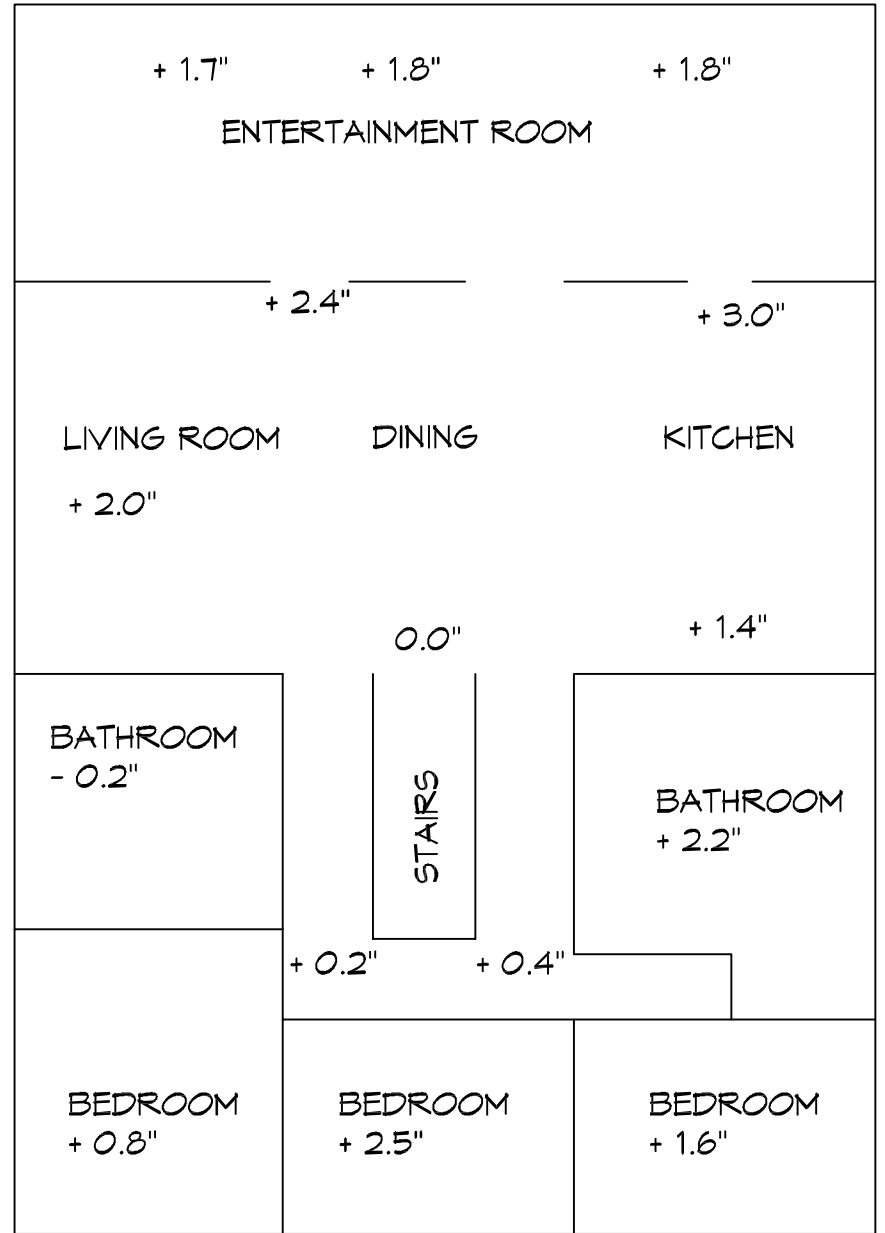

SECOND FLOOR