


1 DEMO PLAN

SCALE: N.T.S.

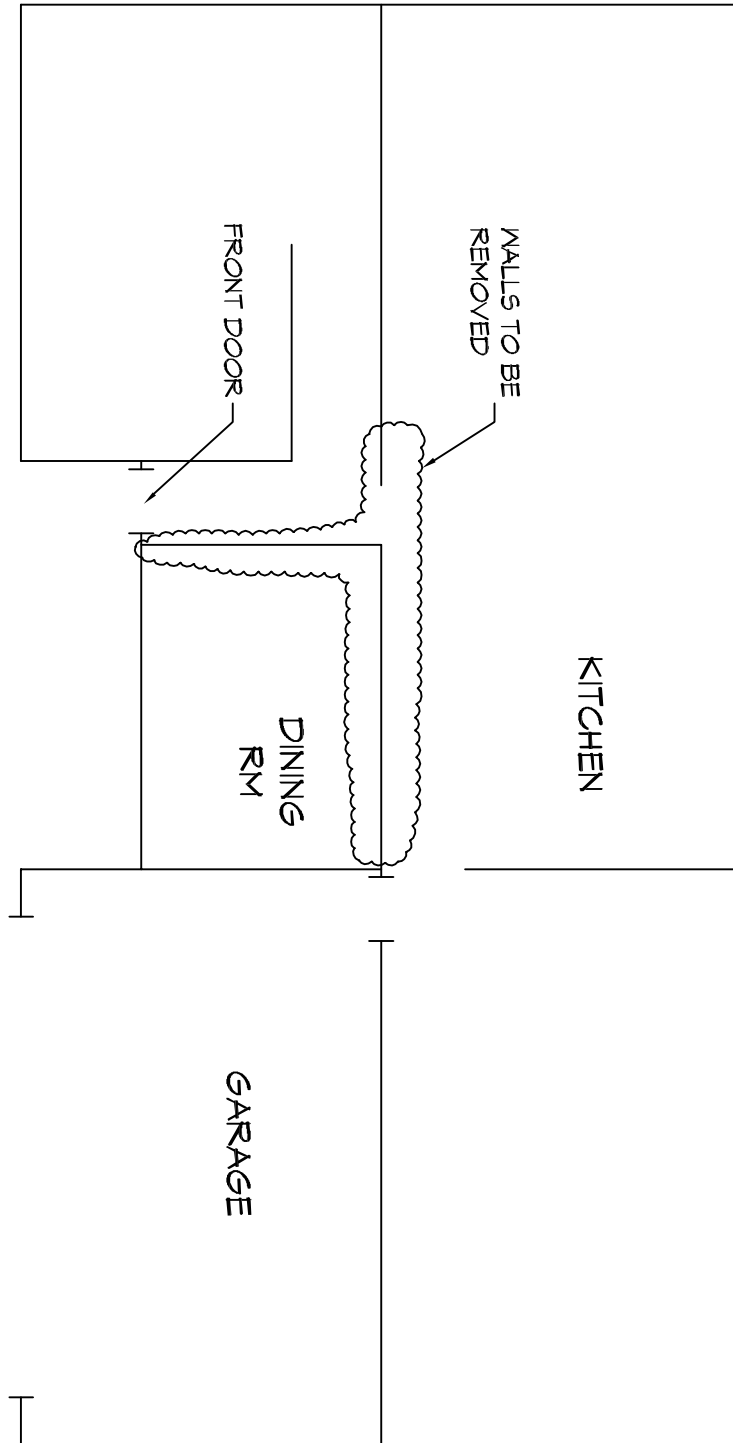

RESIDENTIAL BEAM

60267 EMILE ST
SLIDELL, LA

JOB No:

DATE: 2-21-2019

DRAWN BY:

DD

CHECKED BY:



DAMMON

ENGINEERING, INC.

554 Old Spanish Trail Slidell, LA 70458 (985) 649-5832

CHIEF ENGINEER: BRIAN A. MISTICH, P.E.
554 OLD SPANISH TRAIL
SLIDELL, LA 70458

dammonengineering.com
info@dammonengineering.com
PHONE: 985-649-5832