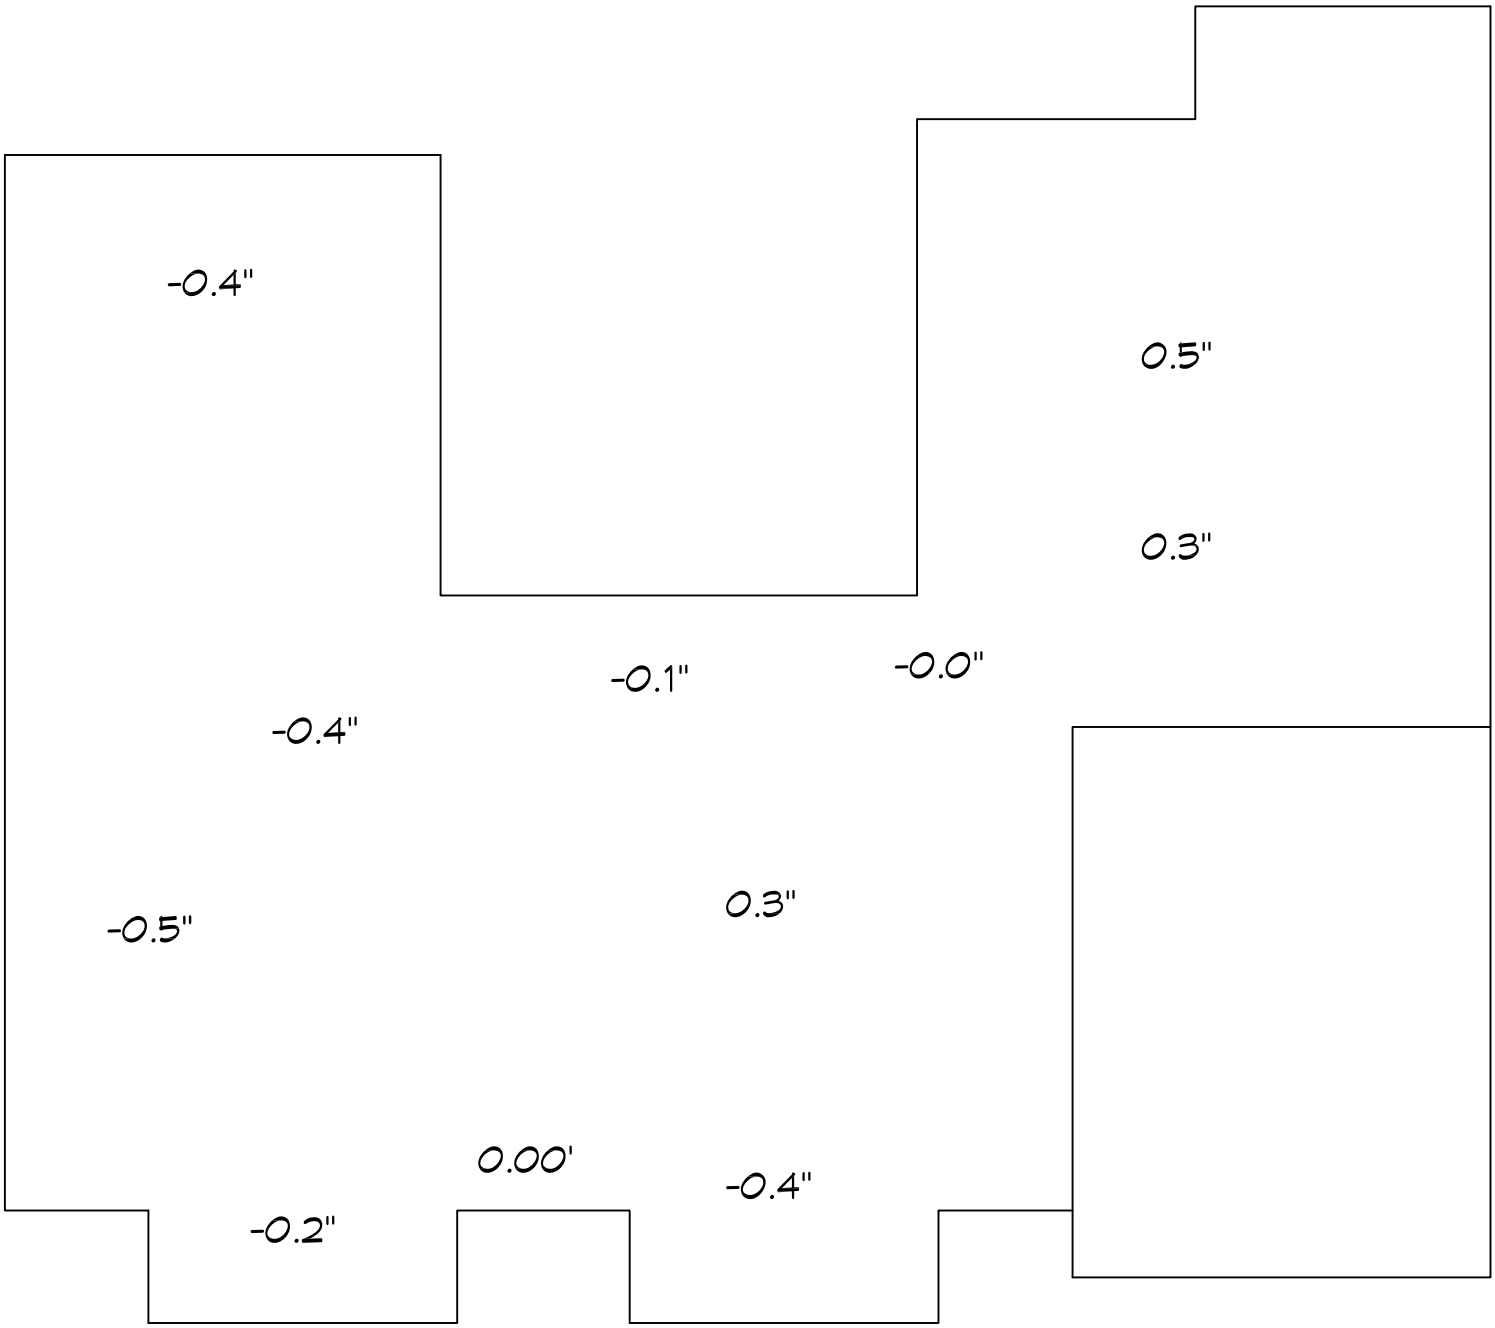

FRONT OF HOME