


SKETCH ADDENDUM

File # 43743G21

Borrower/Client	Lana M Stewart						
Property Address	110 Bayou Paquet Street						
City	Slidell	County	Saint Tammany	State	LA	Zip Code	70460
Lender							

* SIZE OF BEDROOMS
* APPROX. SIZE OF LIVING ROOM.

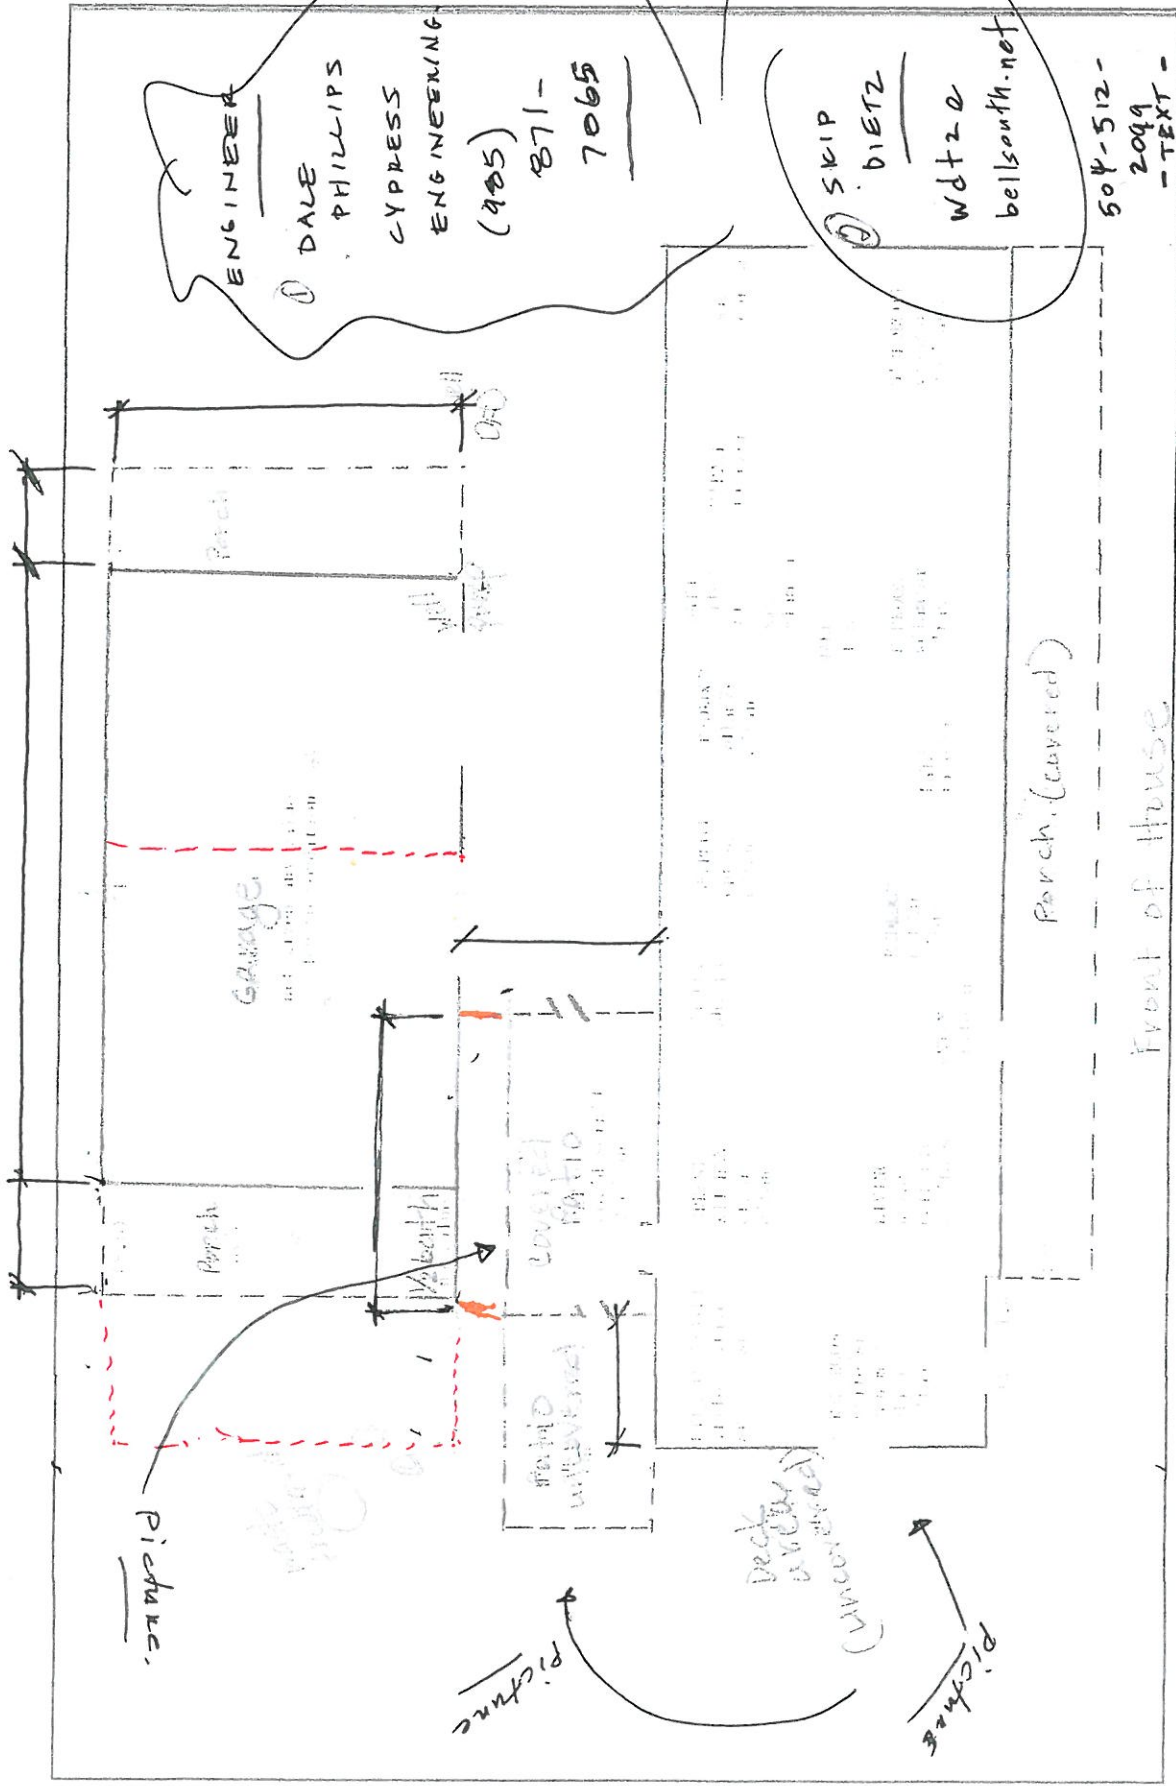

SURVEY - J.V. BURKES
- ELEVATION CERTIFICATE
- SHOW WHAT IS EXISTING (HOUSE)