




BAY #3

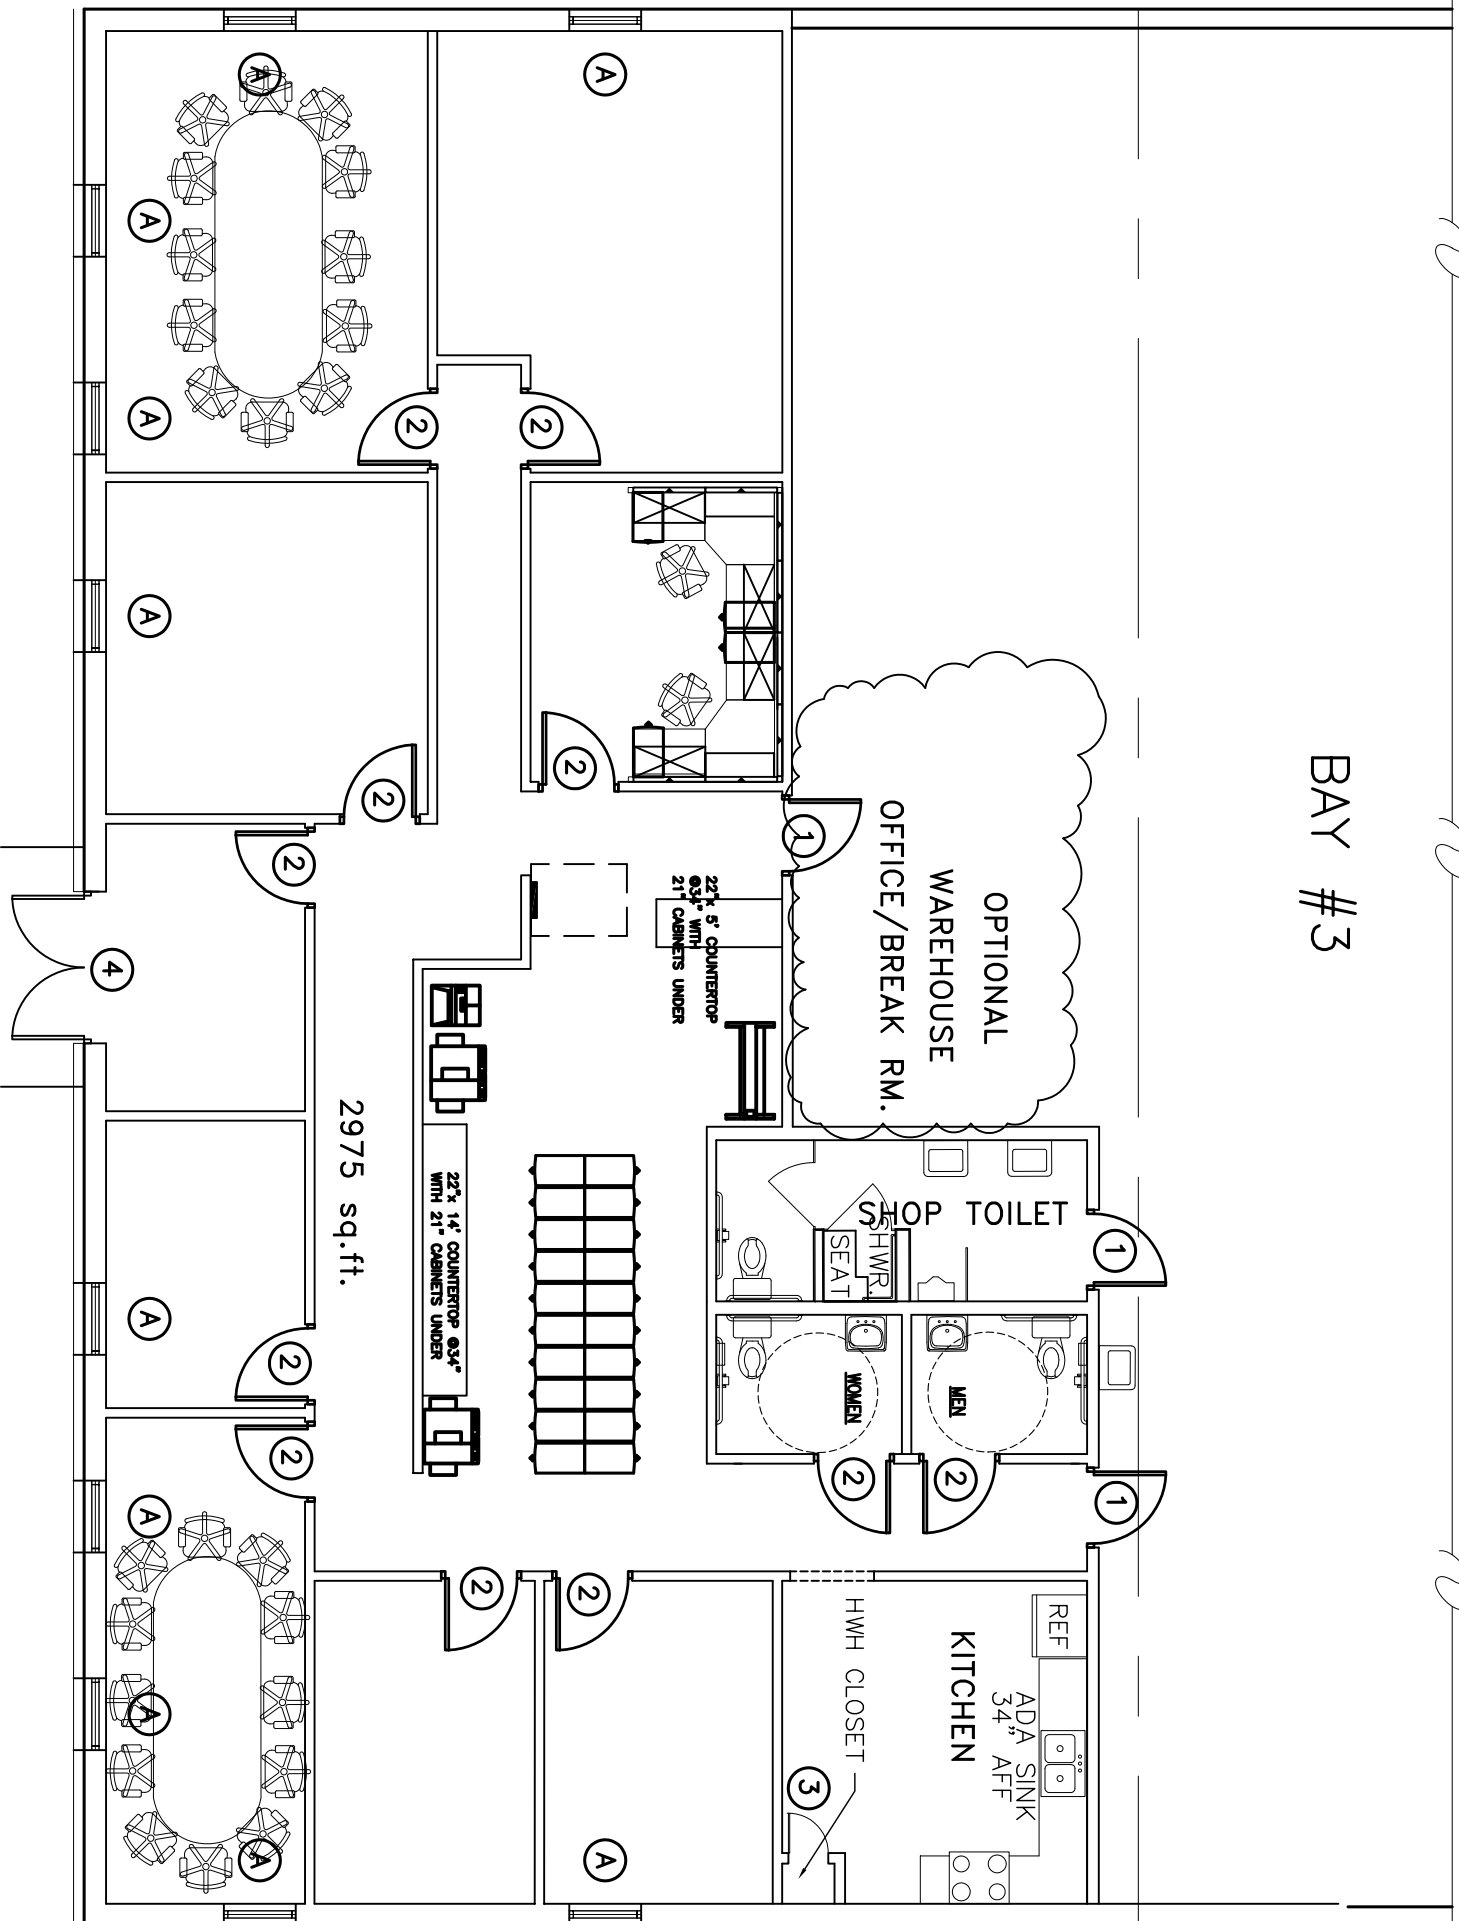

2975 sq.ft.

OPTIONAL
WAREHOUSE
OFFICE/BREAK RM.


SHOP TOILET

REF
ADA SINK
34" AFF
KITCHEN


HWH CLOSET

22' x 5' COUNTERTOP
34" WITH
21" CABINETS UNDER

22' x 14' COUNTERTOP
34" WITH
21" CABINETS UNDER

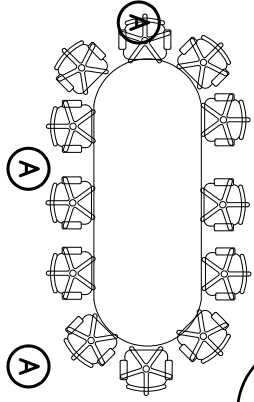

(A)

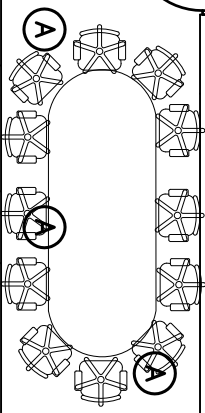

(A)

(A)

(A)

(A)

(A)

(A)

(A)

(A)

(A)

(A)

(K)

(2)

(2)

(2)

(A)

(1)

(1)

(1)

(2)

(2)

(2)

(2)

(3)

(A)

(4)