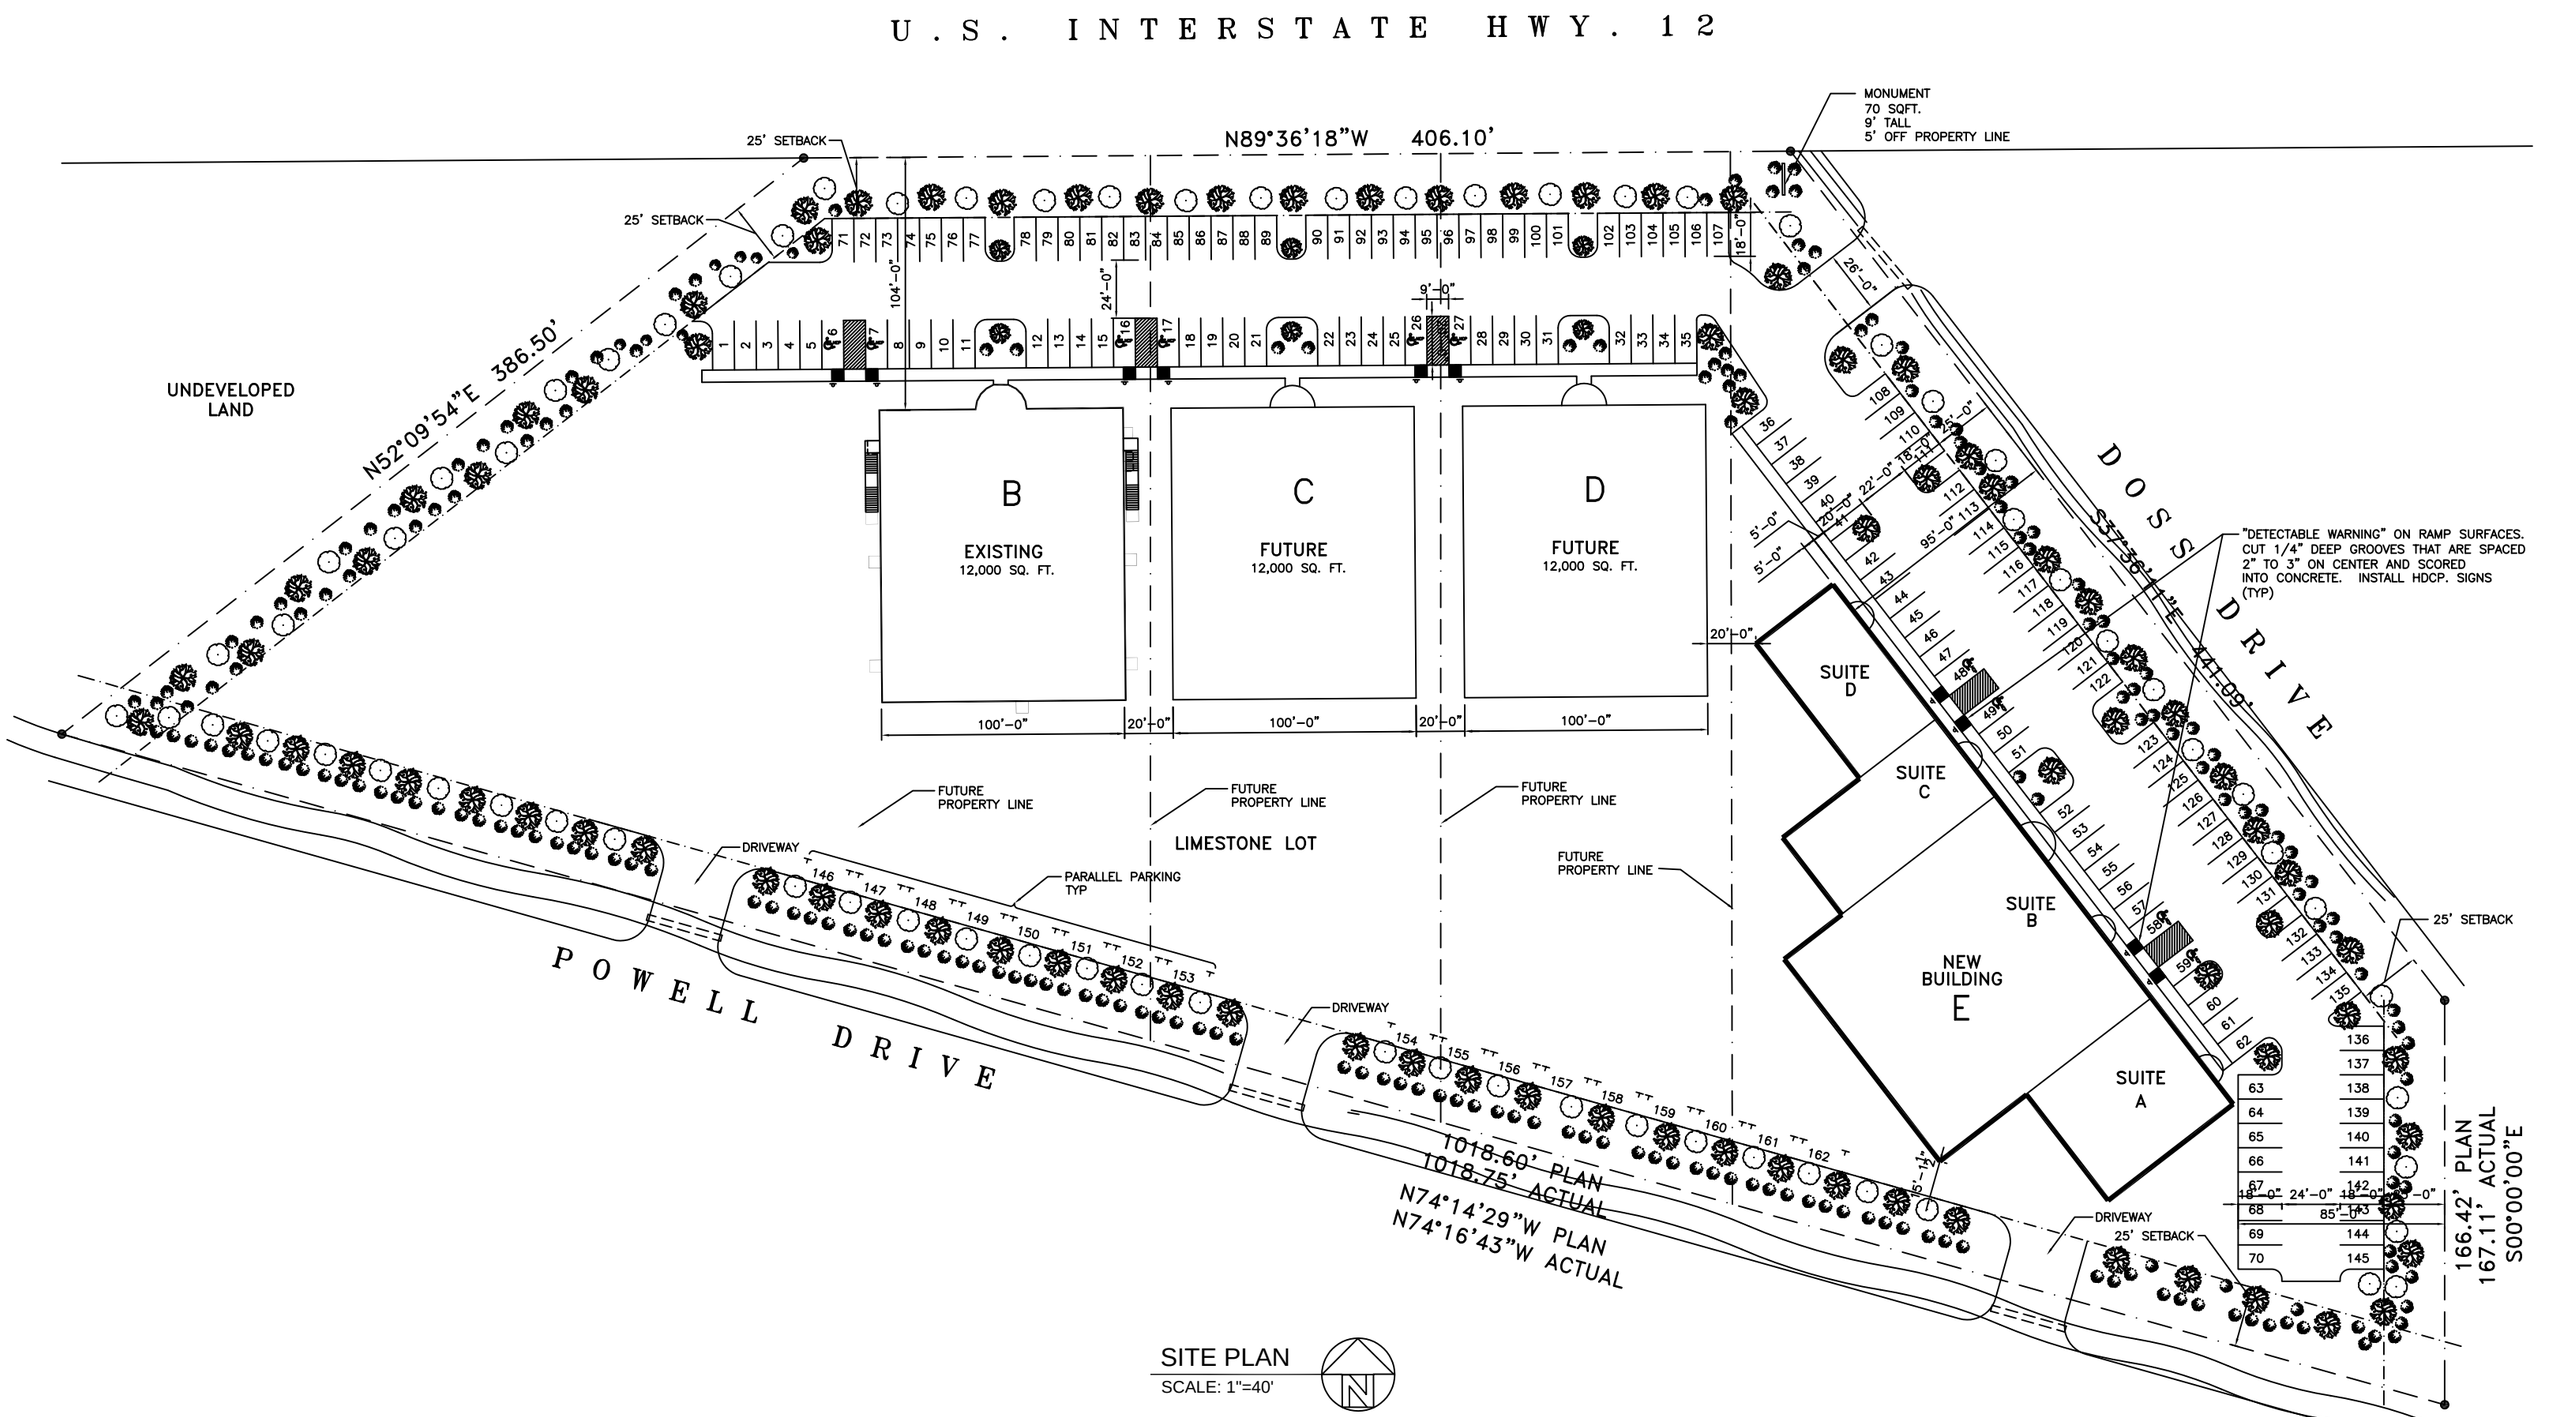

SITE PLAN

SCALE: 1"=40'