



DAMMON
ENGINEERING, INC.
EMMETT
DAMMON

ARCHITECT
ROBERT
WILTSE

1095 FLORIDA AVENUE
SLIDELL, LA. 70458
985-649-5832

WEBSITE:
WWW.DAMMONENGINEERING.COM
EMAIL:
DAMMONENG@BELLSouth.NET

ARCHITECTURE
ENGINEERING
STUDIES
PLANNING
INVESTIGATION
EXPERT WITNESS

NEW OFFICE/
WAREHOUSE

O'BRIEN / NORTH
SHORE FLOORING
DISTRIBUTORS
J.F. SMITH AVE.
SLIDELL, LA

LIGHTING
PLAN

REV: 1-17-08
REV: 2-8-08


SCALE: AS NOTED

JOB#: 1912

DATE: 1-4-08

SHEET

E-2

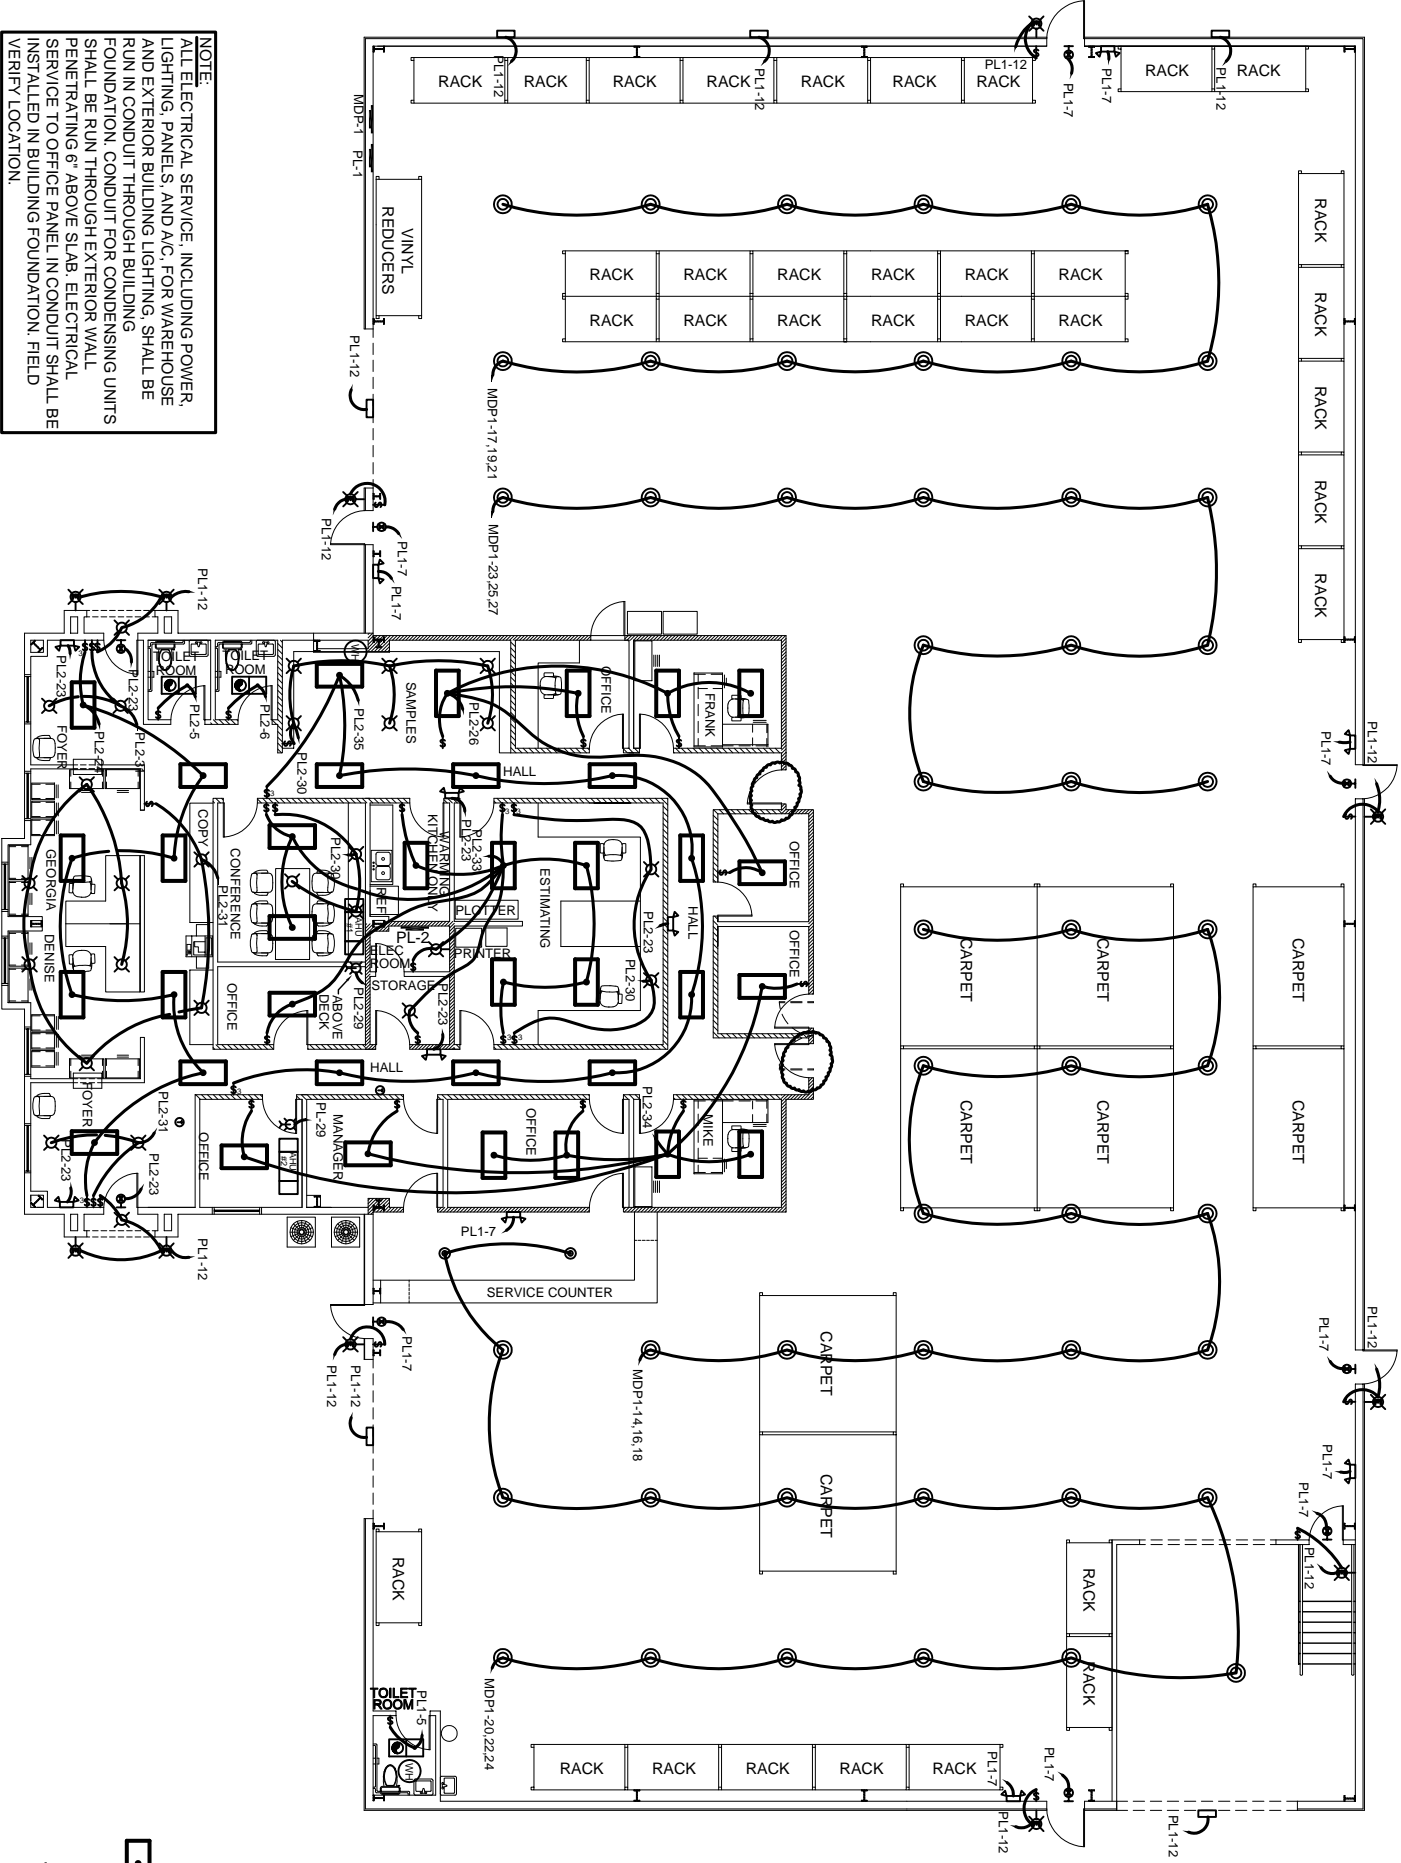

NOTE:
ALL ELECTRICAL SERVICE, INCLUDING POWER, LIGHTING, PANELS, AND A.C. FOR WAREHOUSE AND EXTERIOR BUILDING LIGHTING, SHALL BE RUN IN CONDUIT THROUGH BUILDING FOUNDATION. CONDUIT FOR CONDENSING UNITS SHALL BE RUN THROUGH EXTERIOR WALL PENETRATING 6" ABOVE SLAB. ELECTRICAL SERVICE TO OFFICE PANEL IN CONDUIT SHALL BE INSTALLED IN BUILDING FOUNDATION. FIELD VERIFY LOCATION.

VICK,
PLEASE SEE WALL PACK LIGHTING
ON THIS SHEET. 7-3-08

FOR ELECTRICAL
NOTES SEE E-1



- LEGEND**
- ◻ - 2x4 CEILING MOUNTED FLUORESCENT LAMP, STEEL HOUSING, STYLE BY OWNER
 - ◻ - EMERGENCY LIGHT WITH 90 MIN. BATTERY BACKUP
 - ◻ - DISCONNECT
 - ◻ - POWER PANEL
 - ◻ - SWITCH
 - ◻ - 3-WAY SWITCH
 - ◻ - EXIT LIGHT, 90 MINUTE BATTERY BACKUP
 - ◻ - THERMOSTAT
 - ◻ - HIGH BAY LIGHT, 208V, 360, 400W, STYLE BY OWNER
 - ◻ - LOW BAY LIGHT, 208V, 320, 200W, STYLE BY OWNER
 - ◻ - 20 GAL WATER HEATER
 - ◻ - PULL CHAIN LIGHT
 - ◻ - EXTERIOR WATERPROOF WALL MOUNTED LIGHT, STYLE BY OWNER
 - ◻ - INTERIOR WALL MOUNTED LIGHT, STYLE BY OWNER
 - ◻ - CEILING MOUNTED LIGHT, STYLE BY OWNER
 - ◻ - VENT/LIGHT
 - ◻ - WALL PACK, STYLE BY OWNER