


FLOOR PLAN

W-14-0

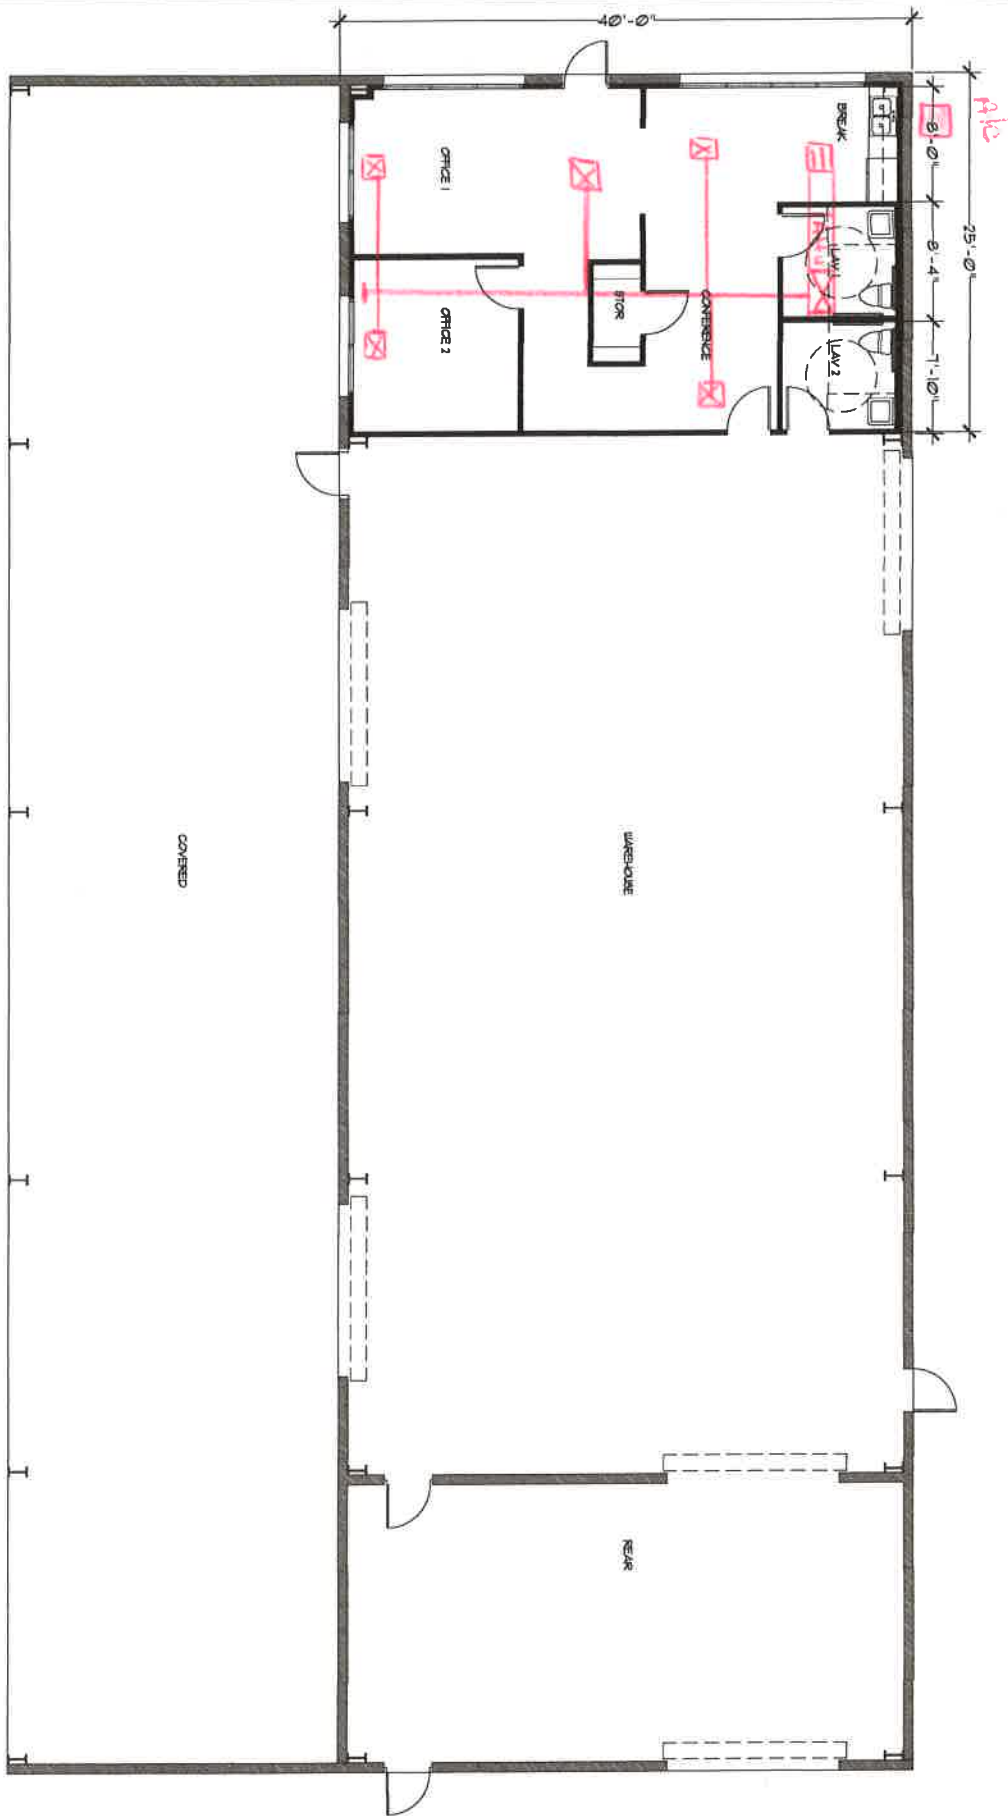

A2

04/10/19

A Buildout for
Surgi Investments, LLC
Slidell, Louisiana



James R. Anltman, AIA
An Architectural Corporation
Architecture
Landscape Architecture
223 West 19th Avenue
Covington, Louisiana 70433