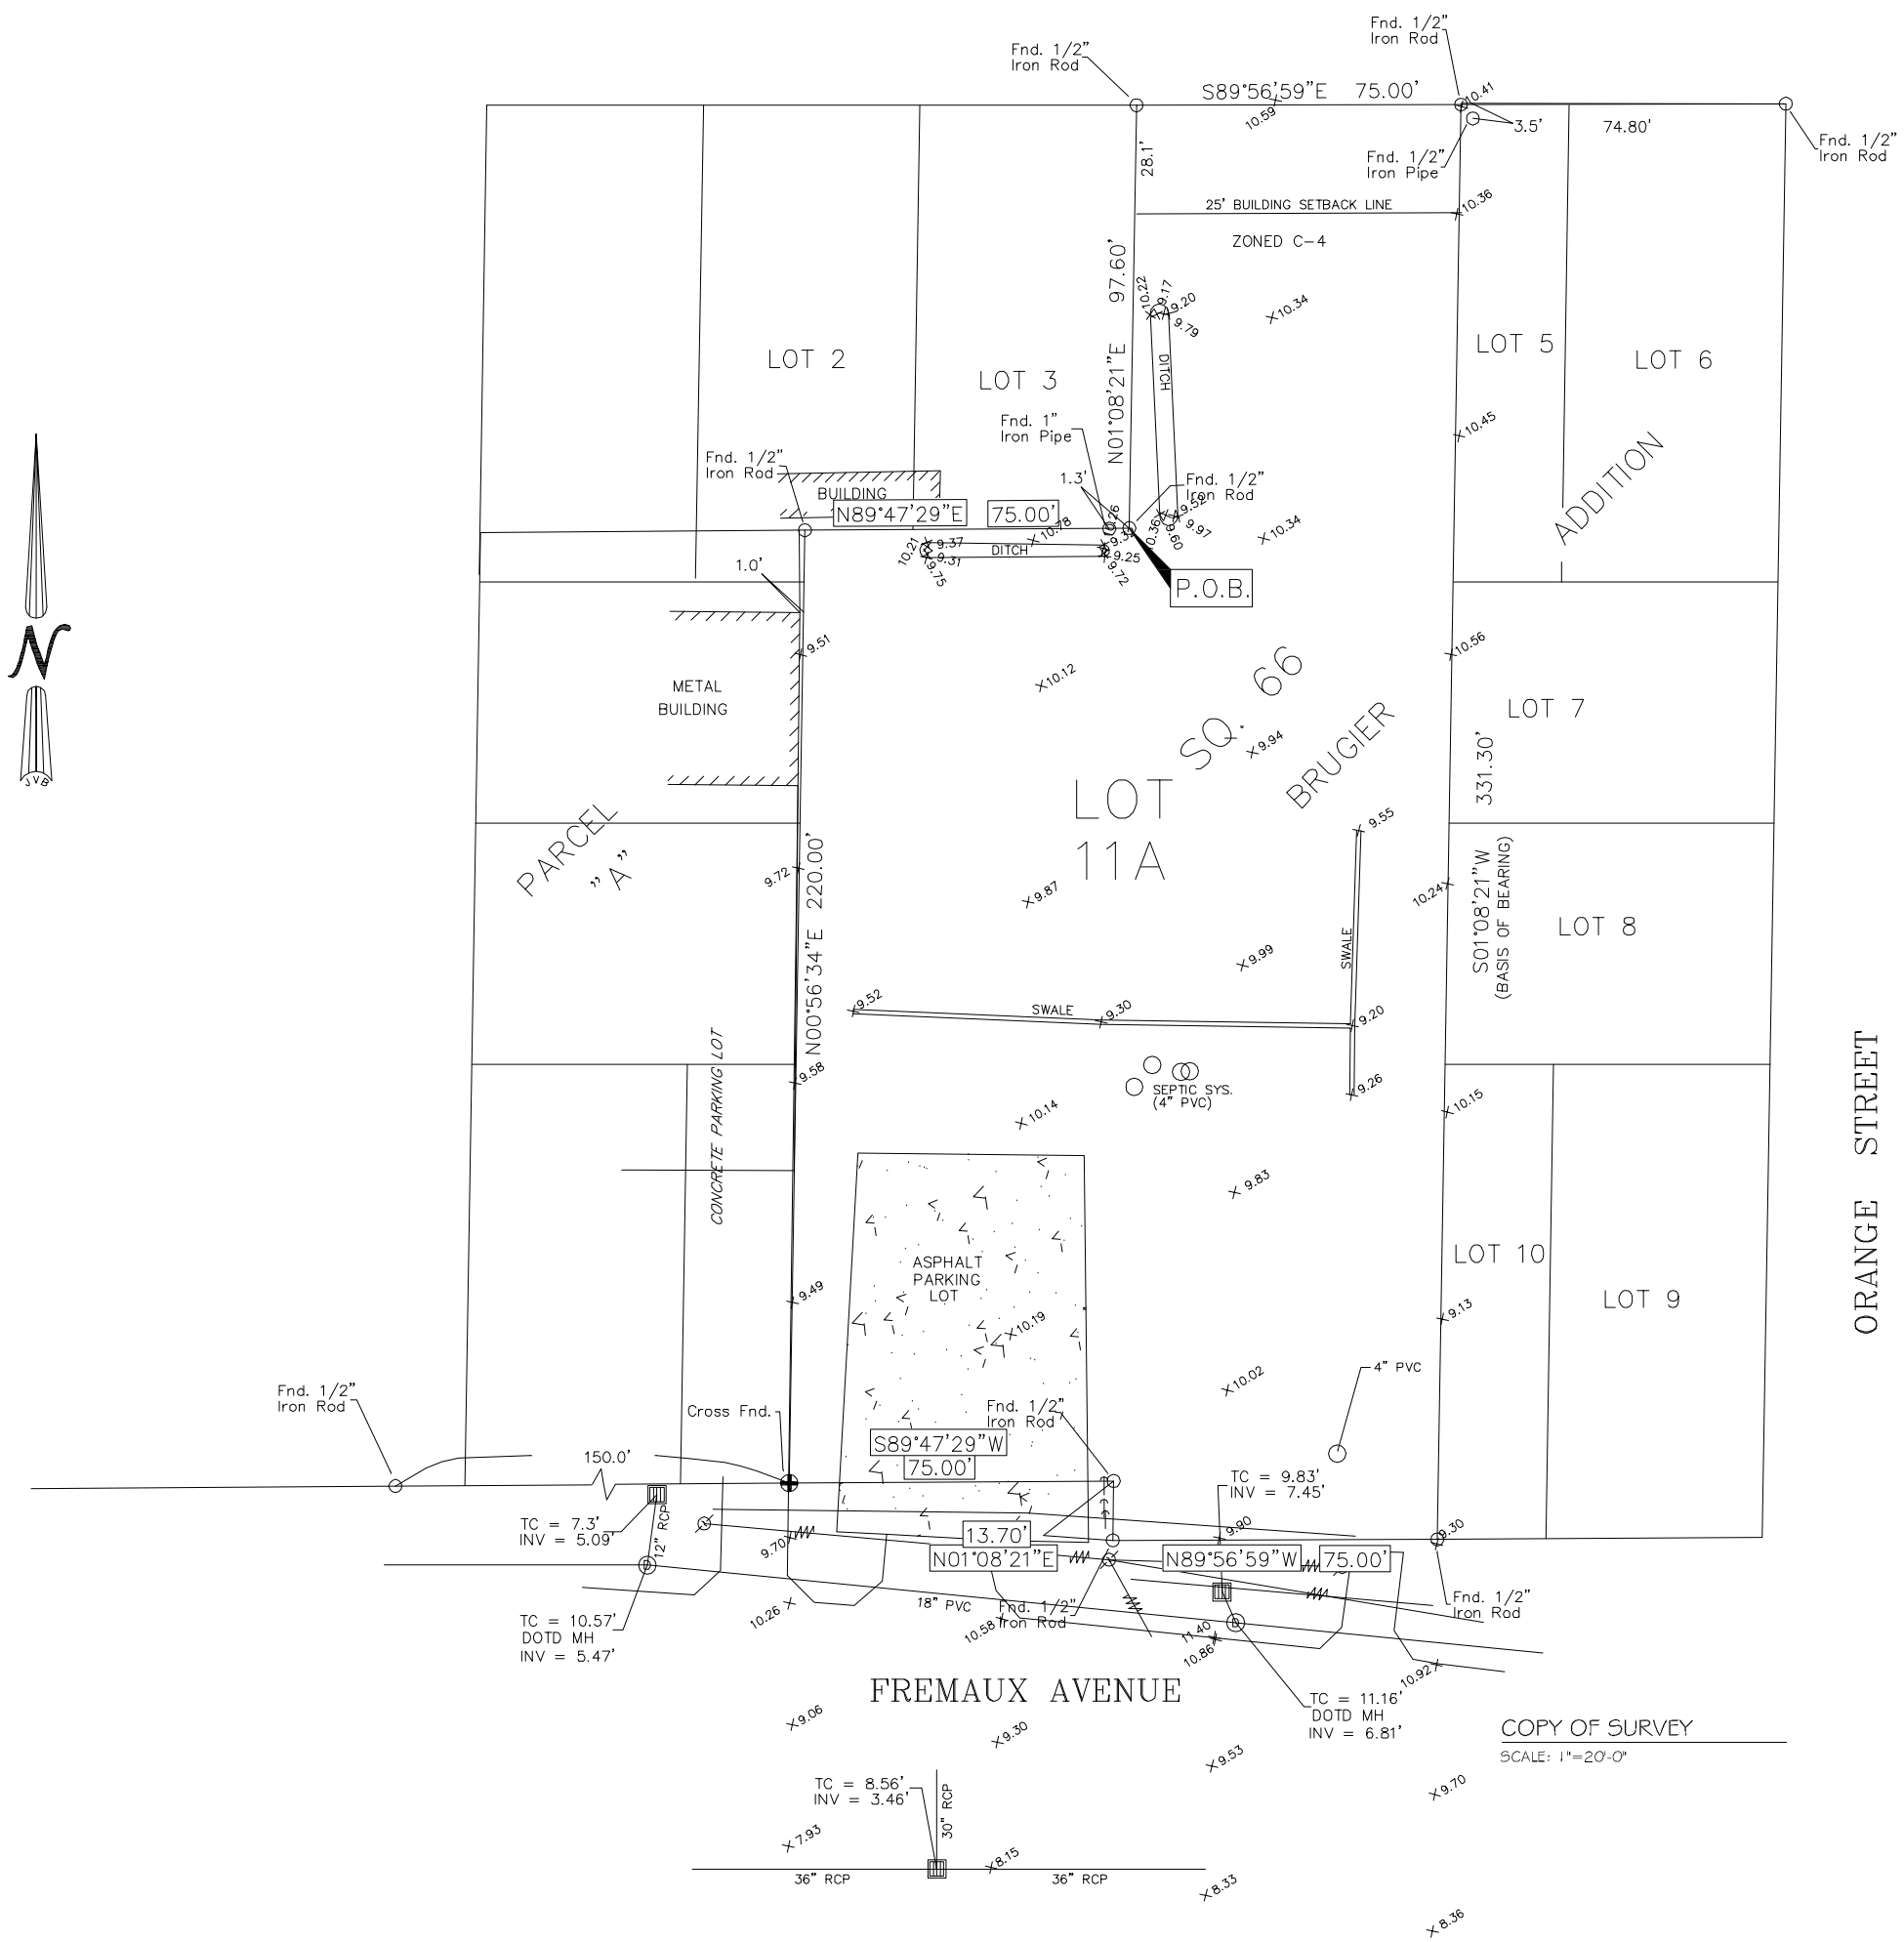

COPY OF SURVEY

SCALE: 1"=20'-0"

DAMMON ENGINEERING, INC.
Architects & Engineers

damminengineering.com
dammon@bellsouth.net
PHONE: 985-649-5932
FAX: 985-641-5950

CHIEF ENGINEER: EMMETT DAMMON, P.E.
CHIEF ARCHITECT: DAVIN KINCHEN
554 OLD SPANISH TRAIL
SLIDELL, LA 70450

BULK SYSTEMS NEW OFFICE/WAREHOUSE BUILDING

1.22 G FREMEAUX AVENUE
SLIDELL, LOUISIANA 70458

JOB No: 2173 | DATE: 04-18-2013

DRAWN BY: JTL | CHECKED BY:

#	DESCRIPTION	REVISIONS	DATE

COPY OF SURVEY

SHEET No: 2 OF 20

C1