


ENDWALL C

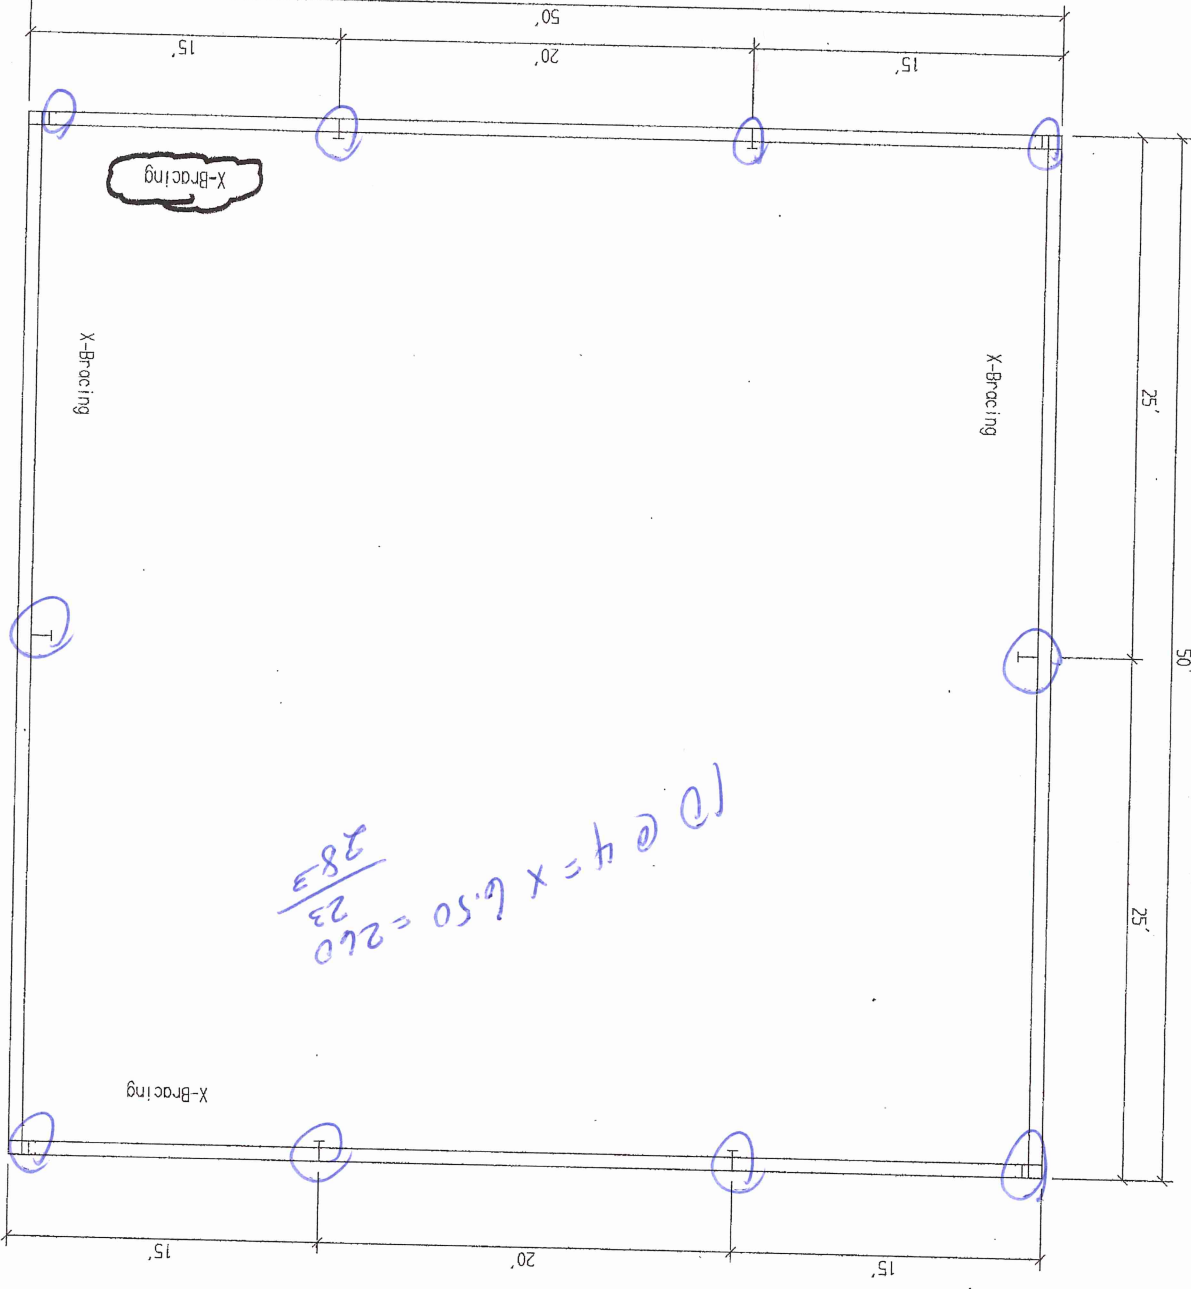


TOP VIEW

QUESTWARE CORP.

JOB NO: VAL077

PAGE:

5 OF 7