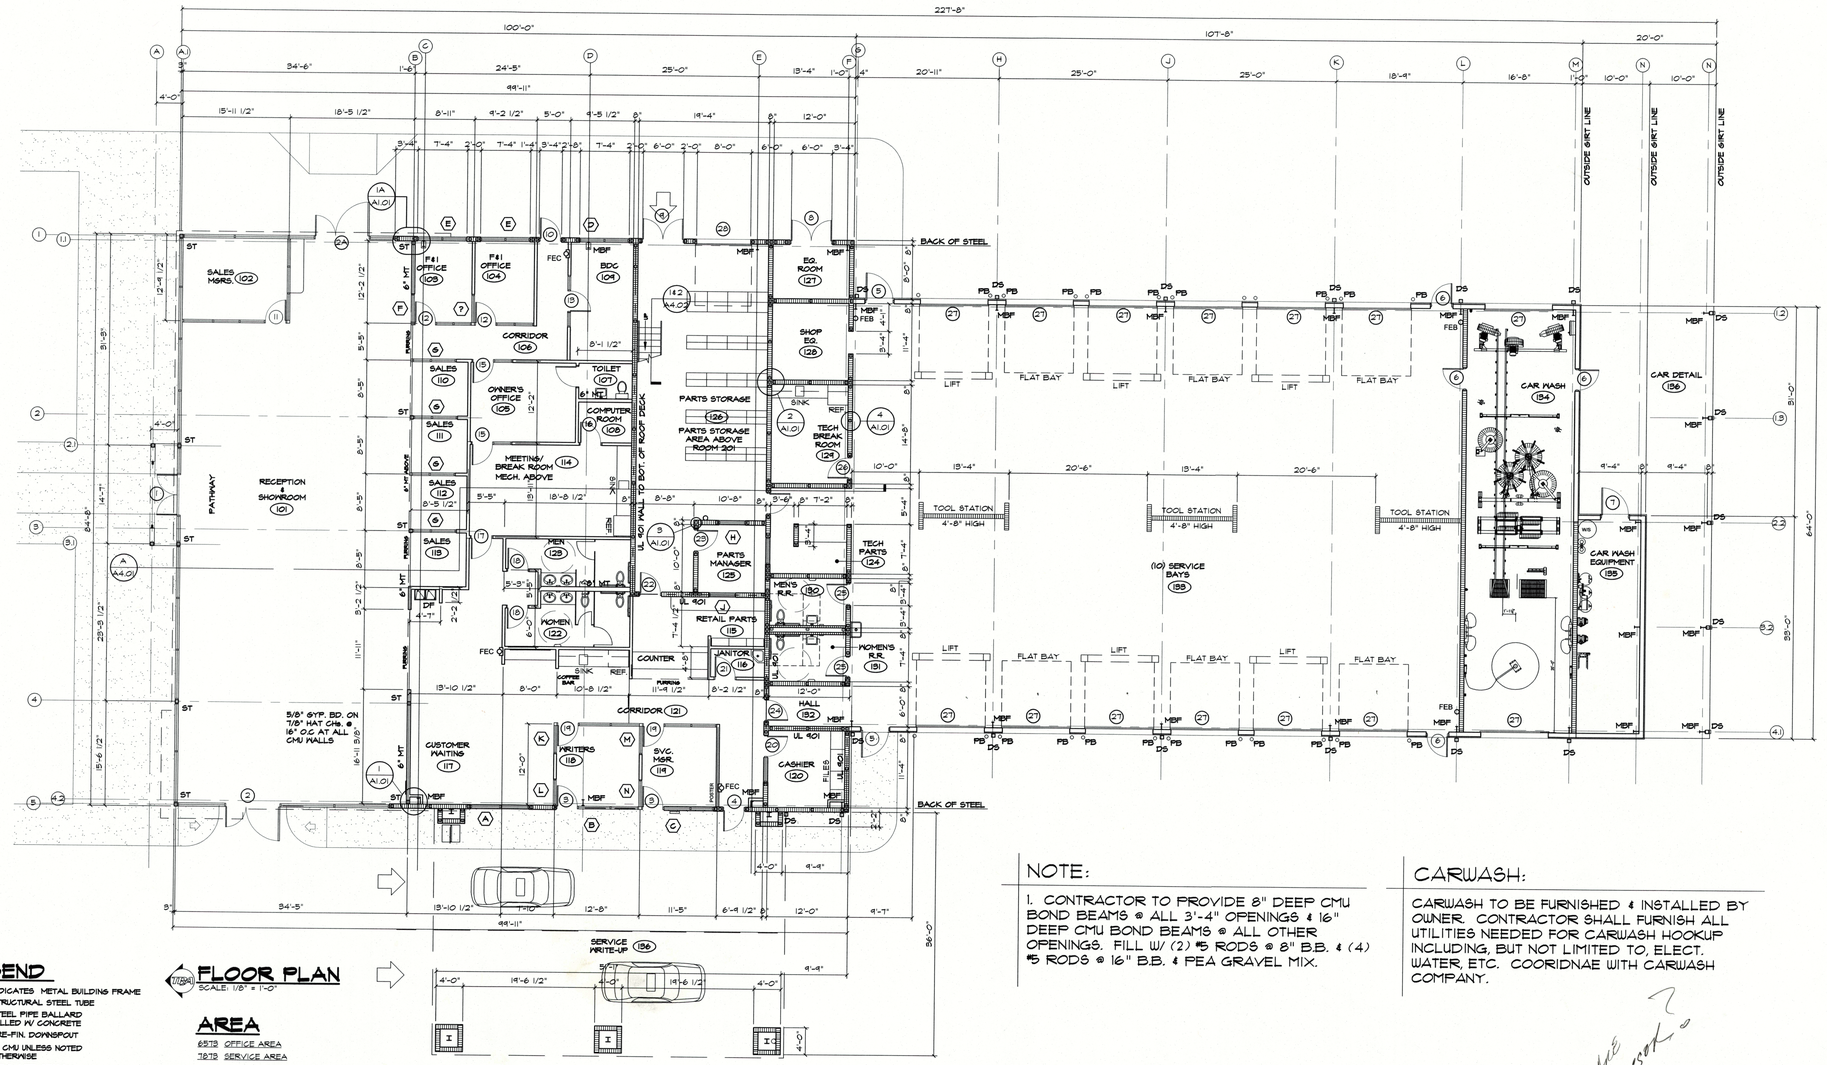

LEGEND

MBF — INDICATES METAL BUILDING FRAME
ST — STRUCTURAL STEEL TUBE
FB — STEEL PIPE BALLARD FILLED W/ CONCRETE
DS — PRE-FIN. DOWNSPOUT
8" CMU UNLESS NOTED OTHERWISE
5 5/8" MET. STUDS @ 16" O.C. UNLESS NOTED OTHERWISE.

FLOOR PLAN

SCALE: 1/8" = 1'-0"

AREA

6573 OFFICE AREA
7873 SERVICE AREA
14,446 TOTAL AREA

NOTE:

1. CONTRACTOR TO PROVIDE 8" DEEP CMU BOND BEAMS @ ALL 3'-4" OPENINGS & 16" DEEP CMU BOND BEAMS @ ALL OTHER OPENINGS. FILL W/ (2) #5 RODS @ 8" B.B. & (4) #5 RODS @ 16" B.B. & PEA GRAVEL MIX.

CARWASH:

CARWASH TO BE FURNISHED & INSTALLED BY OWNER. CONTRACTOR SHALL FURNISH ALL UTILITIES NEEDED FOR CARWASH HOOKUP INCLUDING, BUT NOT LIMITED TO, ELECT. WATER, ETC. COORIDNAE WITH CARWASH COMPANY.

Where are downspouts?

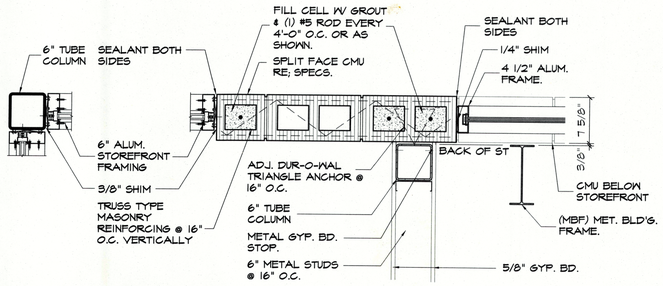

1A TYP. DETAIL

SCALE: 1" = 1'-0"

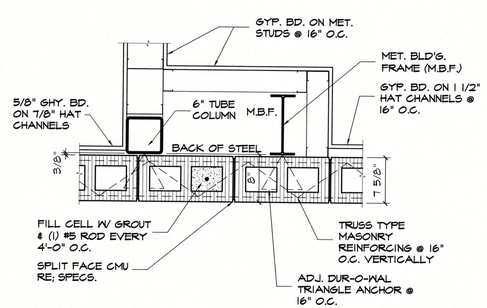

1 TYP. FURRING @ M.B.F.

SCALE: 1" = 1'-0"

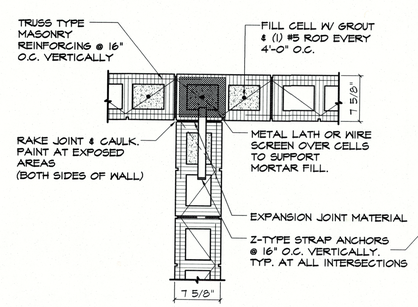

2 TYP. 8" CMU INTERSECTION

SCALE: 1" = 1'-0"

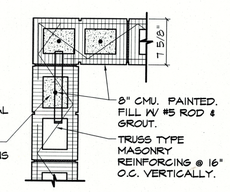

3 TYP. 8" CMU CORNER

SCALE: 1" = 1'-0"

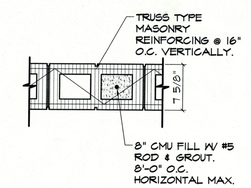

4 TYPICAL FILLED CELL

SCALE: 1" = 1'-0"

TBA
109 Cypress Street
West Monroe, Louisiana 71291
Tel. 318.340.1550
Fax. 318.998.1315
www.tbastudiolaarchitecture.com

NOT FOR CONSTRUCTION
WILLIAM M. BRAMLETT #5722
STATE OF LOUISIANA
REGISTERED ARCHITECT

PROJECT:

INTERSTATE HYUNDAI

CONSTITUTION DRIVE, WEST MONROE, LOUISIANA

DRAWING REVISIONS	
DATE	DESCRIPTION

Drawn By: TDD
Checked By: TMB

SHEET

A1.01

Date: MAY 2013
Project No.: 12-0013
File Name:

DESCRIPTION:

FLOOR PLAN

"COPYRIGHT" THESE DRAWINGS ARE THE SOLE OWNERSHIP OF TBA STUDIO.