

**DAMMON ENGINEERING, INC.**

CHIEF ENGINEER  
EMMETT  
DAMMON, P.E.

CHIEF ARCHITECT  
ROBERT  
WILTSE

554 OLD SPANISH TRAIL  
SLIDELL, LA. 70458  
OFFICE: 985-649-5832  
FAX: 985-641-5950

WEBSITE:  
WWW.DAMMONENGINEERING.COM

EMAIL:  
DAMMONENG@BELLSOUTH.NET

- ARCHITECTURE
- ENGINEERING
- STUDIES
- PLANNING
- INVESTIGATION
- EXPERT WITNESS

VESSEL  
PROPERTIES  
384 VOTERS RD.  
SLIDELL, LA

SITE  
PLAN

*Robert Wiltse*

REV:

SCALE: AS NOTED


JOB#: 2122

DATE: 09-23-11

SHEET 2

C-1

OF 6

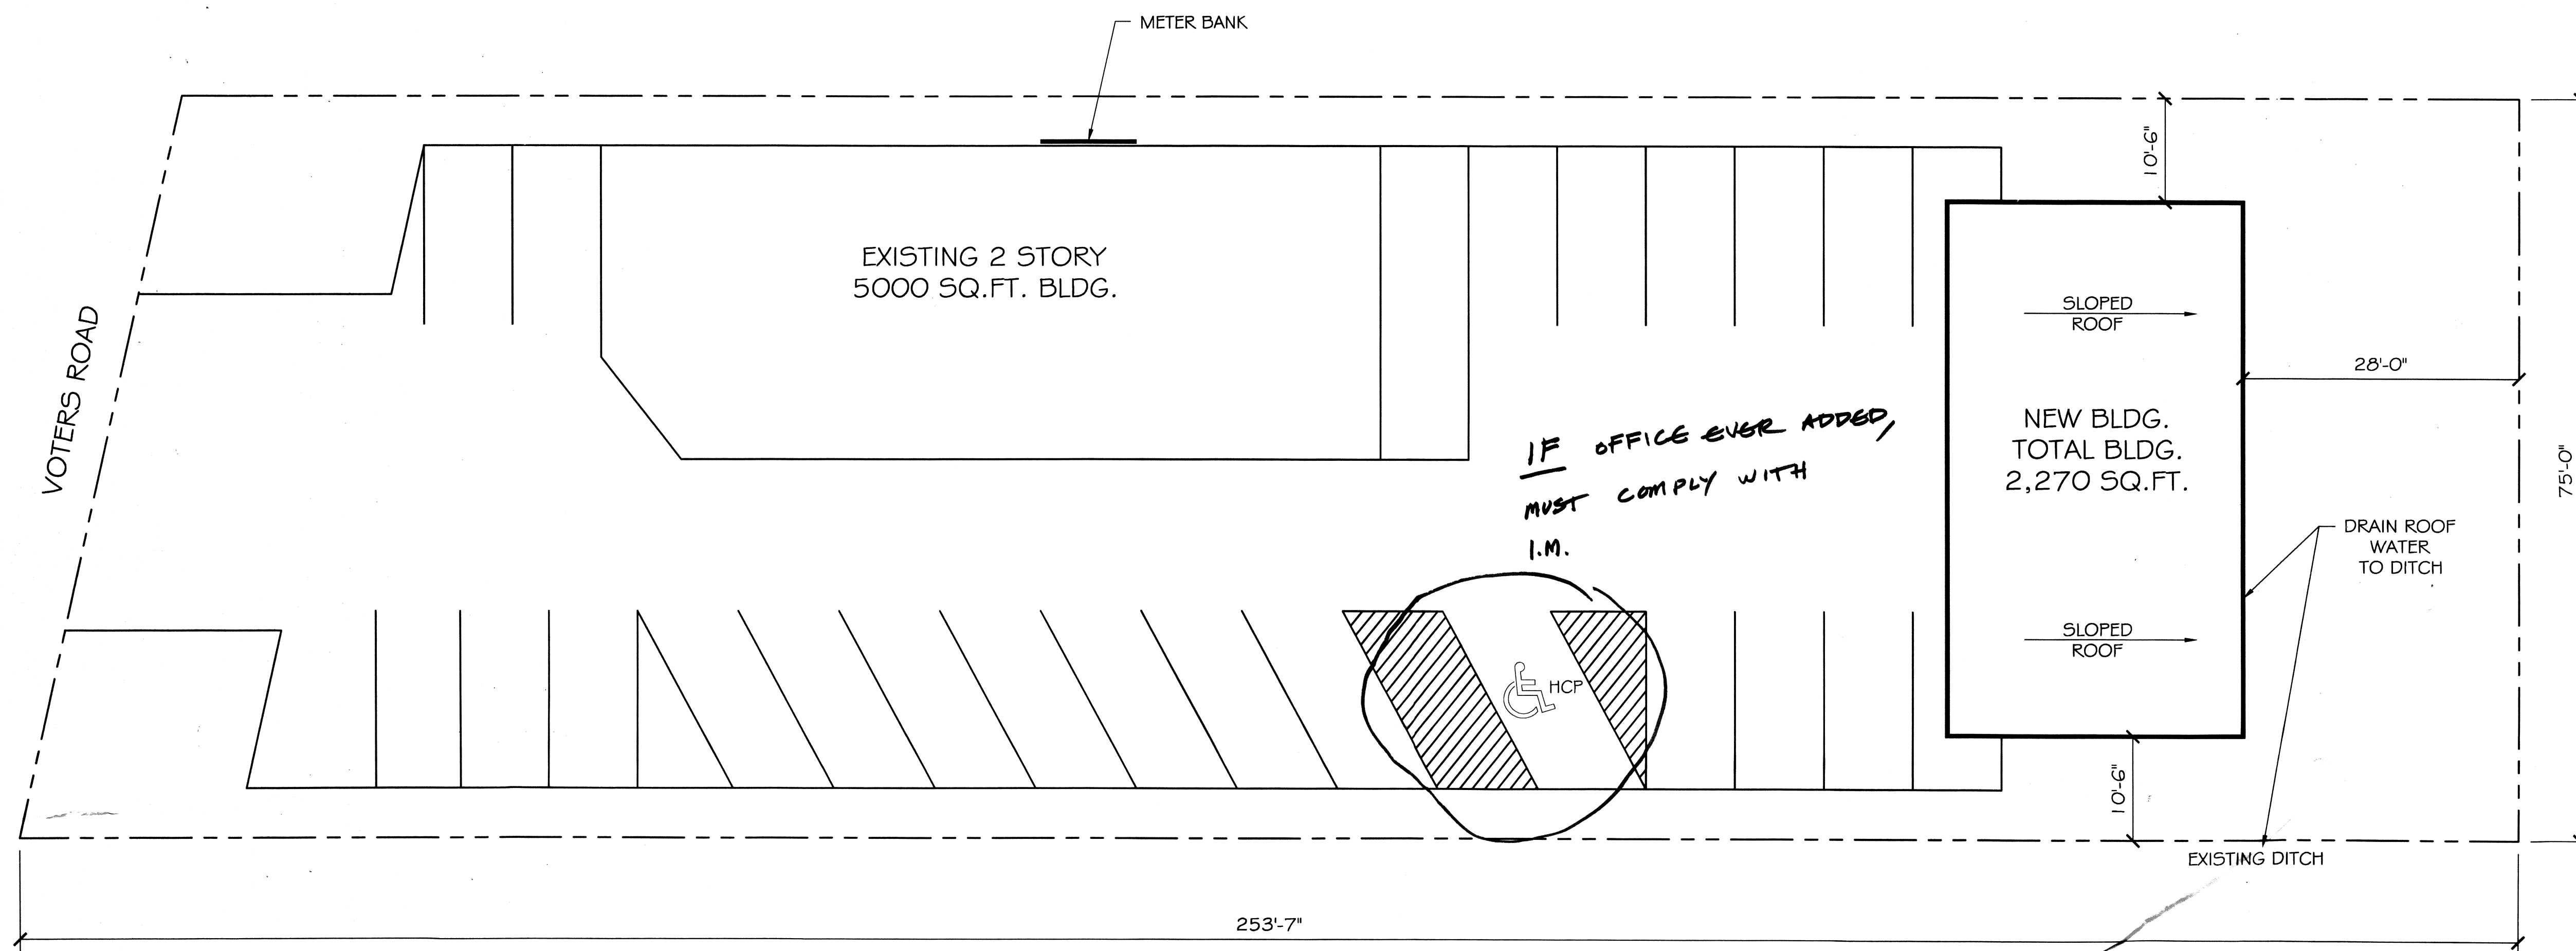

SITE PLAN  
SCALE: 1"=10'

**SITE LEGEND**

- PROPERTY LINE
- BUILDING OUTLINE

#0404882  
 REVIEWED FOR  
 STATE FIRE MARSHAL  
 AS PER REVIEW LETTER  
 BY: F. MICHAEL BABINEAUX  
*F. Michael Babineaux*