


Fax
 985-863-0460

General
 4'8" hall width enough?
 glass walls?
 Mechanicals?
 A/C
 TV
 lights
 phone
 - who specs materials?
 15 3000 sq ft

flipsets?

long table
 in "conference" room

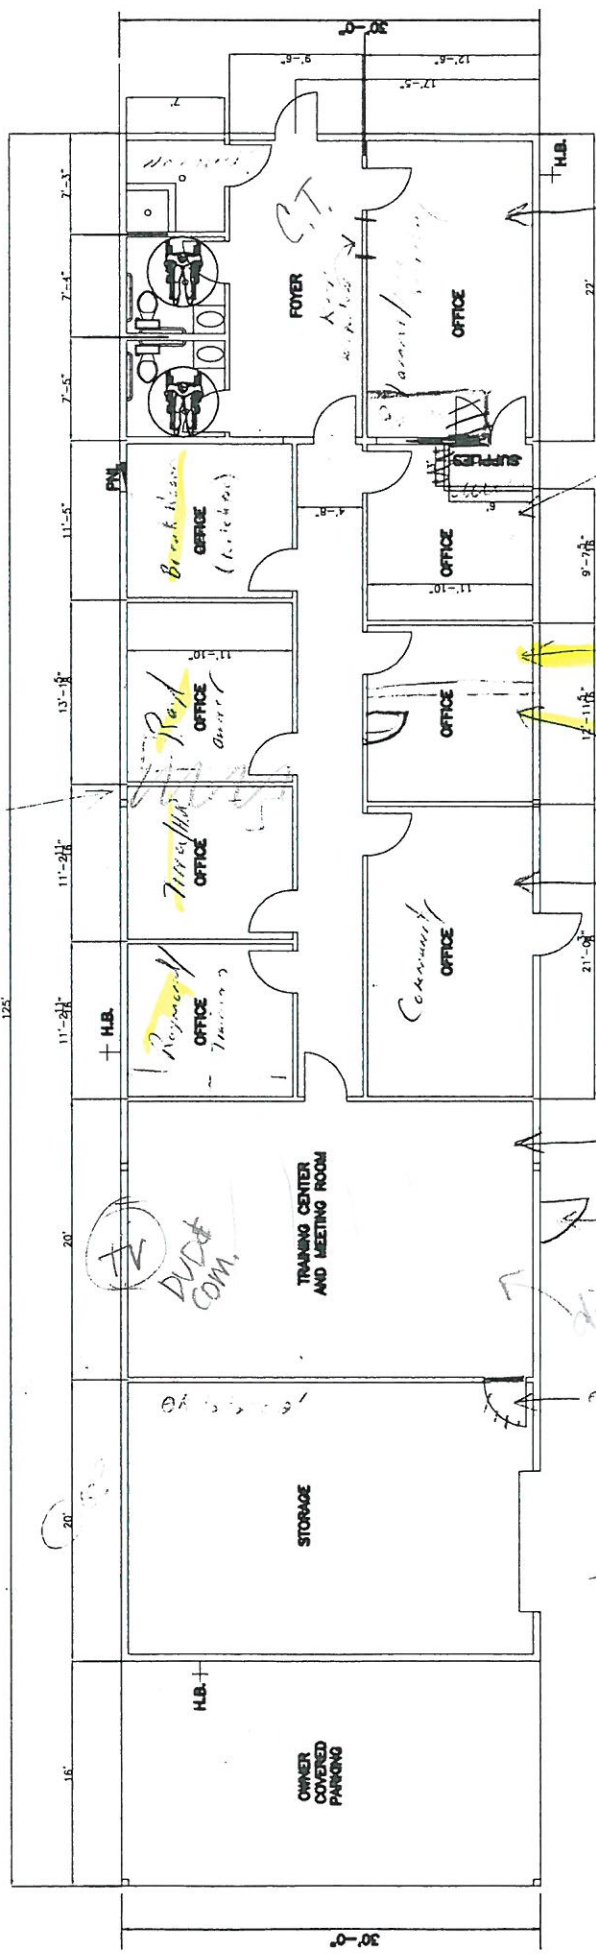

- Nursery
- Linen room
- Coat closet
- Storage

Reception, paper office
 - 2 people / 2 computer desks
 - main phone
 (- cop, reception f...?)

File, Mail Room:
 - (12) 18" file cabinets of in 4 rows
 - copy machine
 - middle "prep" table

Nursery/End Crub

Acct/Bookkeeping (Trainer)
 - computer desk
 - () file cabinets

Community
 - Robert, Reel, Training

FLOOR PLAN

Training Room:
 - Storage? walls or cabinets?
 - table layout + counter?
 - Screen/T.V.
 - lights to drain

dim light

9' ceiling
 2x2 lights
 C.T.
 Transom
 1' x 6'
 or 2' x 6'