


Ray
Masker

2.19.08

- o Rentention question.
- o rateable ext. wall ?
- ✓ o how much parking ^{9 sp. Total}
- ✓ o question dimensions (exist.)
- o met. stud framing
- o open office plan ?
- eliminate offset wall
- ✓ o Community Office - 4 workers
- ✓ o Need more storage / supplies

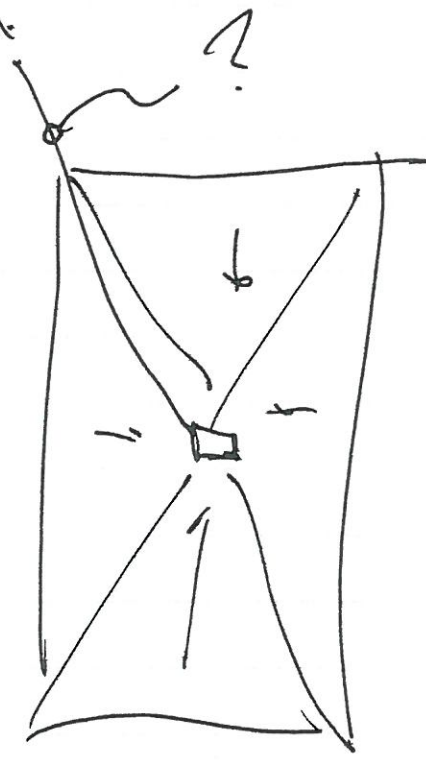

- o attic storage ?
- o verify mech. in attic 30
- o more copier
- o 10' clg. ht.
- o more attractive front door
- o GIS review

23
30
690
700
20 #
\$15,000 ²⁰

Maska

- C-1 - missing side walk to side drive
- C-1 - note: all is existing; no new work except @ new side door
- C-1 - missing end wall columns @ rear wall
- A-1 - mis labeled @ as new floor plan / demo plan
- A-1 - question ^{PCS} sums is \$
- A-2 - question ^{elec} panel over counter
- A-2 - note: Furniture N.I.C.
- A-2 - dr. ^{is} under. Sched. & symbols
- A-2 - schedules sketchy
- A-2 - Room name? lower r.h. corner
- A-2 - confused dim. @ closets
- E-1 - ∇ outlets
- E-1 - ATTU's need ϕ + lite - *Already EXIST. ^{Kirt said not to mess with.}*
- M-1 - see bldg sect. ----- @ ATTU detail
- M-1 - warehouse ventilation
- M-1 - air to coat closet
- M-1 - ATTU's existing?
- A-2 - reverse ^{door} swing @ training / warehouse
- A-2 - Toil Rm - why is door so far from corner
- A-2 - Mail Rm. - table / dr. conflict
- A-2 - Int. Door side splits - watch glass size
- A-2 - don't have 18" @ exist dr - Comm. Off.
- A-2 - Aecting - too small behind desk - 36" min.
- A-2 - ~~bad dimension in Owner~~
- ◦ A-2 - Warning Kitchen - question layout
Front Door - side light & transom?

*nick said
cave alone - ?*