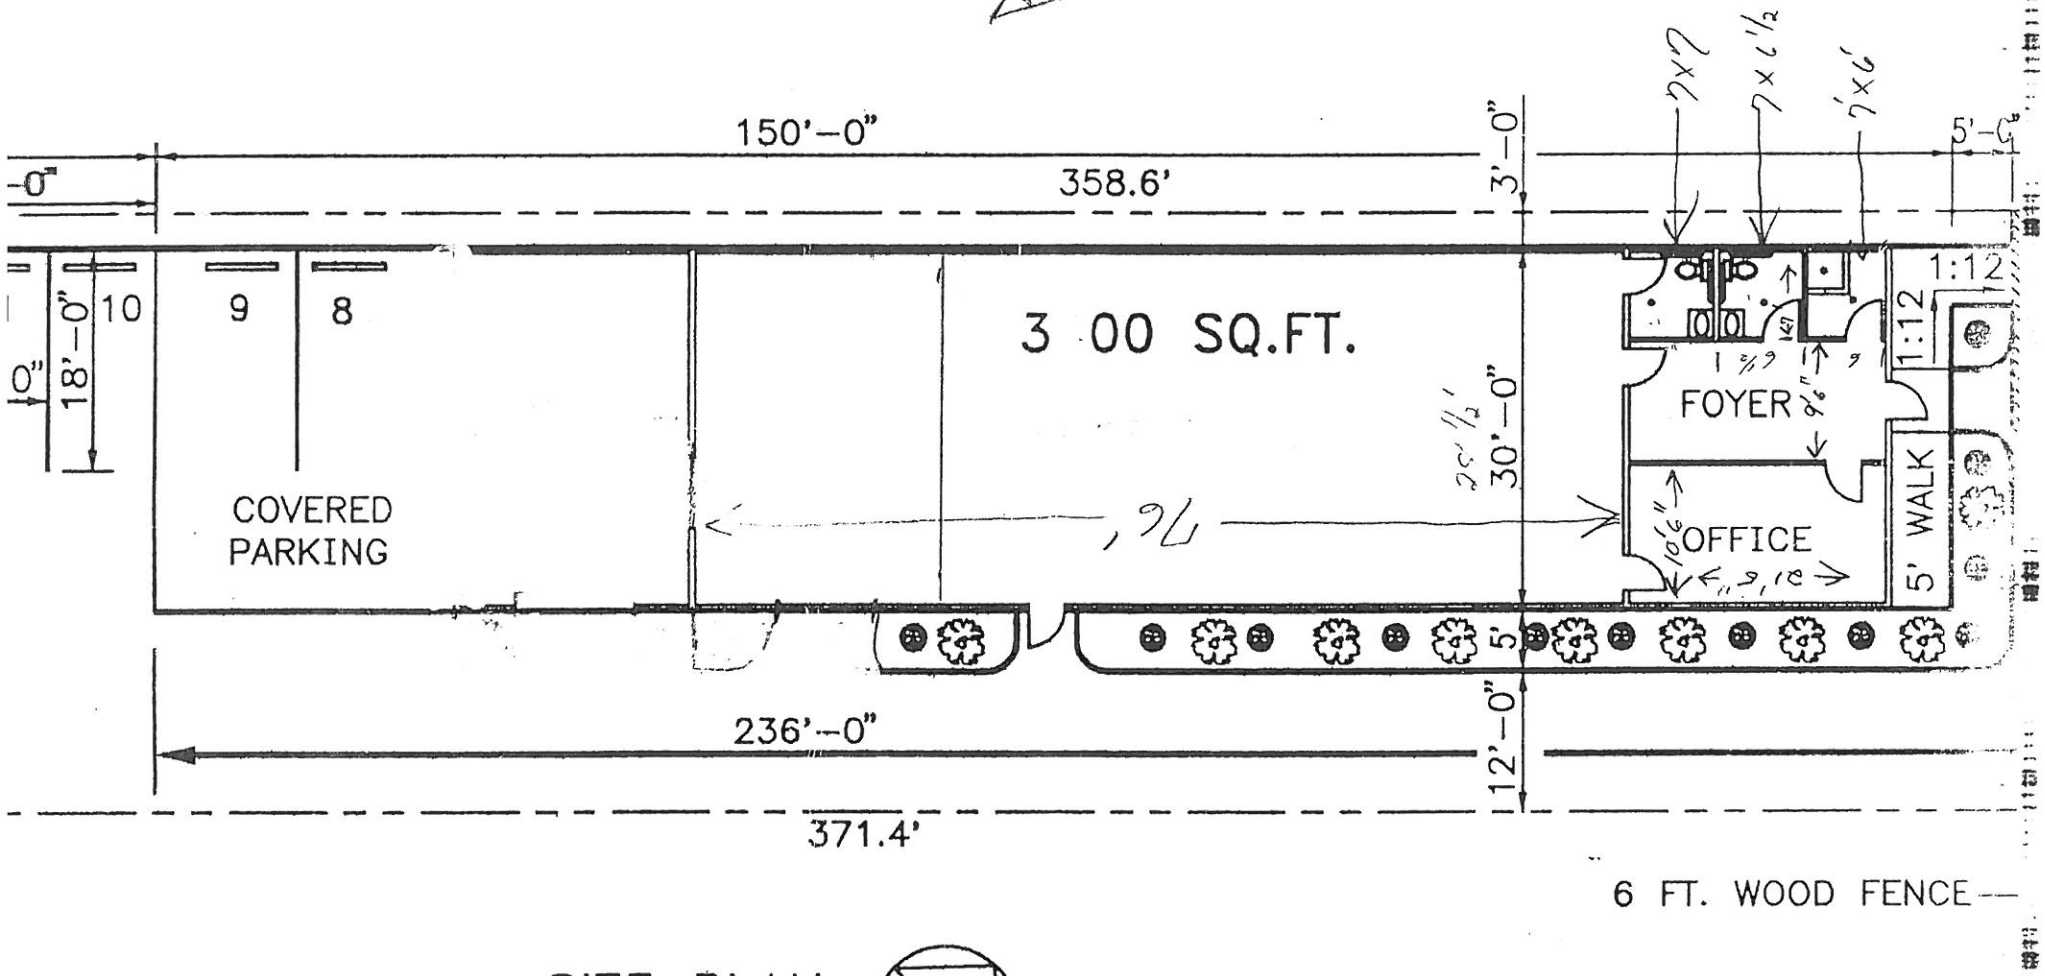

SITE PLAN
SCALE: 1/16"=1'-0"