


W 406.10'

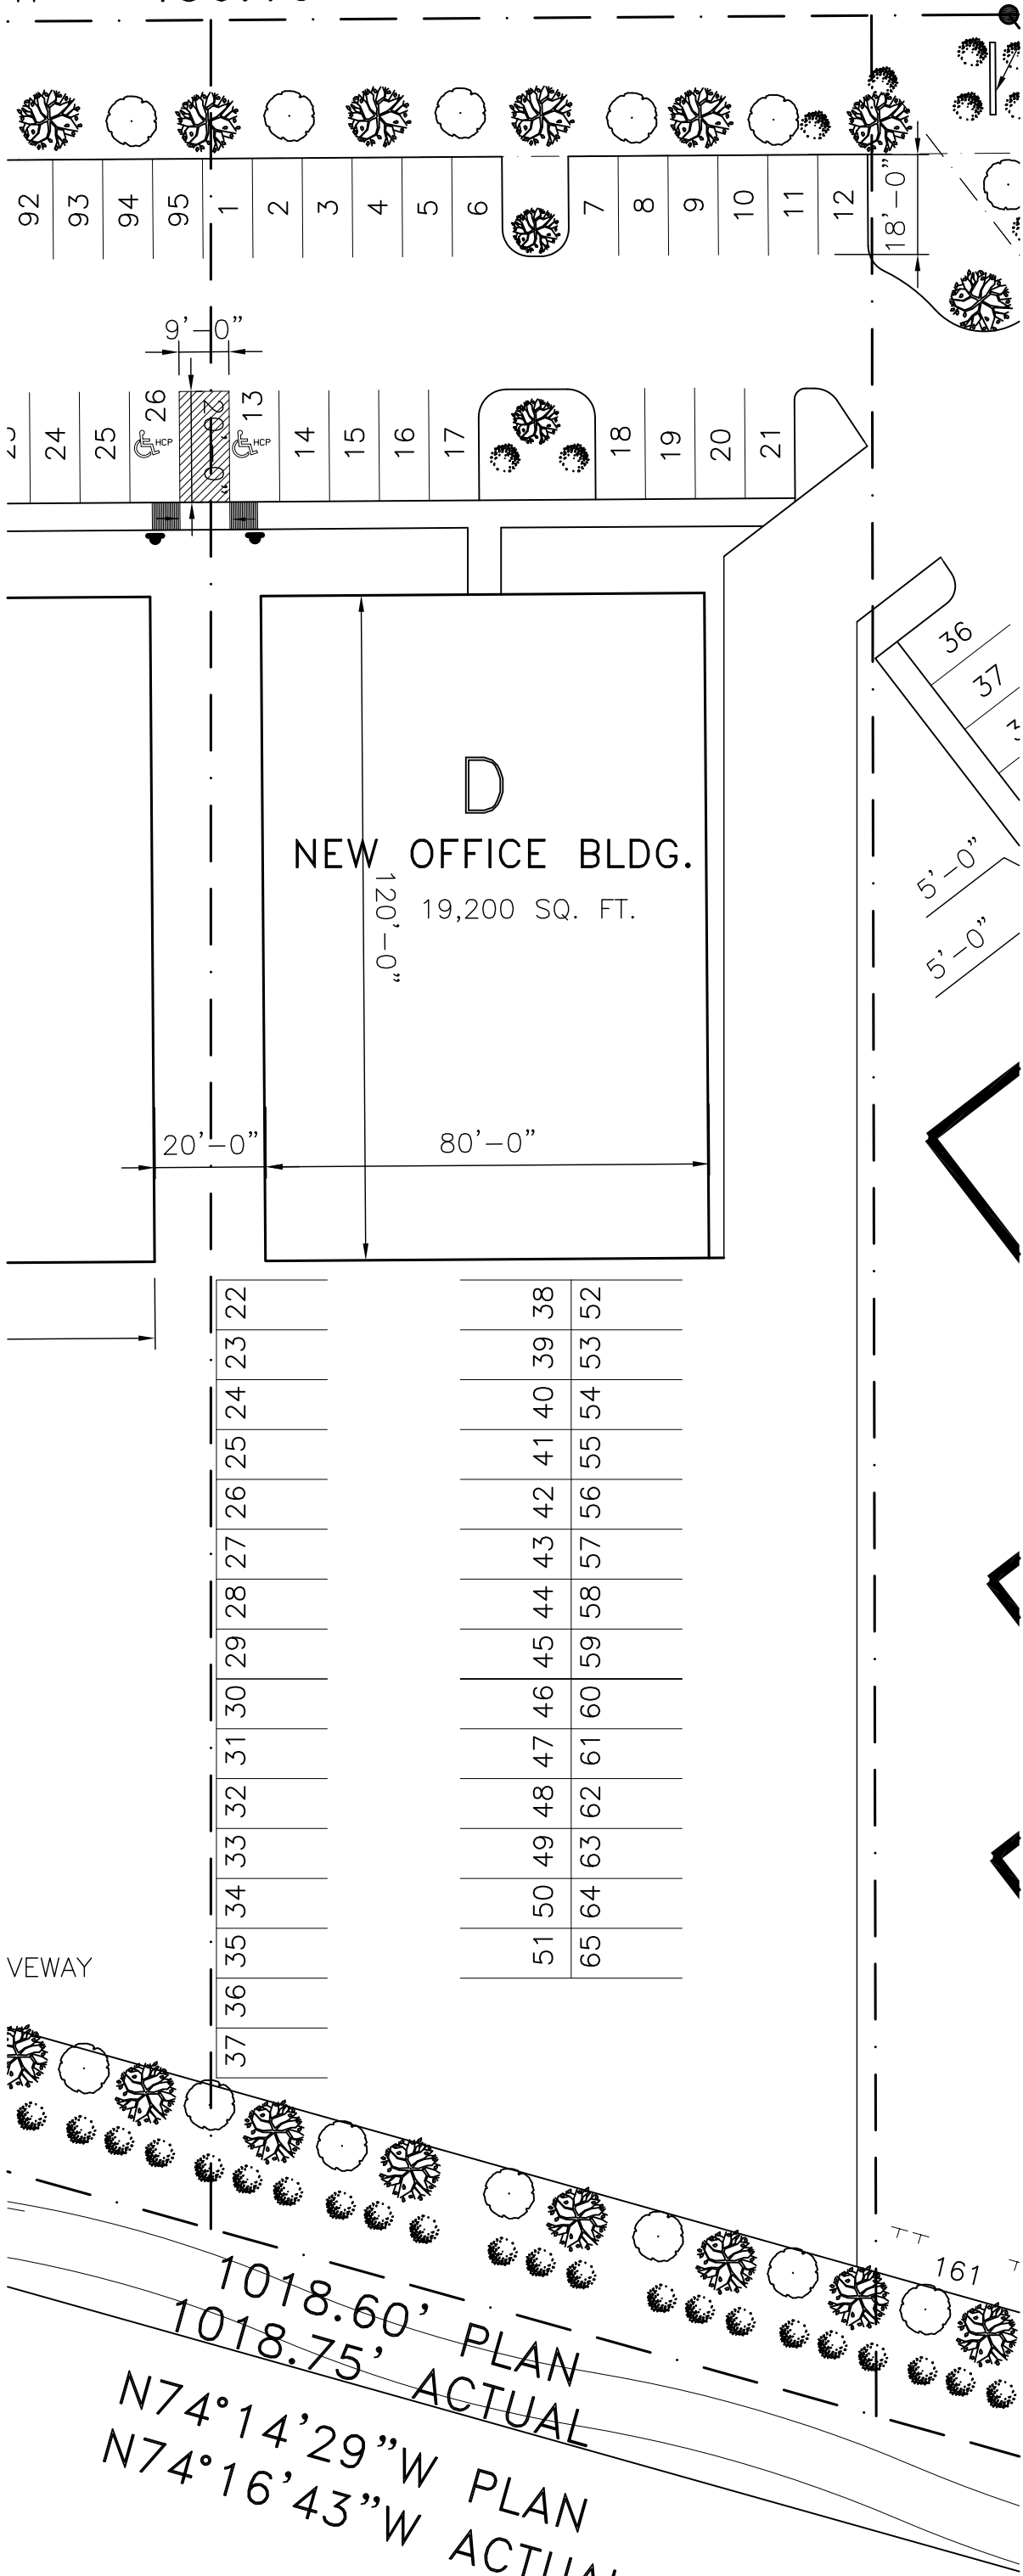

D
 NEW OFFICE BLDG.
 19,200 SQ. FT.

22	23	24	25	26	27	28	29	30	31	32	33	34	35	36	37	38	39	40	41	42	43	44	45	46	47	48	49	50	51

VEWAY

1018.60' PLAN
 1018.75' ACTUAL
 N74°14'29"W PLAN
 N74°16'43"W ACTUAL

