


FORTH STREET (SIDE)

FIFTH STREET

1/ 2" ROD SET ON OFFSET

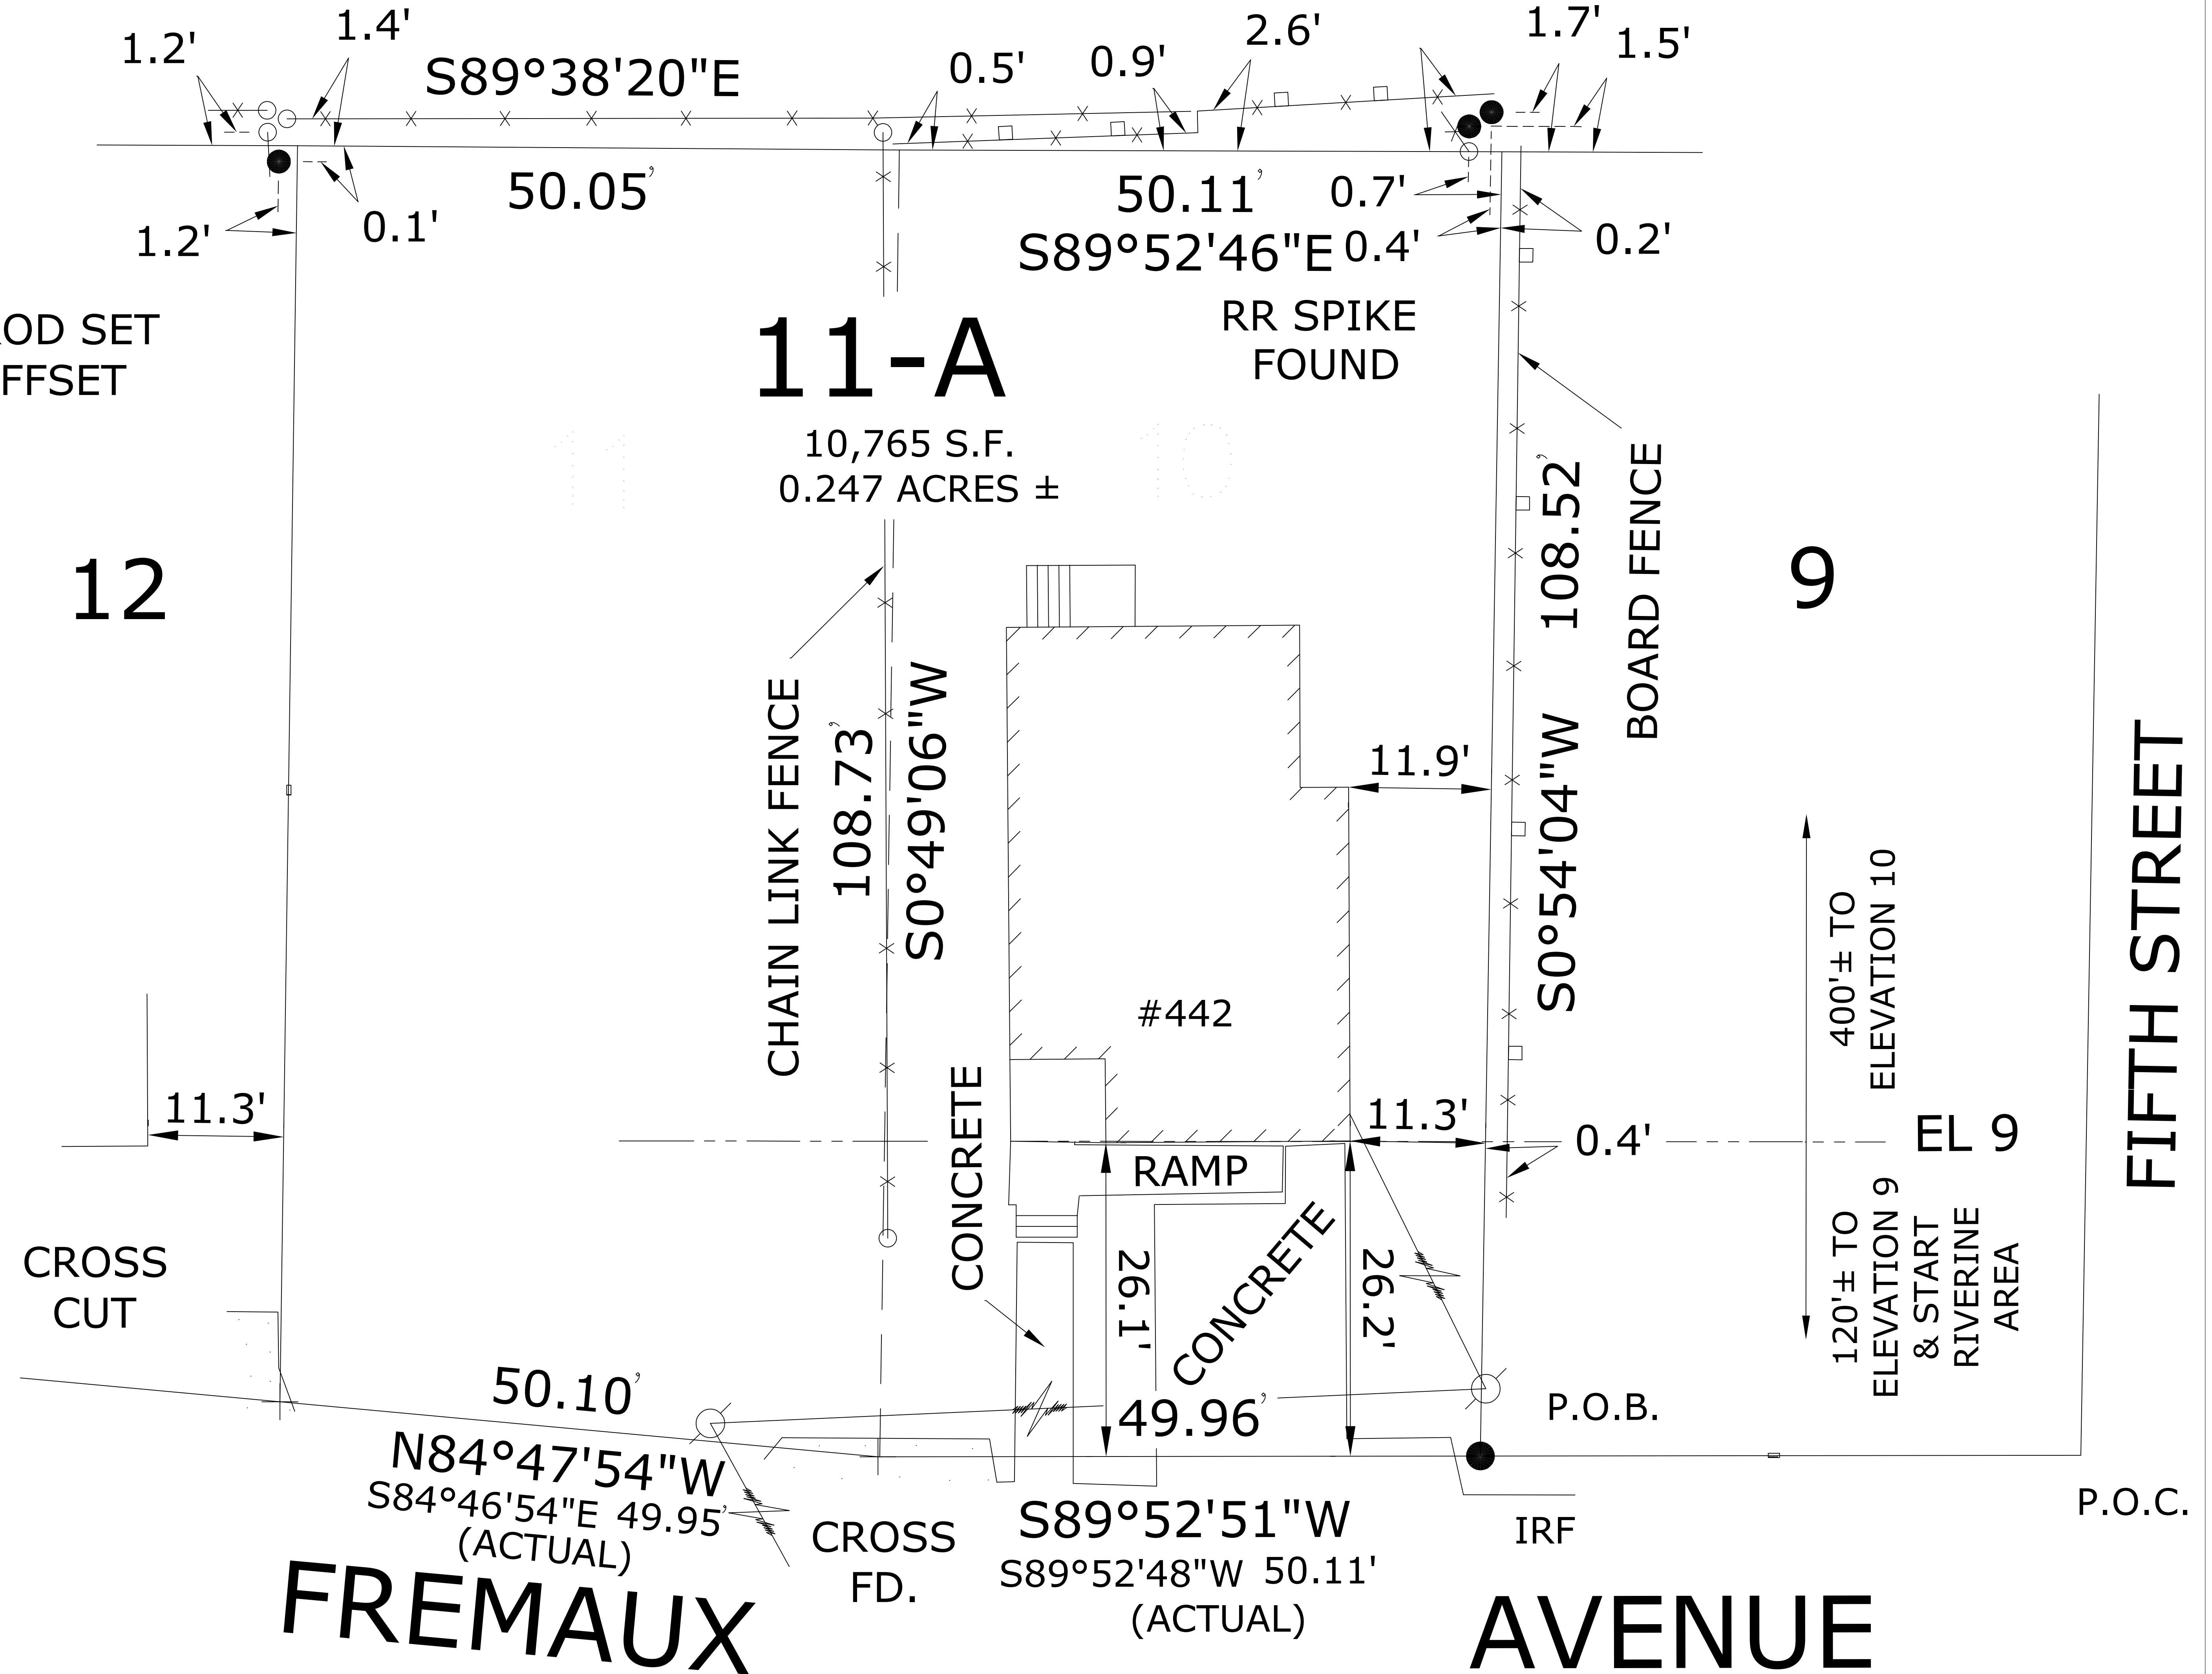

**FREMAUX**

**AVENUE**