


ROBERT STREET

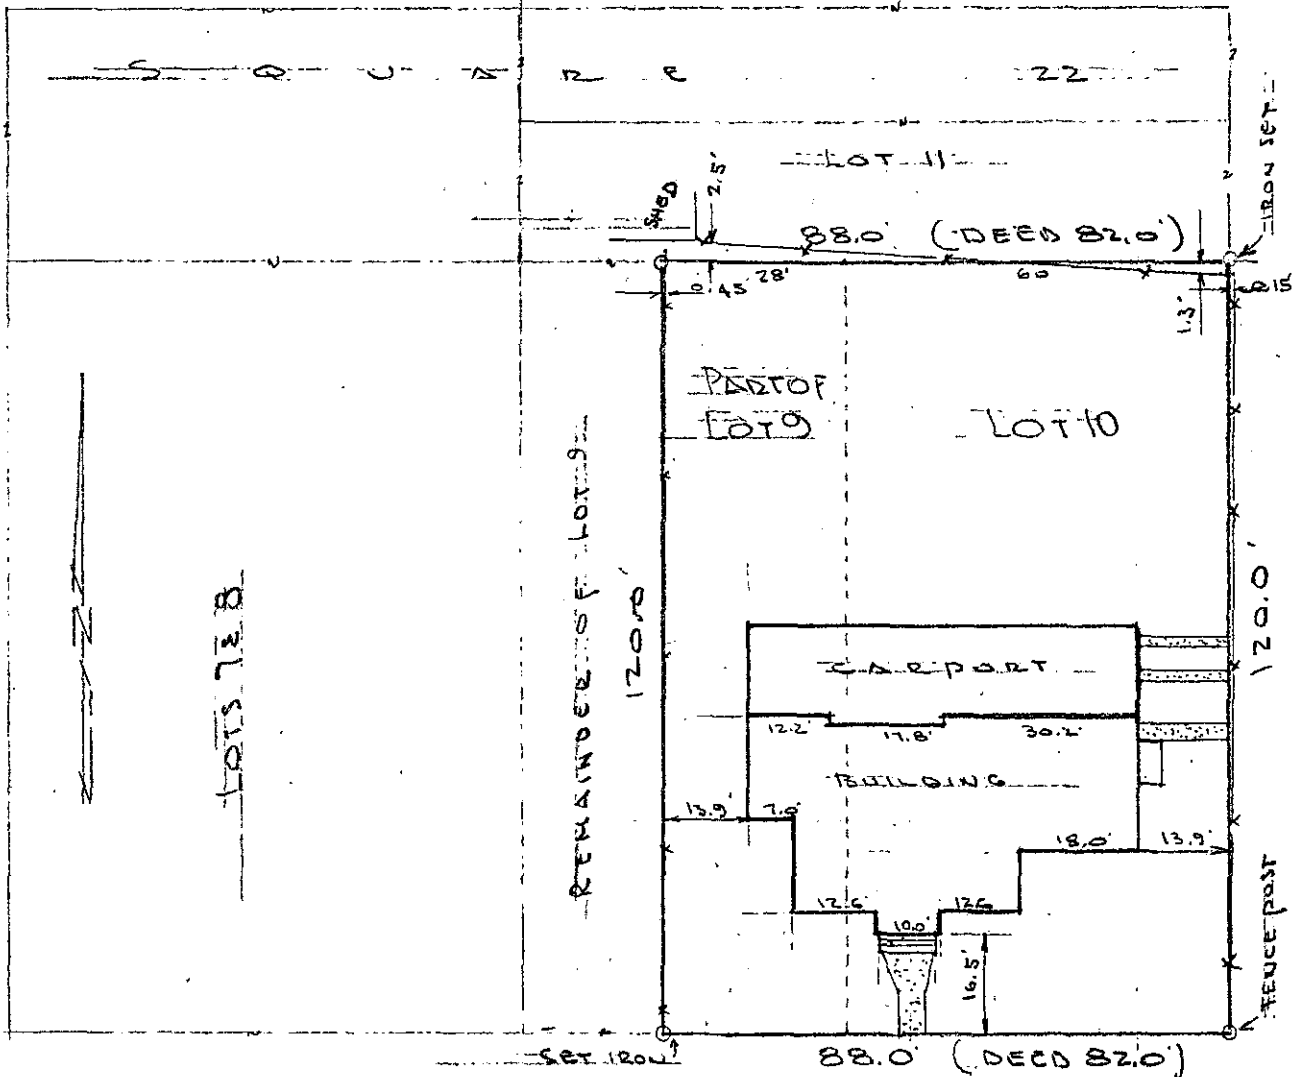

BRAKEFIELD STREET

SURVEY MAP

OF


LOT 10 & EAST 28' OF LOT 9 SQUARE 22 OF ROBERT ADDITION TO SLIDELL

FOR

ST. TAMMANY PARISH, LOUISIANA

FOR

STANLEY SAMROW, SR.

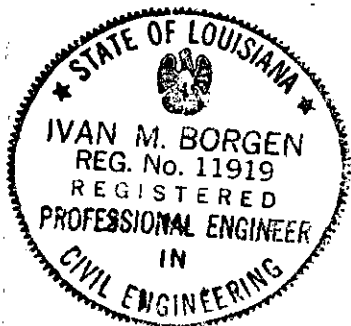

SURVEY No: 19500

DATE: FEB. 9, 1979

REV:

SCALE: 1" = 30'

THIS SURVEY IS CERTIFIED TRUE AND CORRECT BY

IVAN M. BORGEN
NO. 686