
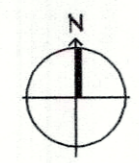



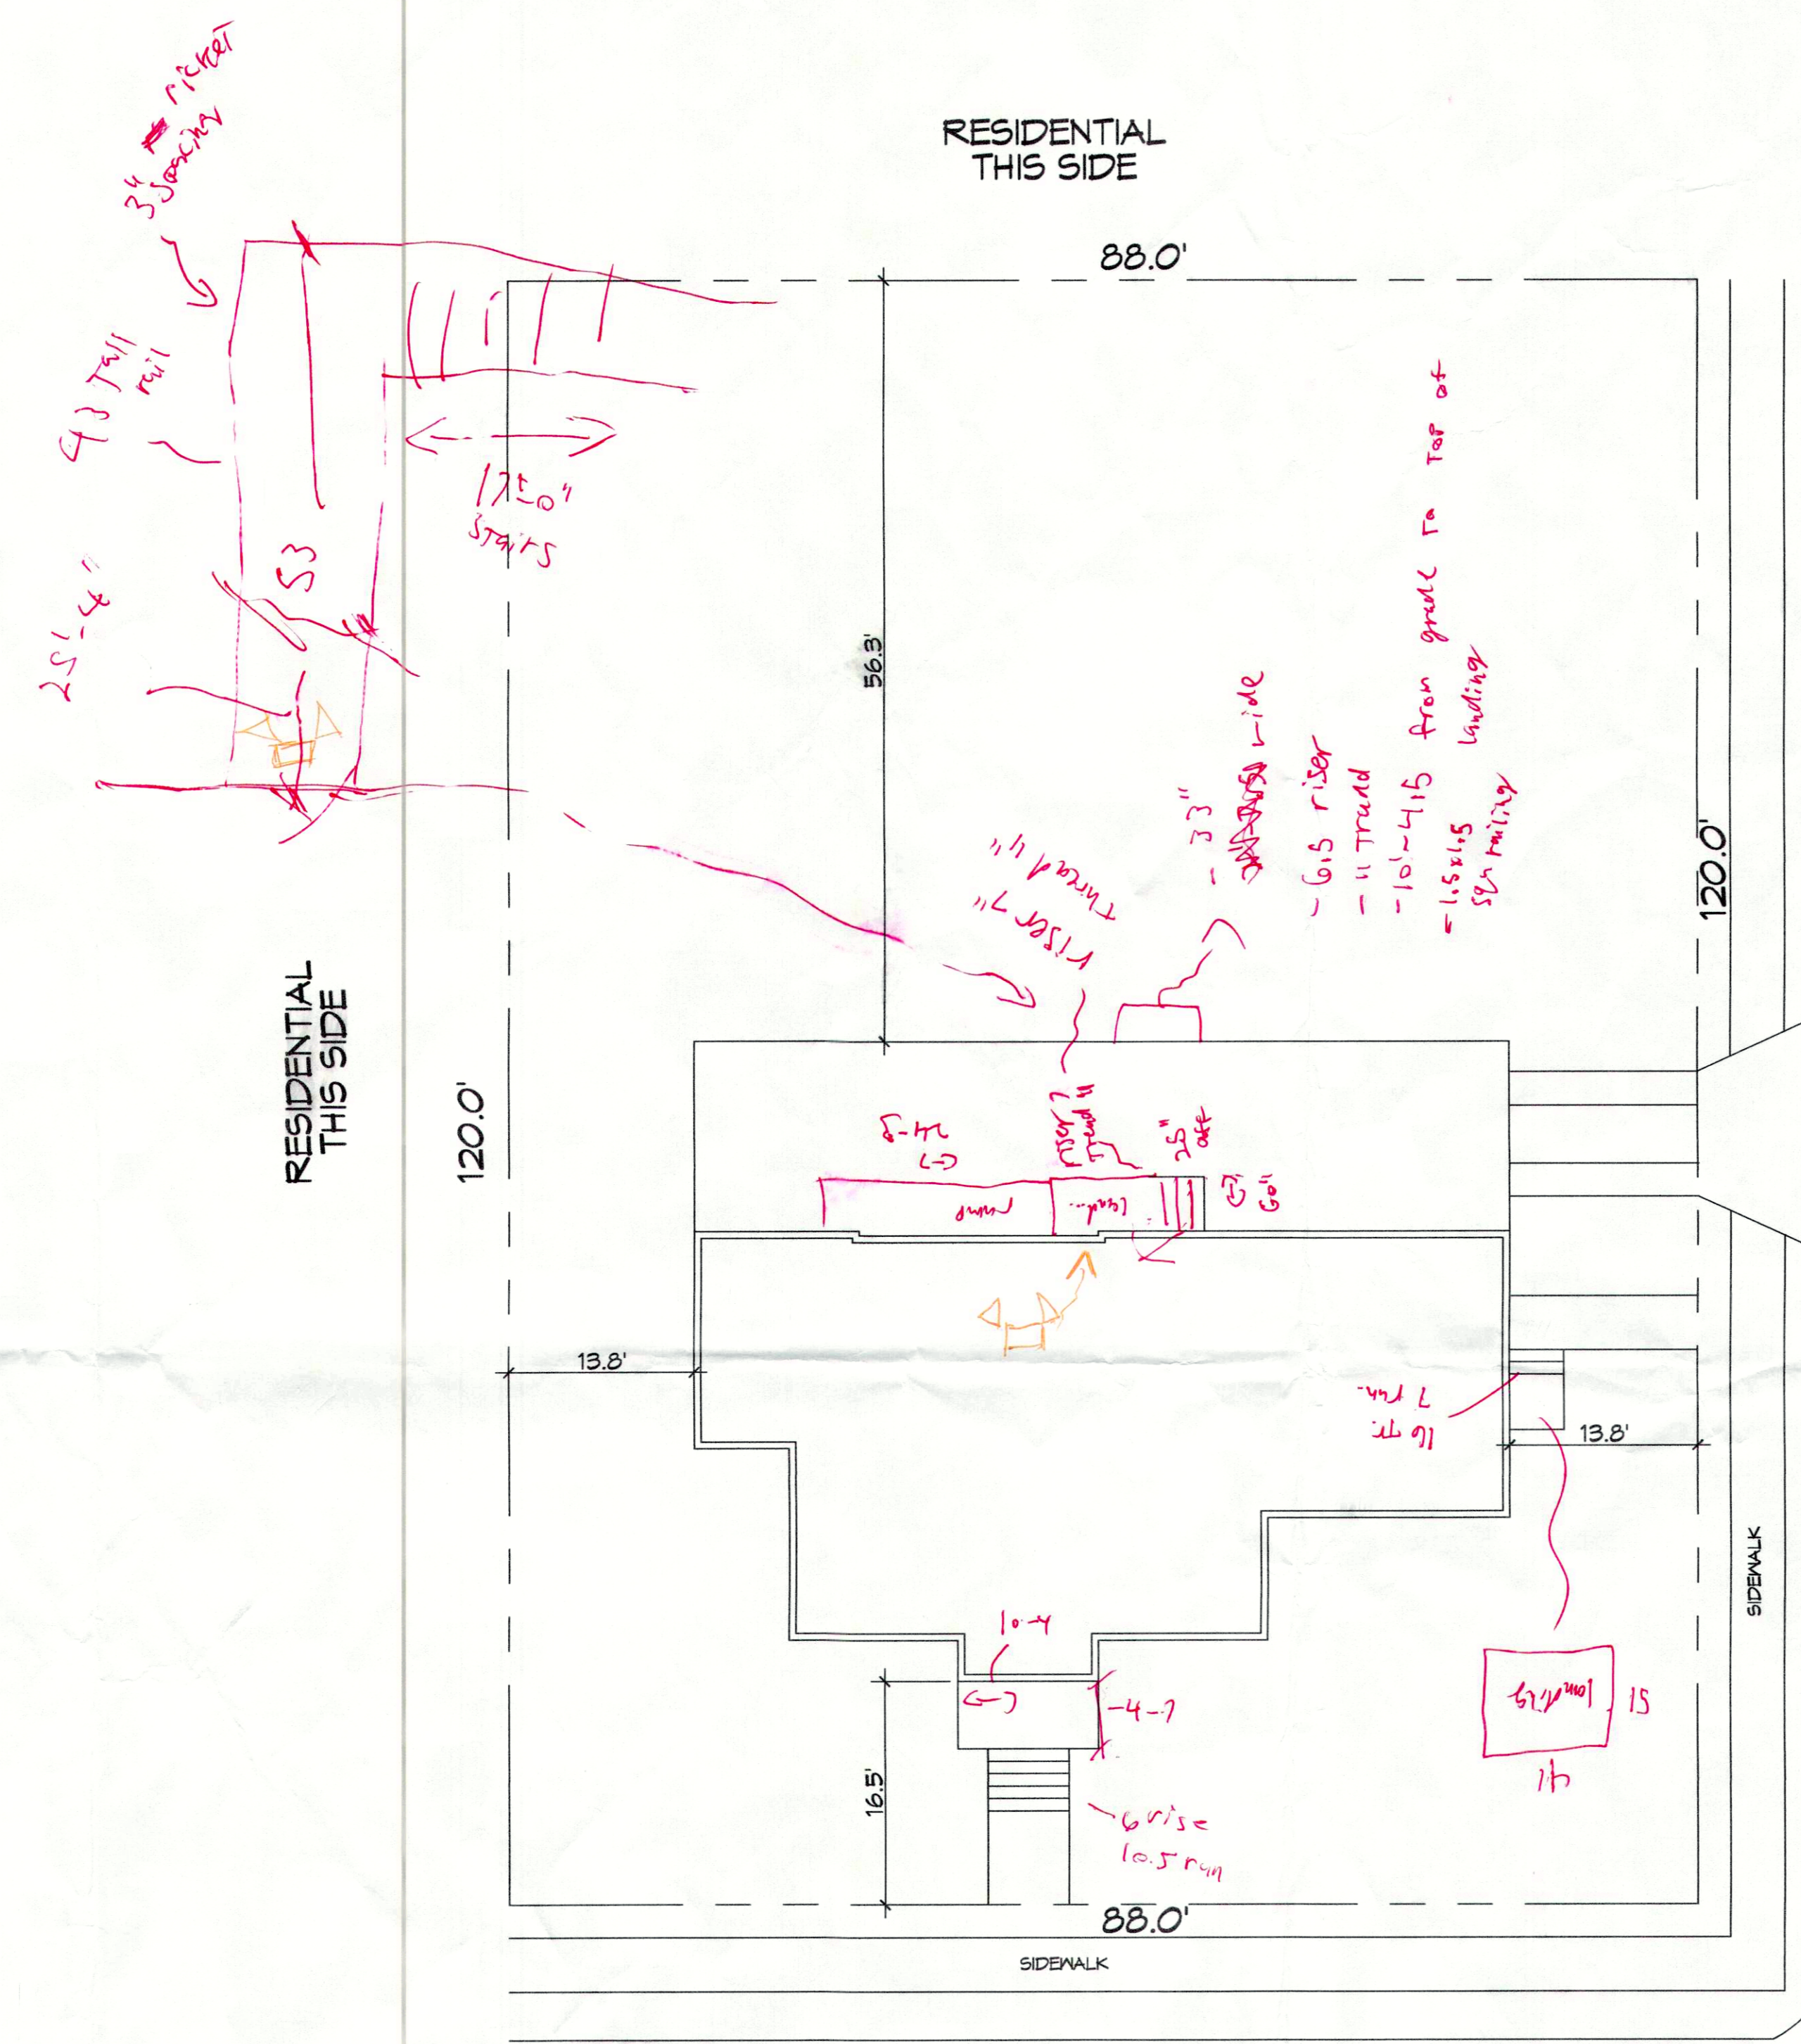

1 EXISTING SITE PLAN
SCALE: 1" = 10'-0"

PARKING	
ACTION PHYSICAL THERAPY AND SPORTS MEDICINE 1 SPACE PER REQUIRED 200 SQ. FT. OF BUILDING AREA: 5071 SQ. FT. / 200 = 25 REQUIRED	
OFFICE/PROFESSIONAL OFFICE AND/OR GROUPS OF BUILDINGS OF SIMILAR NATURE: 1 SPACE PER EACH 350 SQ. FT. OF GROSS FLOOR AREA EXCLUDING STORAGE AREAS WHICH SHALL NOT EXCEED 15 PERCENT OF THE GROSS SQUARE FOOTAGE.	
AREA: 1429 SQ. FT. / 350 = 4 REQUIRED	
24 REQUIRED PARKING PLACES FOR ALL SUITES	
32 PARKING SPACES PROVIDED FOR WHOLE SITE	

DAMMON ENGINEERING, INC.
LOUISIANA & MISSISSIPPI

Chief Engineer: Brian Metch, PE
554 Old Spanish Trail
Slidell, LA 70458

www.dammonengineering.com
info@dammonengineering.com
PH: 985.649.5832

#	DESCRIPTION	REVISIONS	DATE
1			

SEAL:

EXISTING BUILDING
MIDWIFE GRACE COLLECTIVE

340 BRAKEFIELD ST
SLIDELL, LA 70458

JOB No: 2022 DATE: 09-29-2022
DRAWN BY: CKZ CHECKED BY: JMS

SHEET TITLE:
EXISTING SITE PLAN

DRAWING NUMBER:
C101

SHEET No: 3 of 1