


Copyright © Waring Architects 2002. All rights reserved. Except as permitted under the Copyright Act of 1976, this drawing may not be reproduced in whole or in part in any manner.  
SEAL:  
This drawing is the property of Waring Architects, and is not to be reproduced or copied in whole or in part. It is only to be used for the project and site specifically identified herein.  
Scales as stated herein are valid on the original drawing only. These plans were prepared in this office or under our personal supervision, and to the best of our knowledge comply with state and local codes.

PROJECT NO:  
200343


DATE:  
11/05/03

REVISIONS:

A101  
2 OF ?

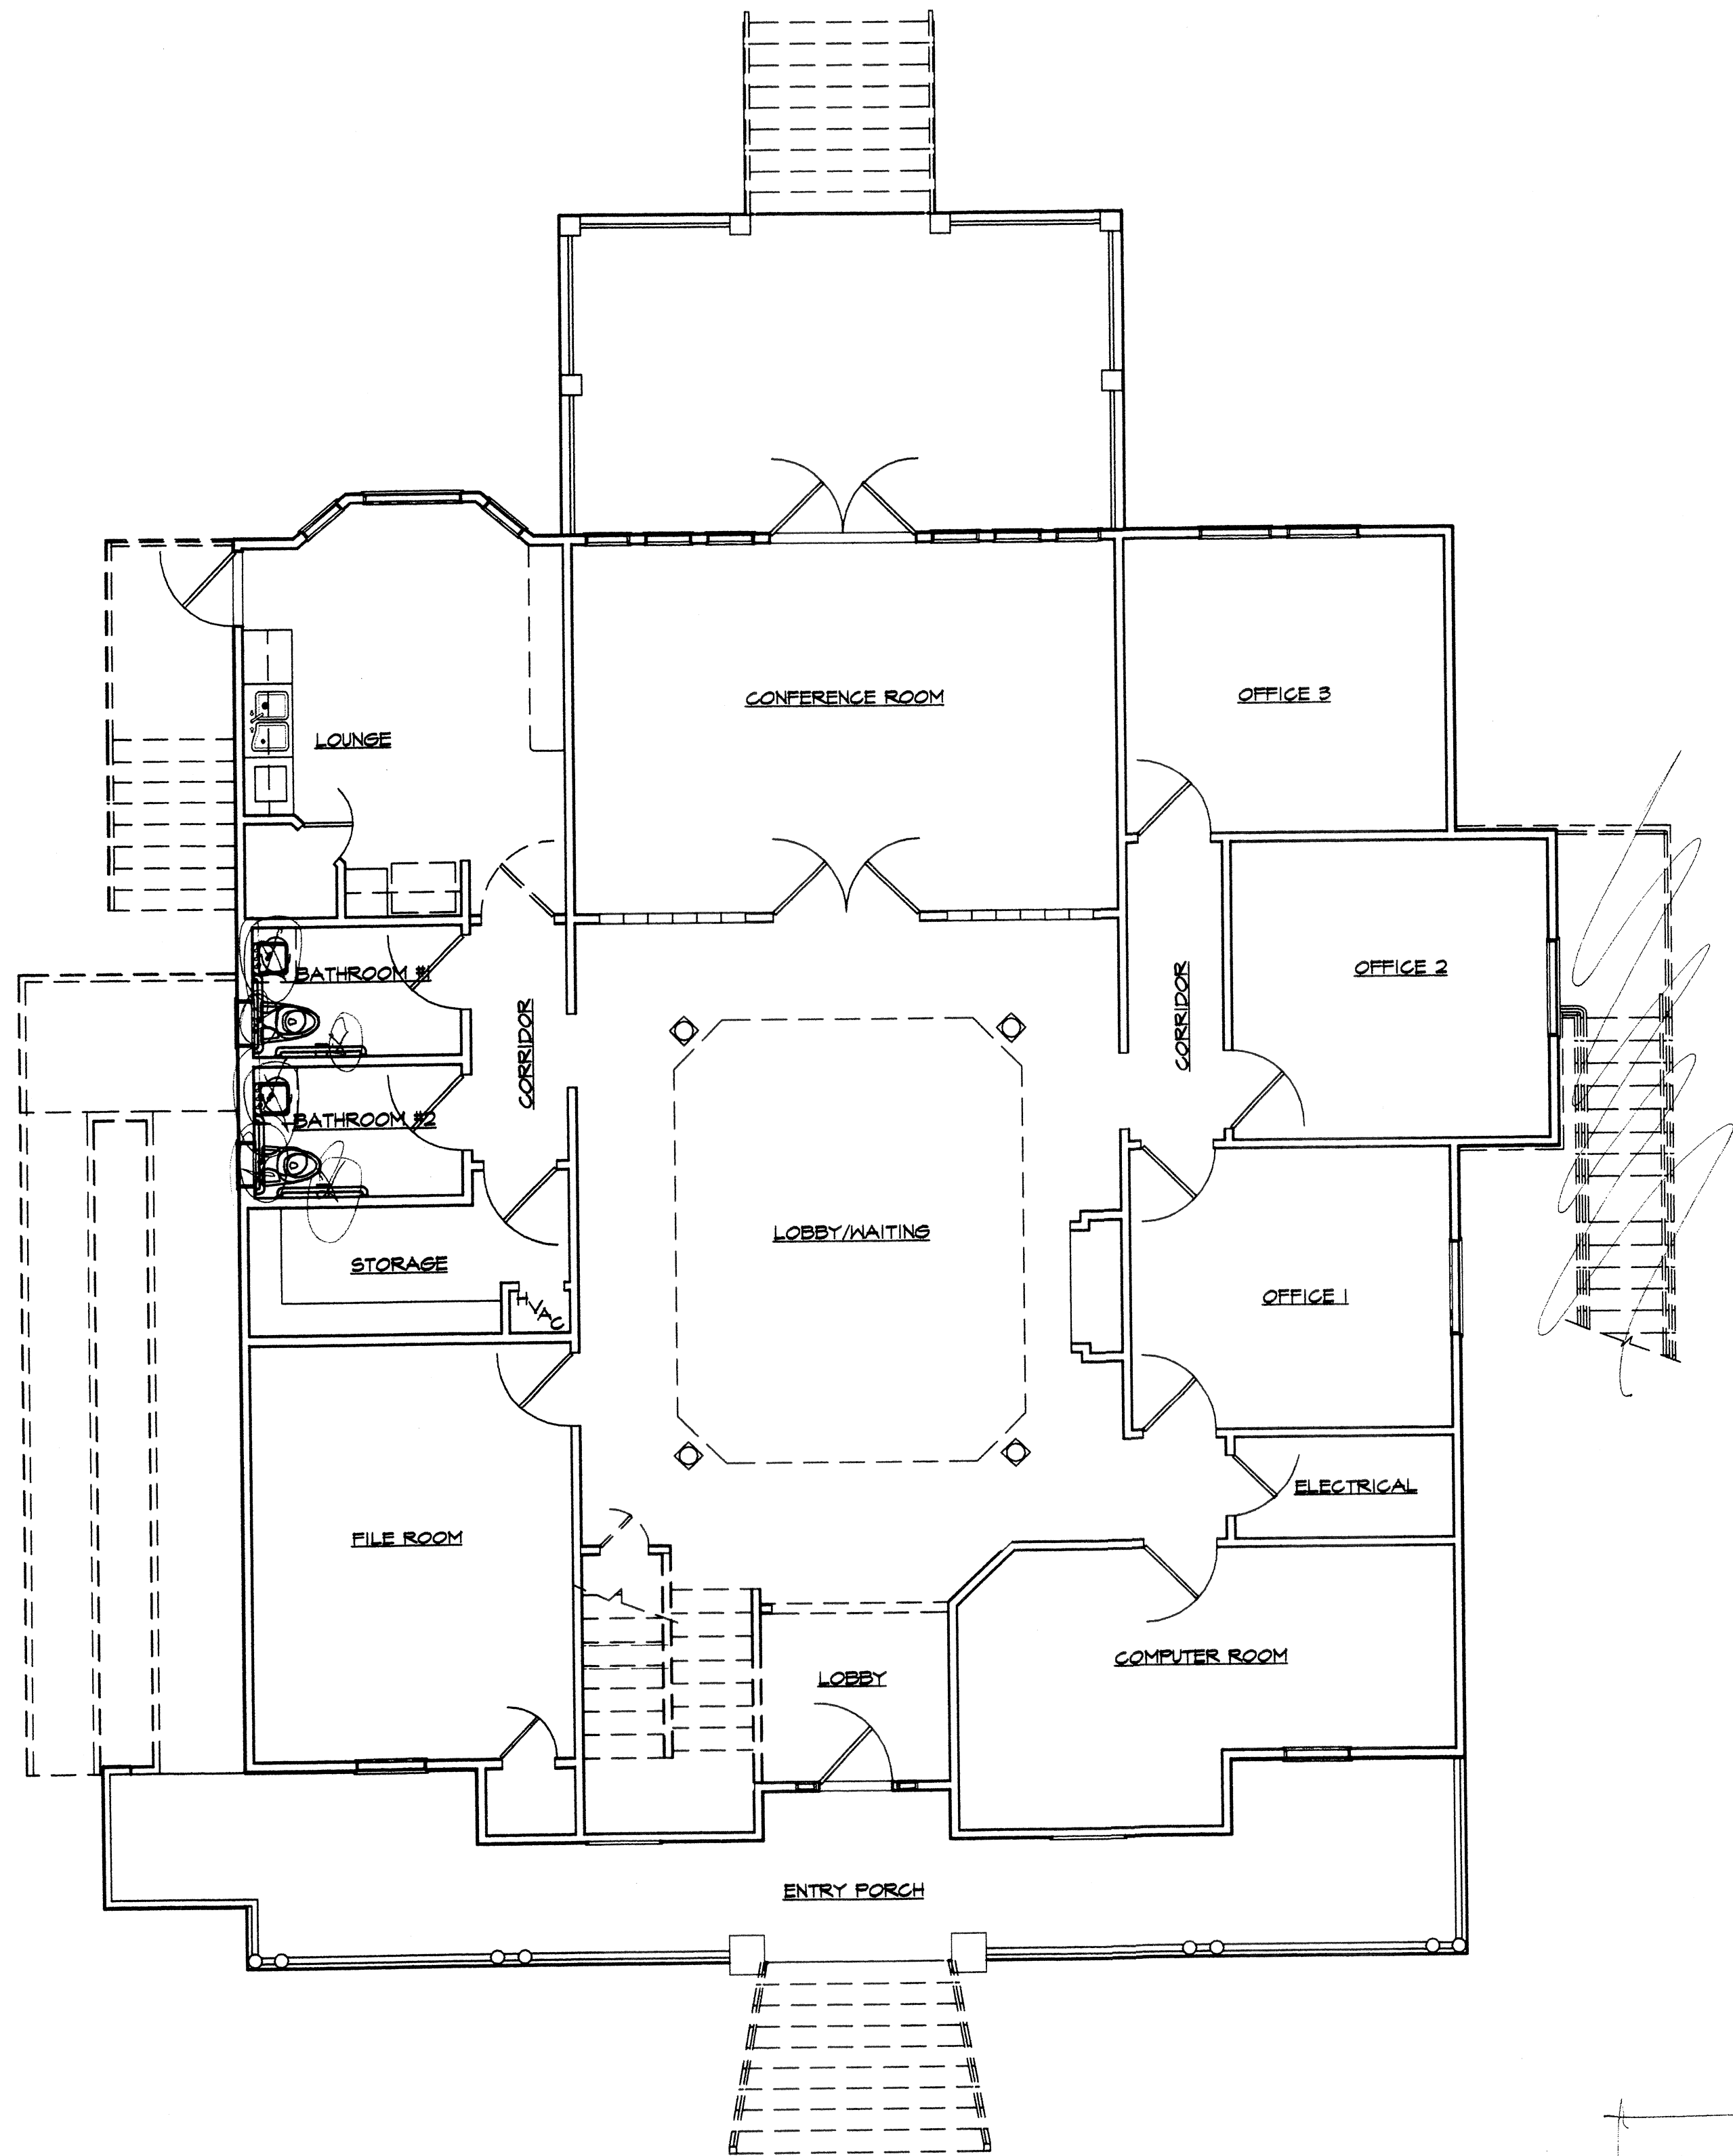

1 EXISTING / DEMOLITION FIRST FLOOR PLAN  
A101 SCALE: 3/16" = 1'-0"

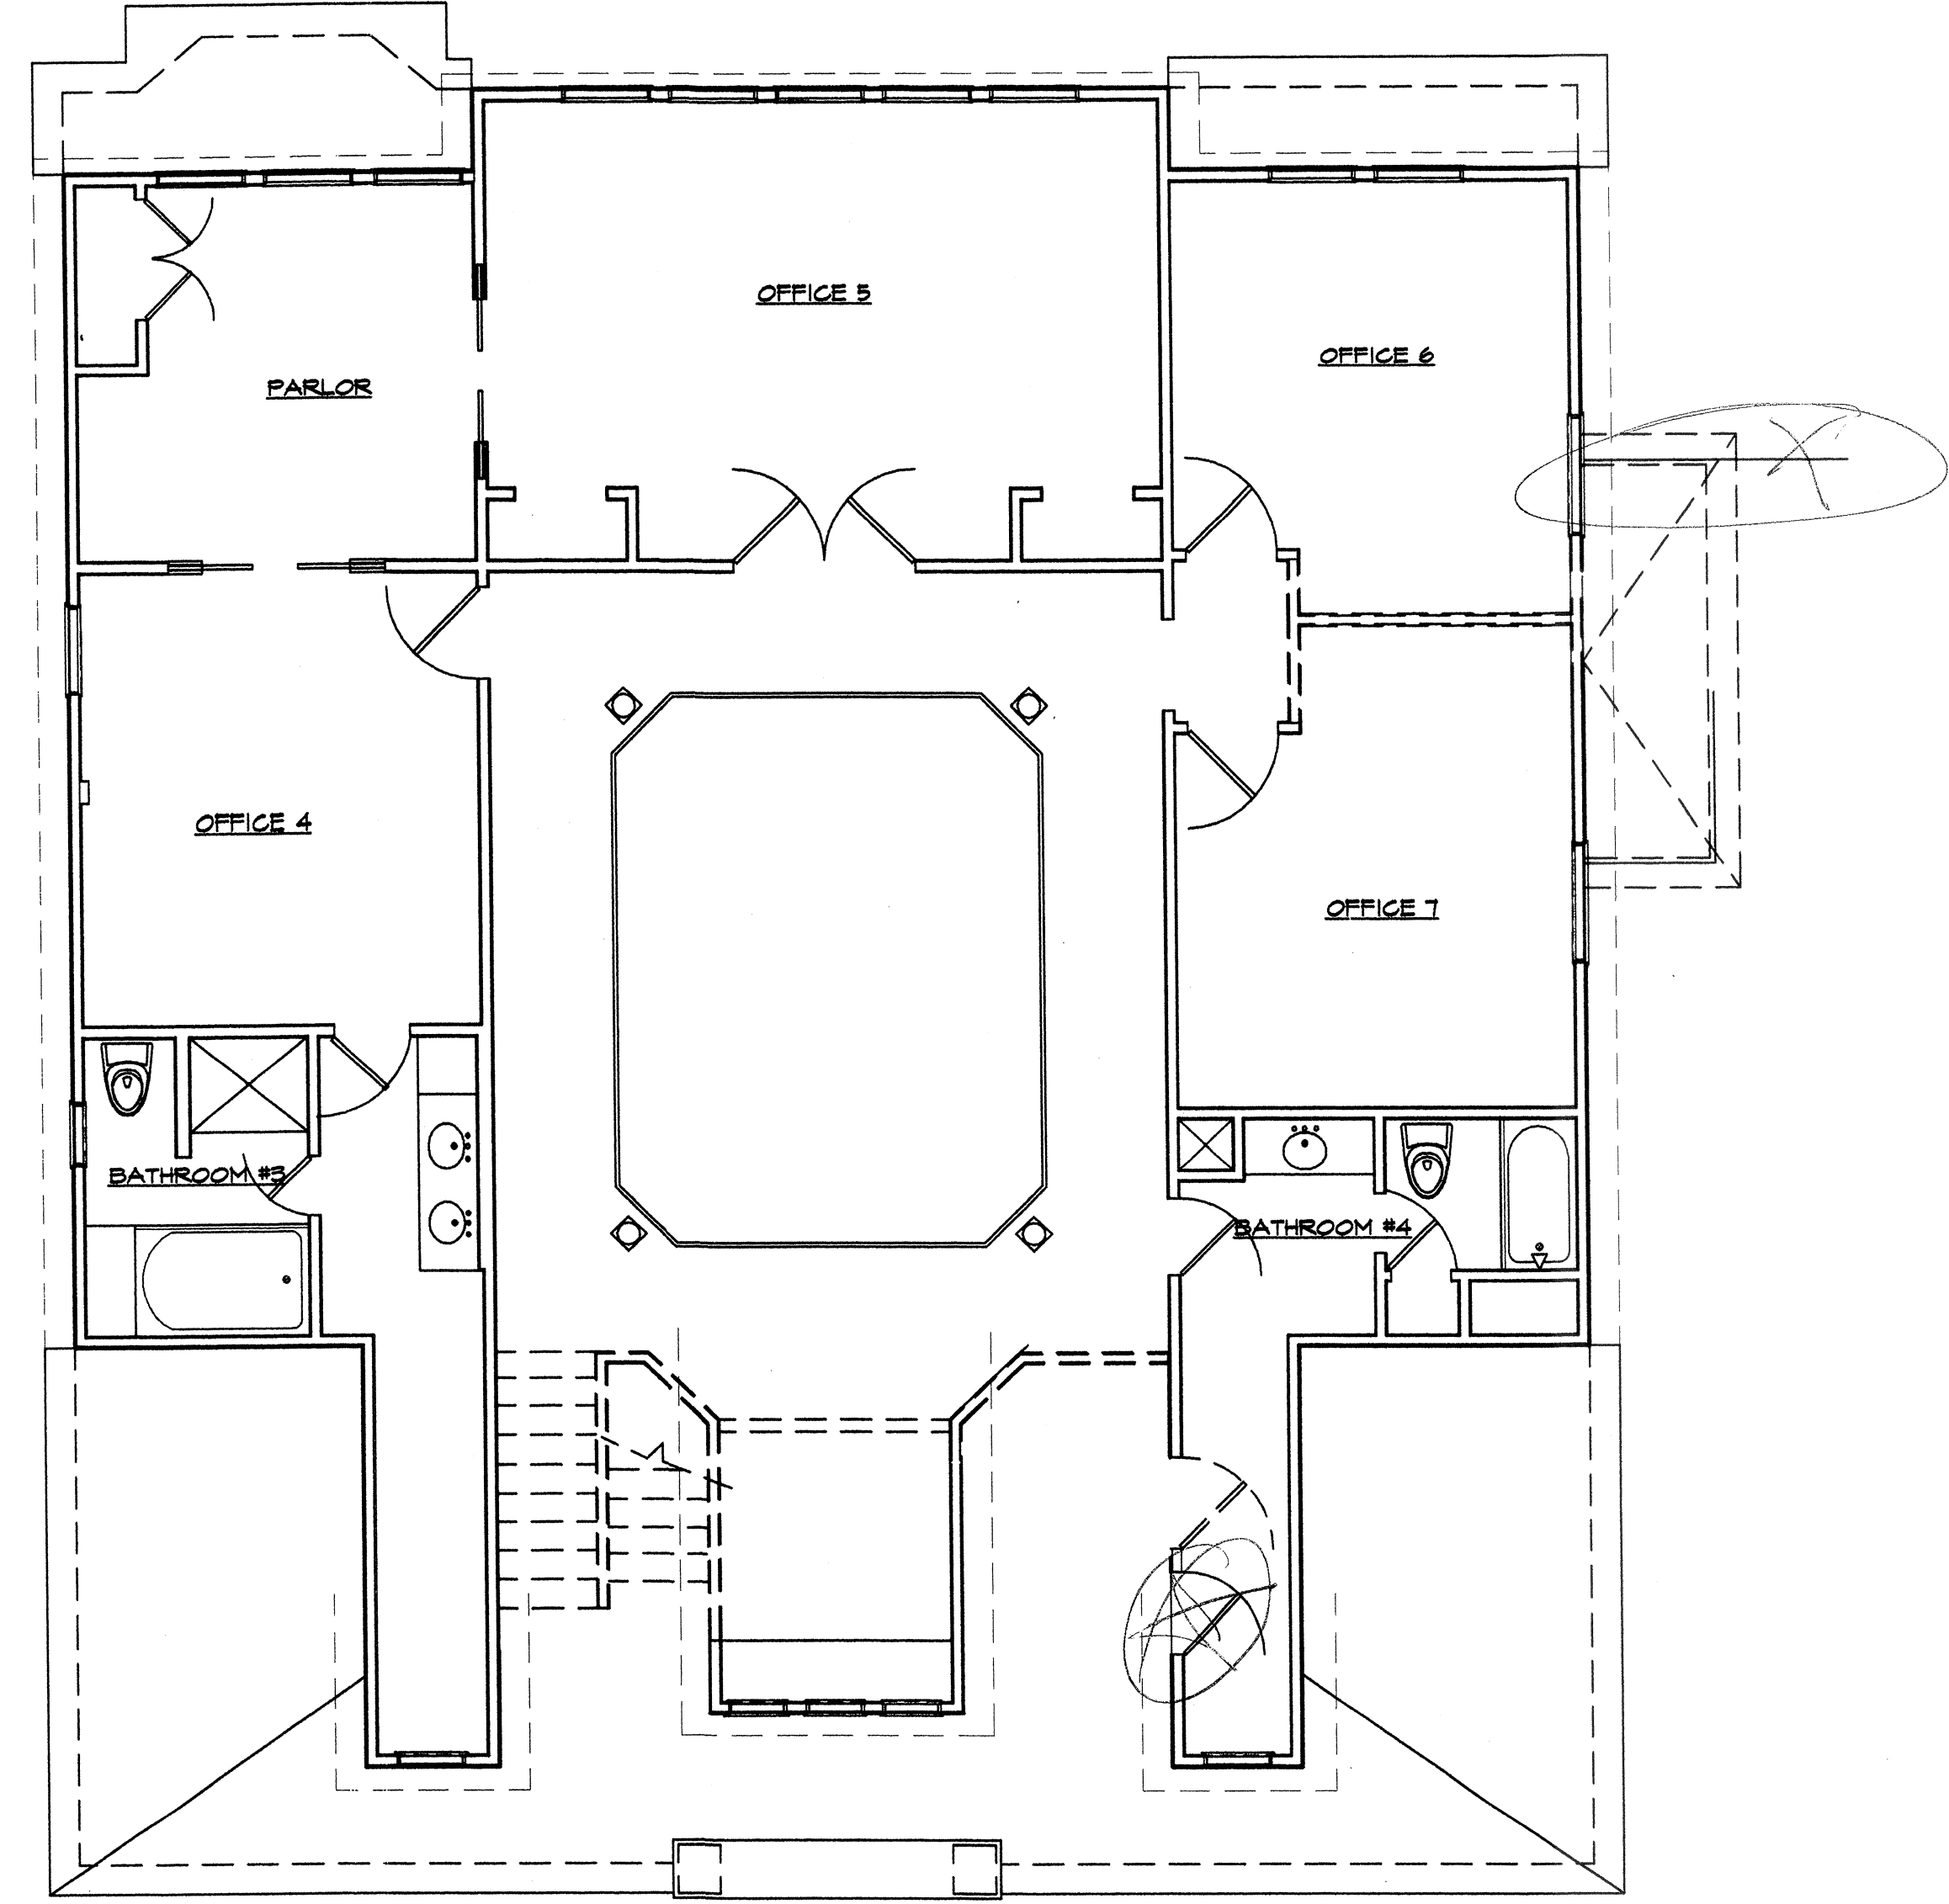

2 EXISTING / DEMOLITION SECOND FLOOR PLAN  
A101 SCALE: 3/16" = 1'-0"

----- Walls to be removed