

Copyright © 2002 by Waring Architects, Inc. All rights reserved. Except as permitted under the Copyright Act of 1976, this drawing may not be reproduced in whole or in part in any manner.

SEAL:

This drawing is the property of Waring Architects, Inc. and is not to be reproduced or copied in whole or in part. It is only to be used for the project and site specifically identified herein.


Scales as stated herein are valid on the original drawing only. These plans were prepared in this office or under our personal supervision, and to the best of our knowledge comply with state and local codes.

PROJECT NO:
200343

DATE:
11/05/03

REVISIONS:

A103
4 OF ?

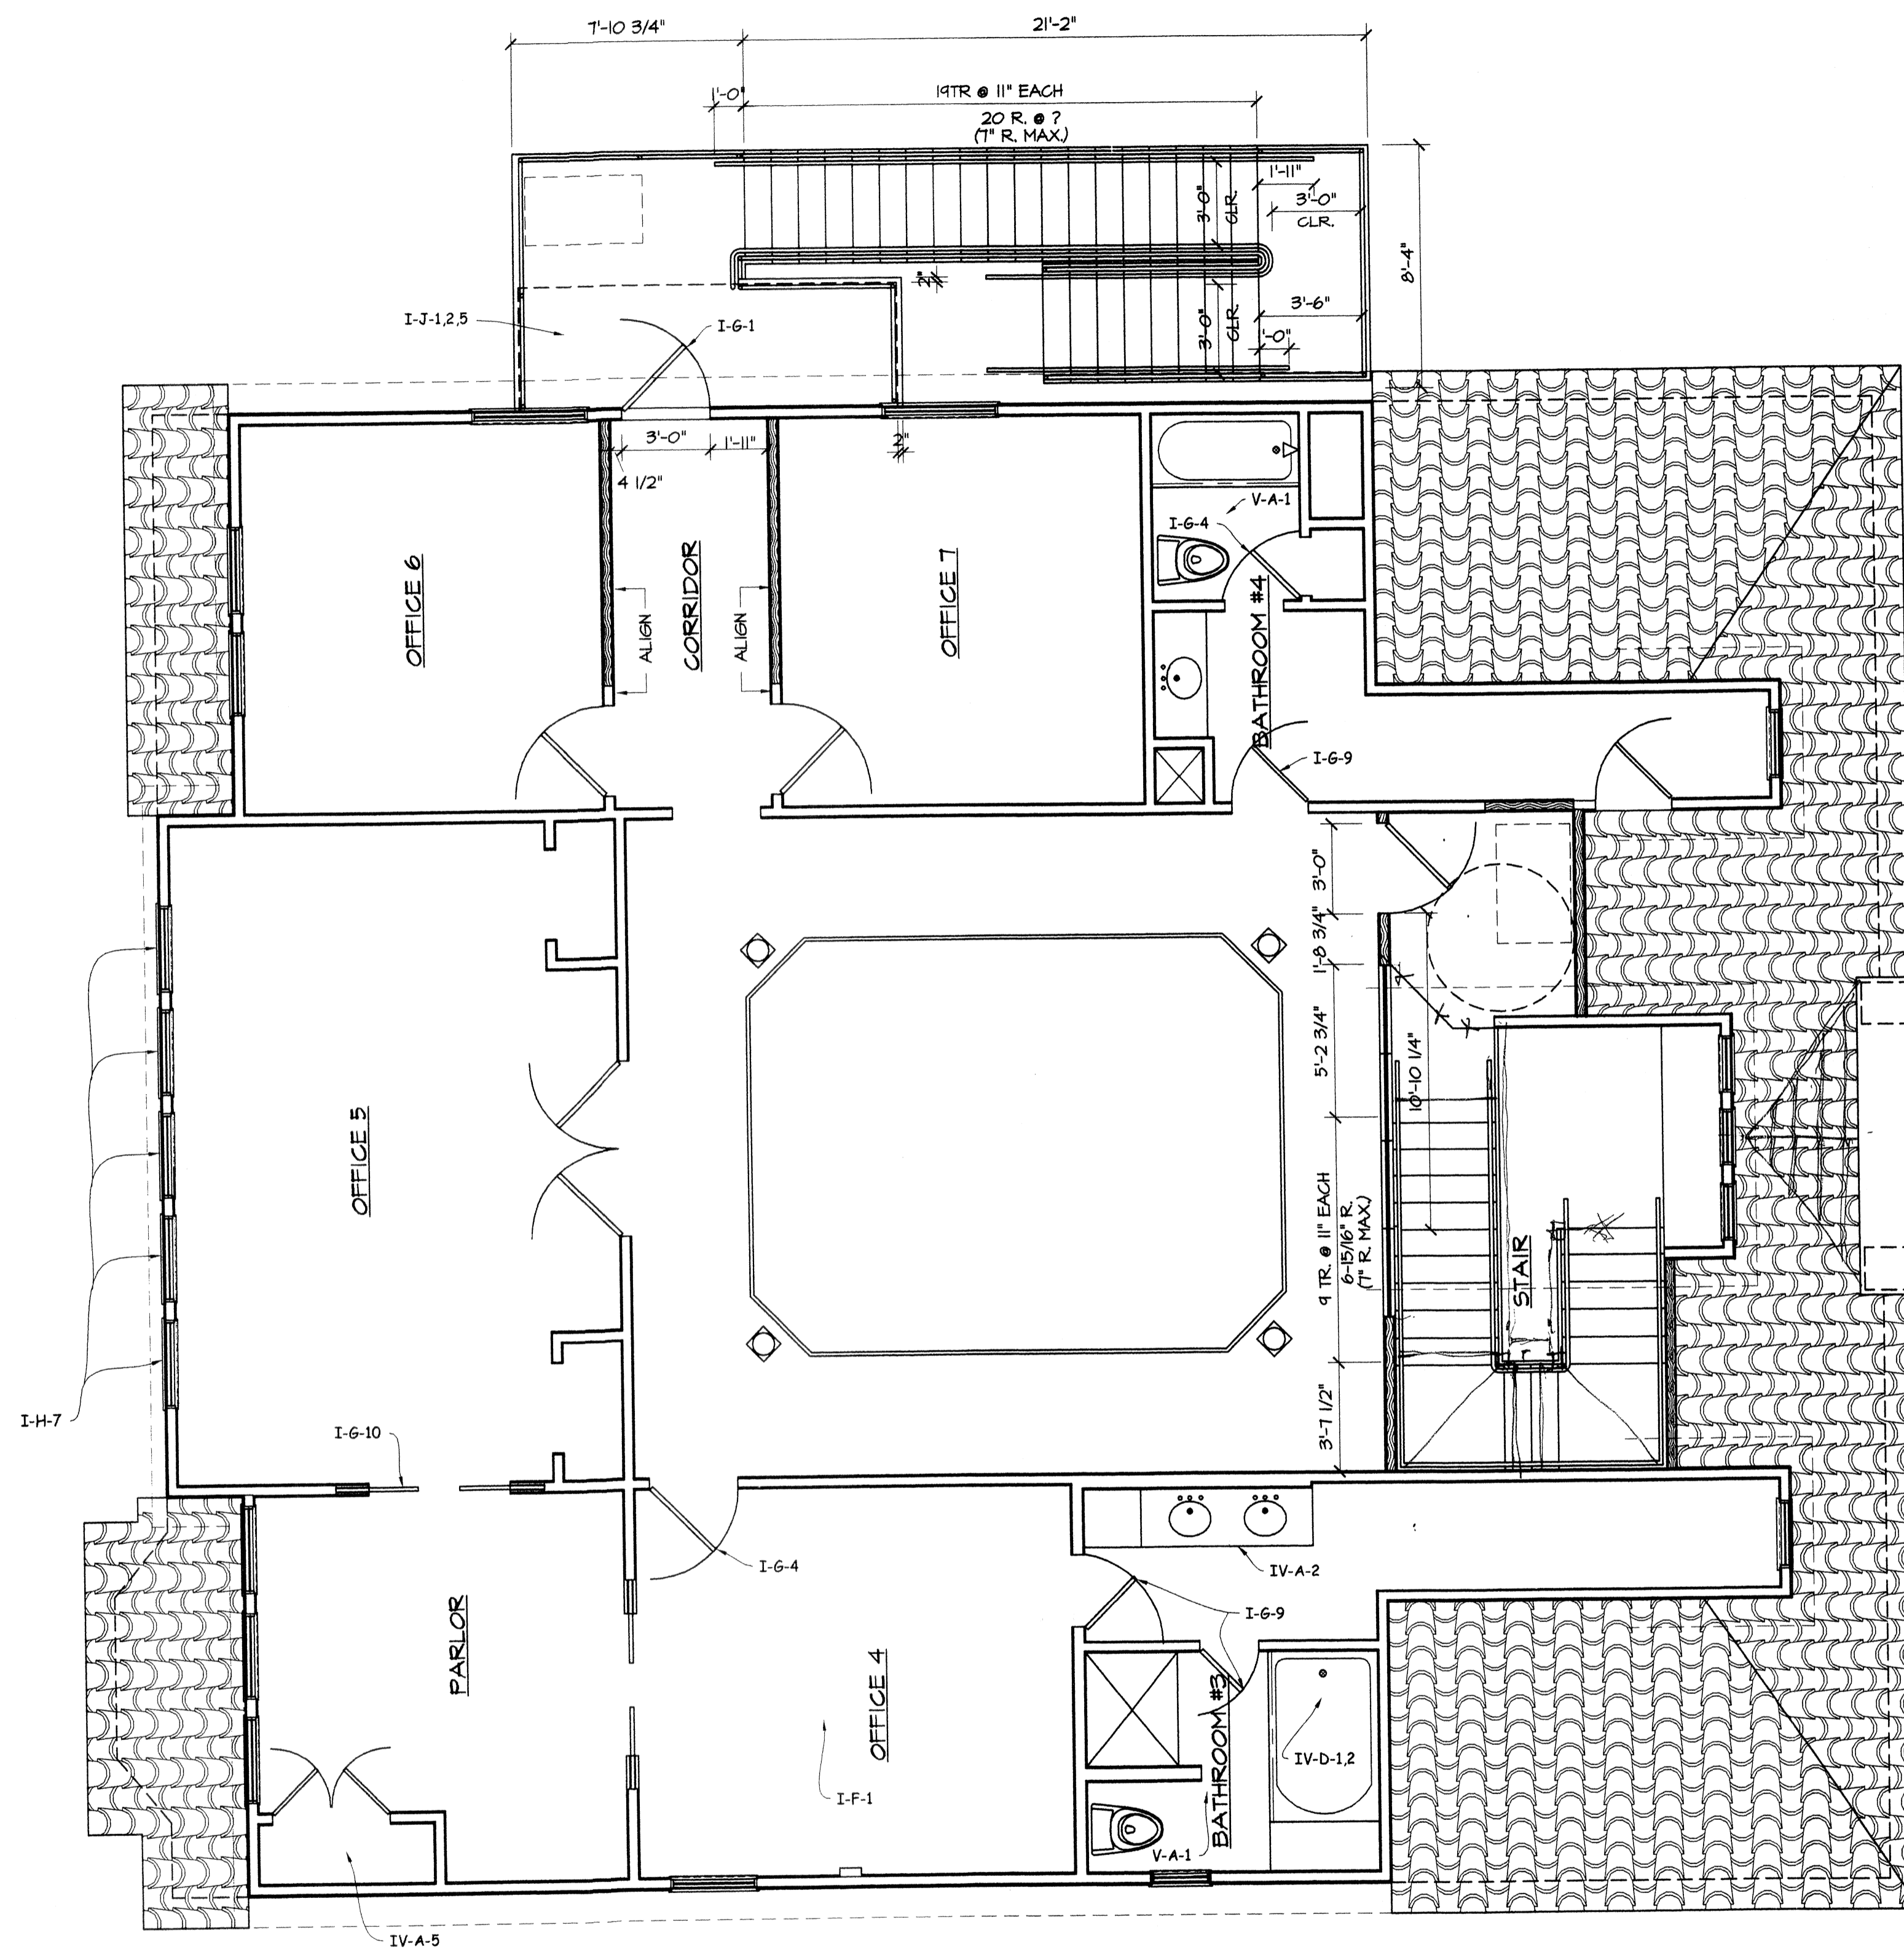

REFERENCE SHEET A-204
FOR GEN. NOTES

Burry?
new roof hatch pattern



- GENERAL NOTES:
I-E-3,4,5
I-F-1,2,3,4
I-G-3,4,5,6,7,8,9
I-H-1,2,3
I-V-A-1
I-V-B-1,2,3
I-V-B-1

CONTRACTOR TO REVIEW CLOSELY ALL SECTIONS AND NOTES OF C.O. #5 1&2 AND PERFORM ALL WORK PROPERLY & DILIGENTLY.

PROPOSED SECOND FLOOR PLAN
SCALE: 1/4" = 1'-0"