



REVISION	BY
10-28-2015 CONSTRUCTION SET	SMT

DDG
 DUPLOMANTIS DESIGN GROUP, PC
 CIVIL ENGINEERING + ARCHITECTURE
 34 LOUIS PRIMA DRIVE COVINGTON, LA 70433
 WWW.DDGP.COM PHONE: 985-249-6886 FAX: 985-249-6790
 THIBODIAUX | COVINGTON | HOUSTON | BATON ROUGE | HOUMA | DALLAS

Thomas H. Buckel
 SIGNATURE: _____
 DATE: 10/28/2015
 STAMP: STATE OF LOUISIANA PROFESSIONAL ENGINEER THOMAS H. BUCKEL

SPRINGS @ RIVER CHASE
 COVINGTON, LA
 ST. TAMMANY PARISH
 FOR CONTINENTAL 339 FUND LLC
 COVINGTON, LA

DRAWN: DJG
 CHECKED: THB
 ISSUED DATE: 10/28/2015
 ISSUED FOR CONSTRUCTION
 PROJECT NO.: 14-697
 FILE DETAILS
 SHEET: C-5.4

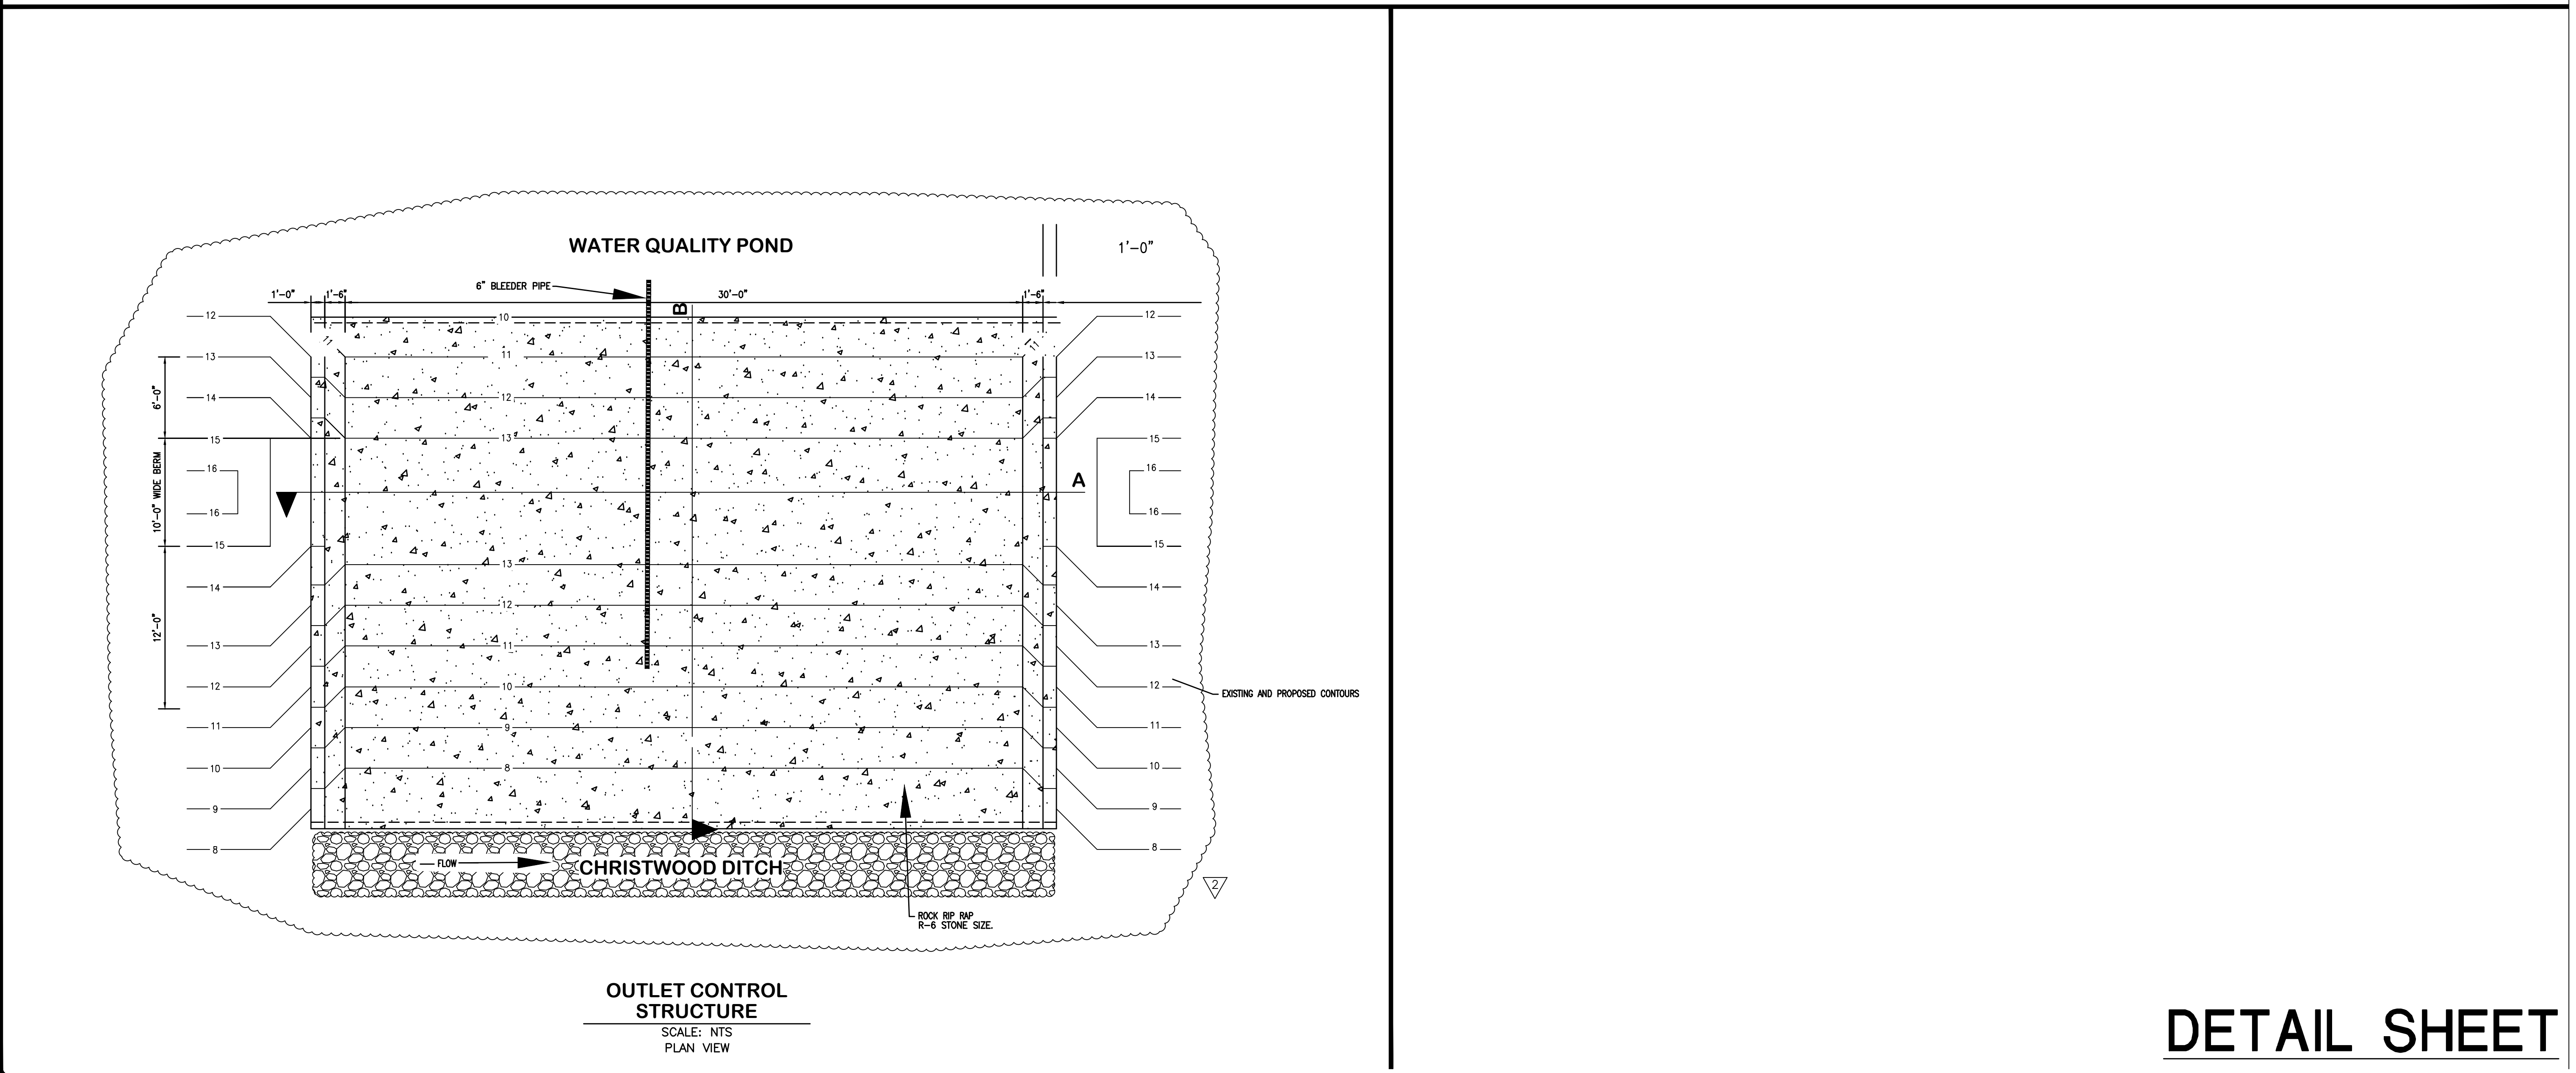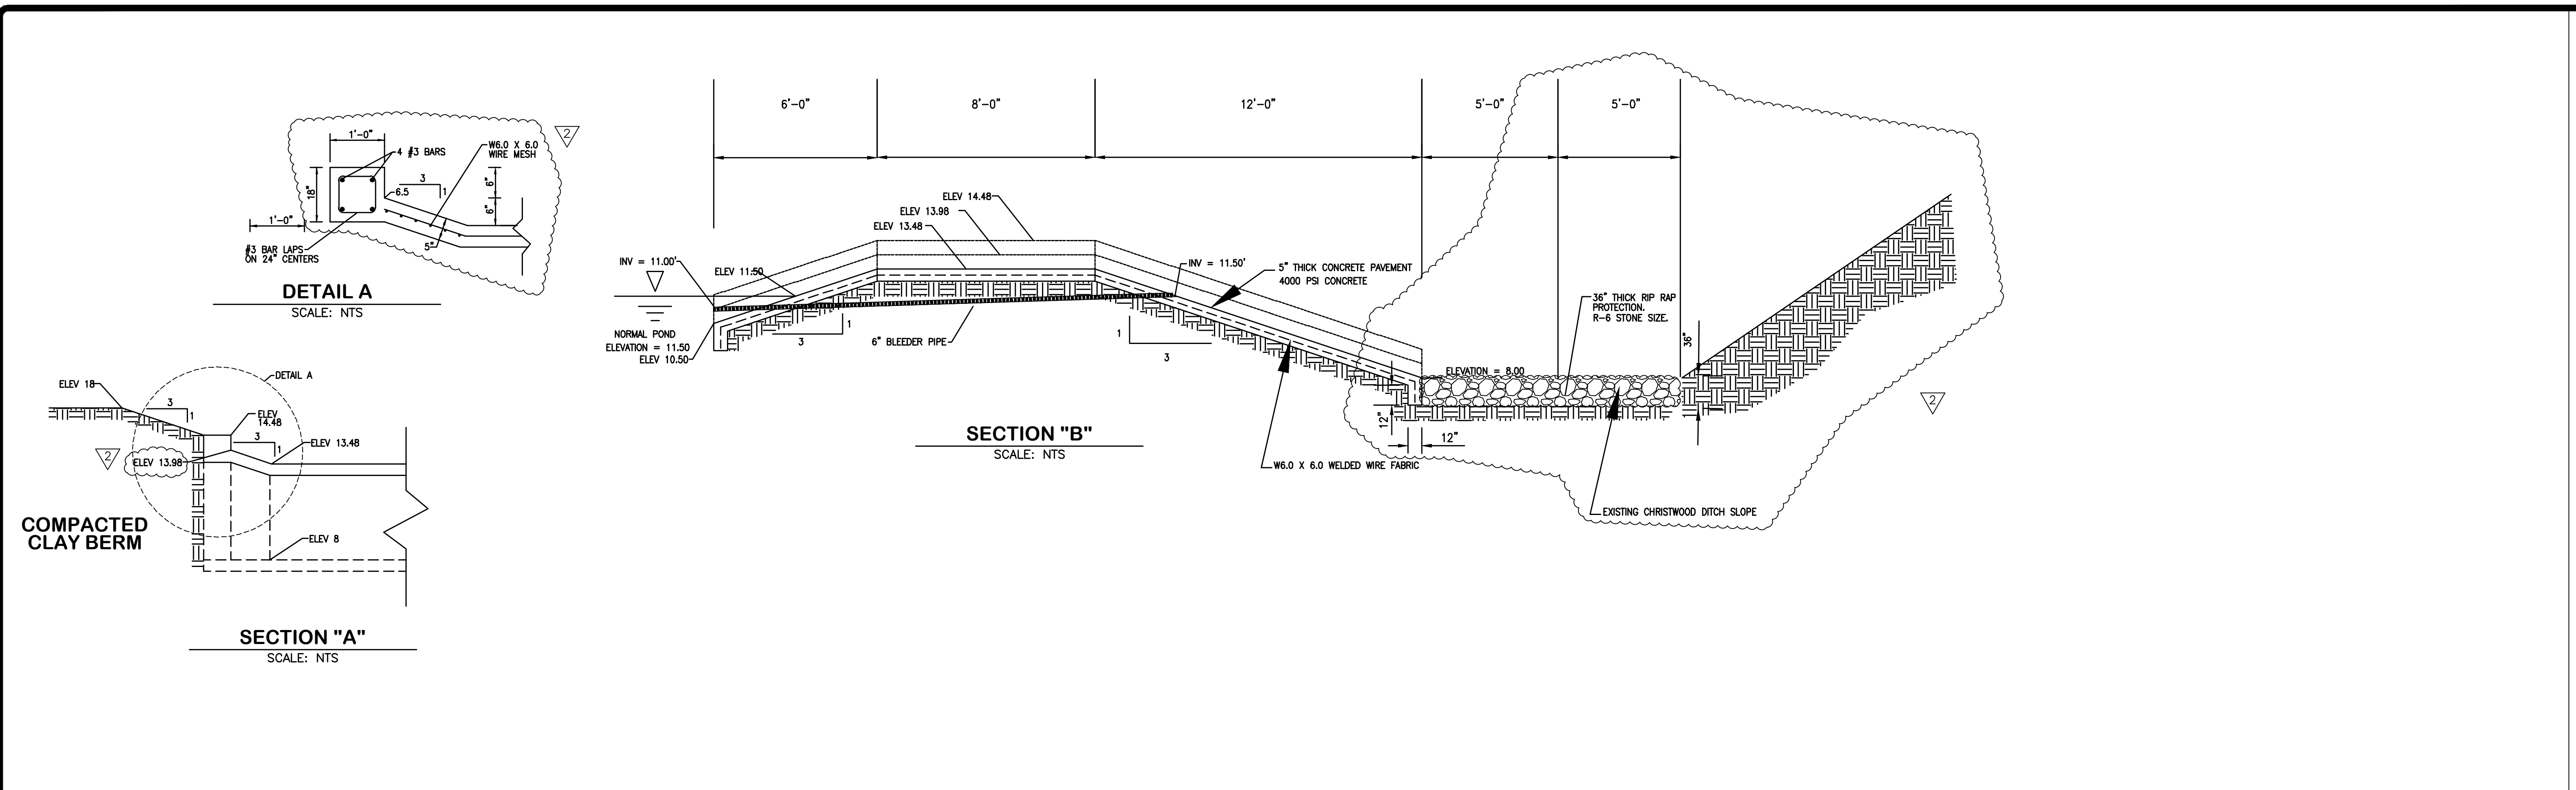

DETAIL SHEET

M:\CAD\DWG\14-000\14-597_DWG\DETAILS.dwg