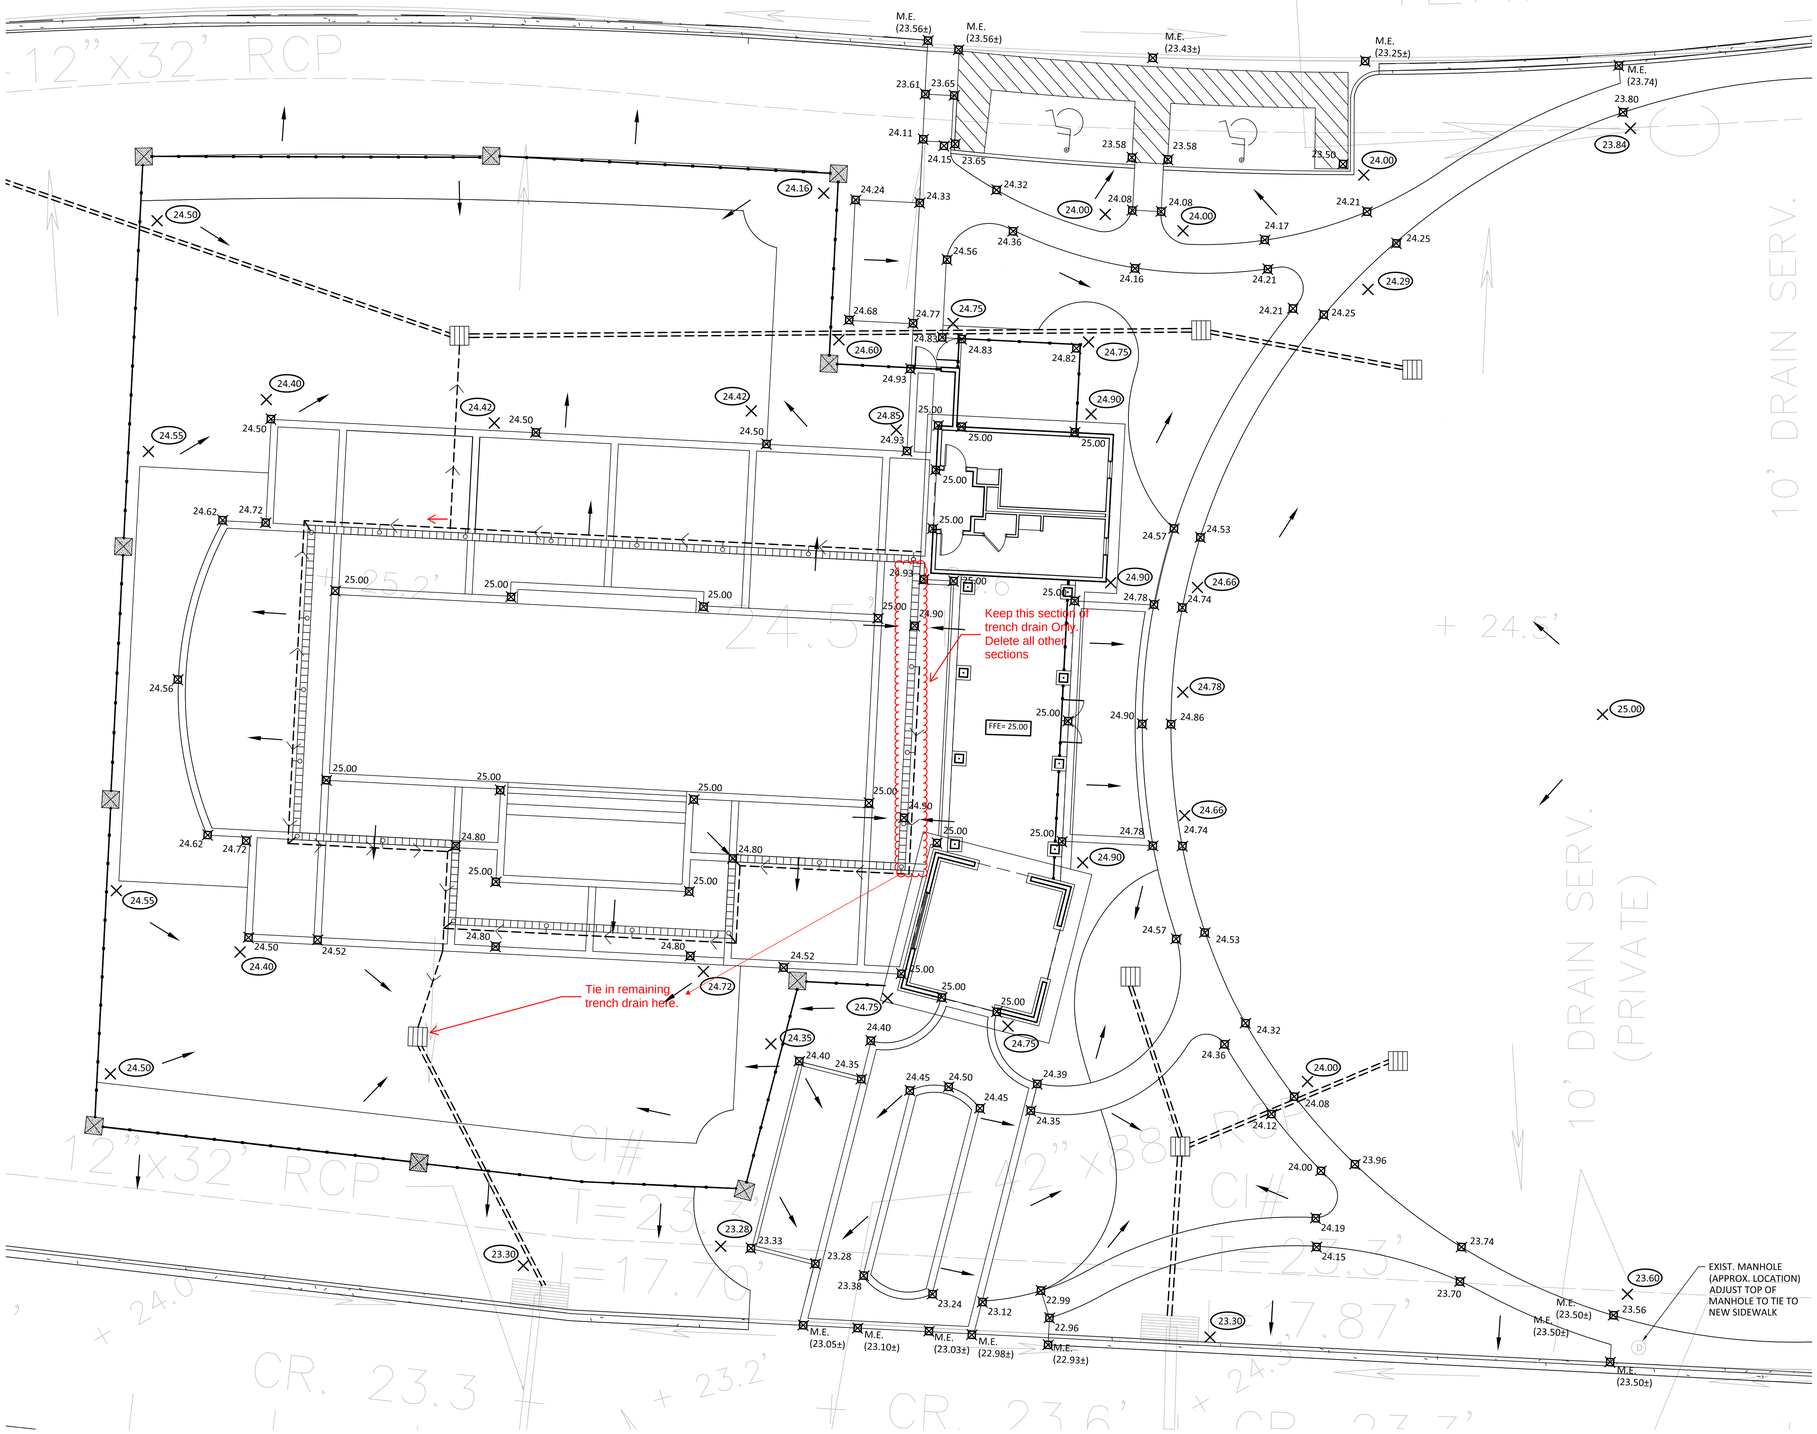

0 10' 20'

LEGEND:

	PROPERTY LINE
	REQ'D DRAIN LINE
	CROWN / RIDGE
	REQ'D CATCH BASIN
	FLOW ARROW
	REQ'D PVC CATCH BASIN ASSEMBLY (12" WITH NDS #1213 CAST IRON GRATE)
23.50	PROPOSED GRADE (TOP OF SIDEWALK/PAVEMENT)
23.50 / 23.00	TOP OF SIDEWALK / TOP OF PAVEMENT
24.00	FINISHED GRADE
23.1'	EXISTING GRADES
M.E.	MATCH EXISTING GRADE
V.I.F.	VERIFY IN FIELD

greenleaf architects apac
985.778.2080
designcollaboratedeliver

STATE OF LOUISIANA
JAMES E. PRAWELL, JR.
License No. 31993
PROFESSIONAL ENGINEER
CIVIL ENGINEERING

Revision No.	Date	Remarks
1	1/26/18	PERMIT SET
2	2/01/18	100% CONSTRUCTION SET

Sheet Name

PARTIAL GRADING PLAN

100% CONSTRUCTION SET

Kyle Associates, LLC
Planning, Engineering, and Landscape Architecture
638 Village Lane N. • Mandeville, LA 70471 • 985.727.9377

Job No.	17066	Sheet No.
Drawn By	MMM/NBZ	C1.1
Checked By	JEP	
Date	02.01.2018	

COPYRIGHT 2017, GREENLEAF LARSON ARCHITECTS, APAC