


REYES  
102 DAVIS DR.

CONCRETE

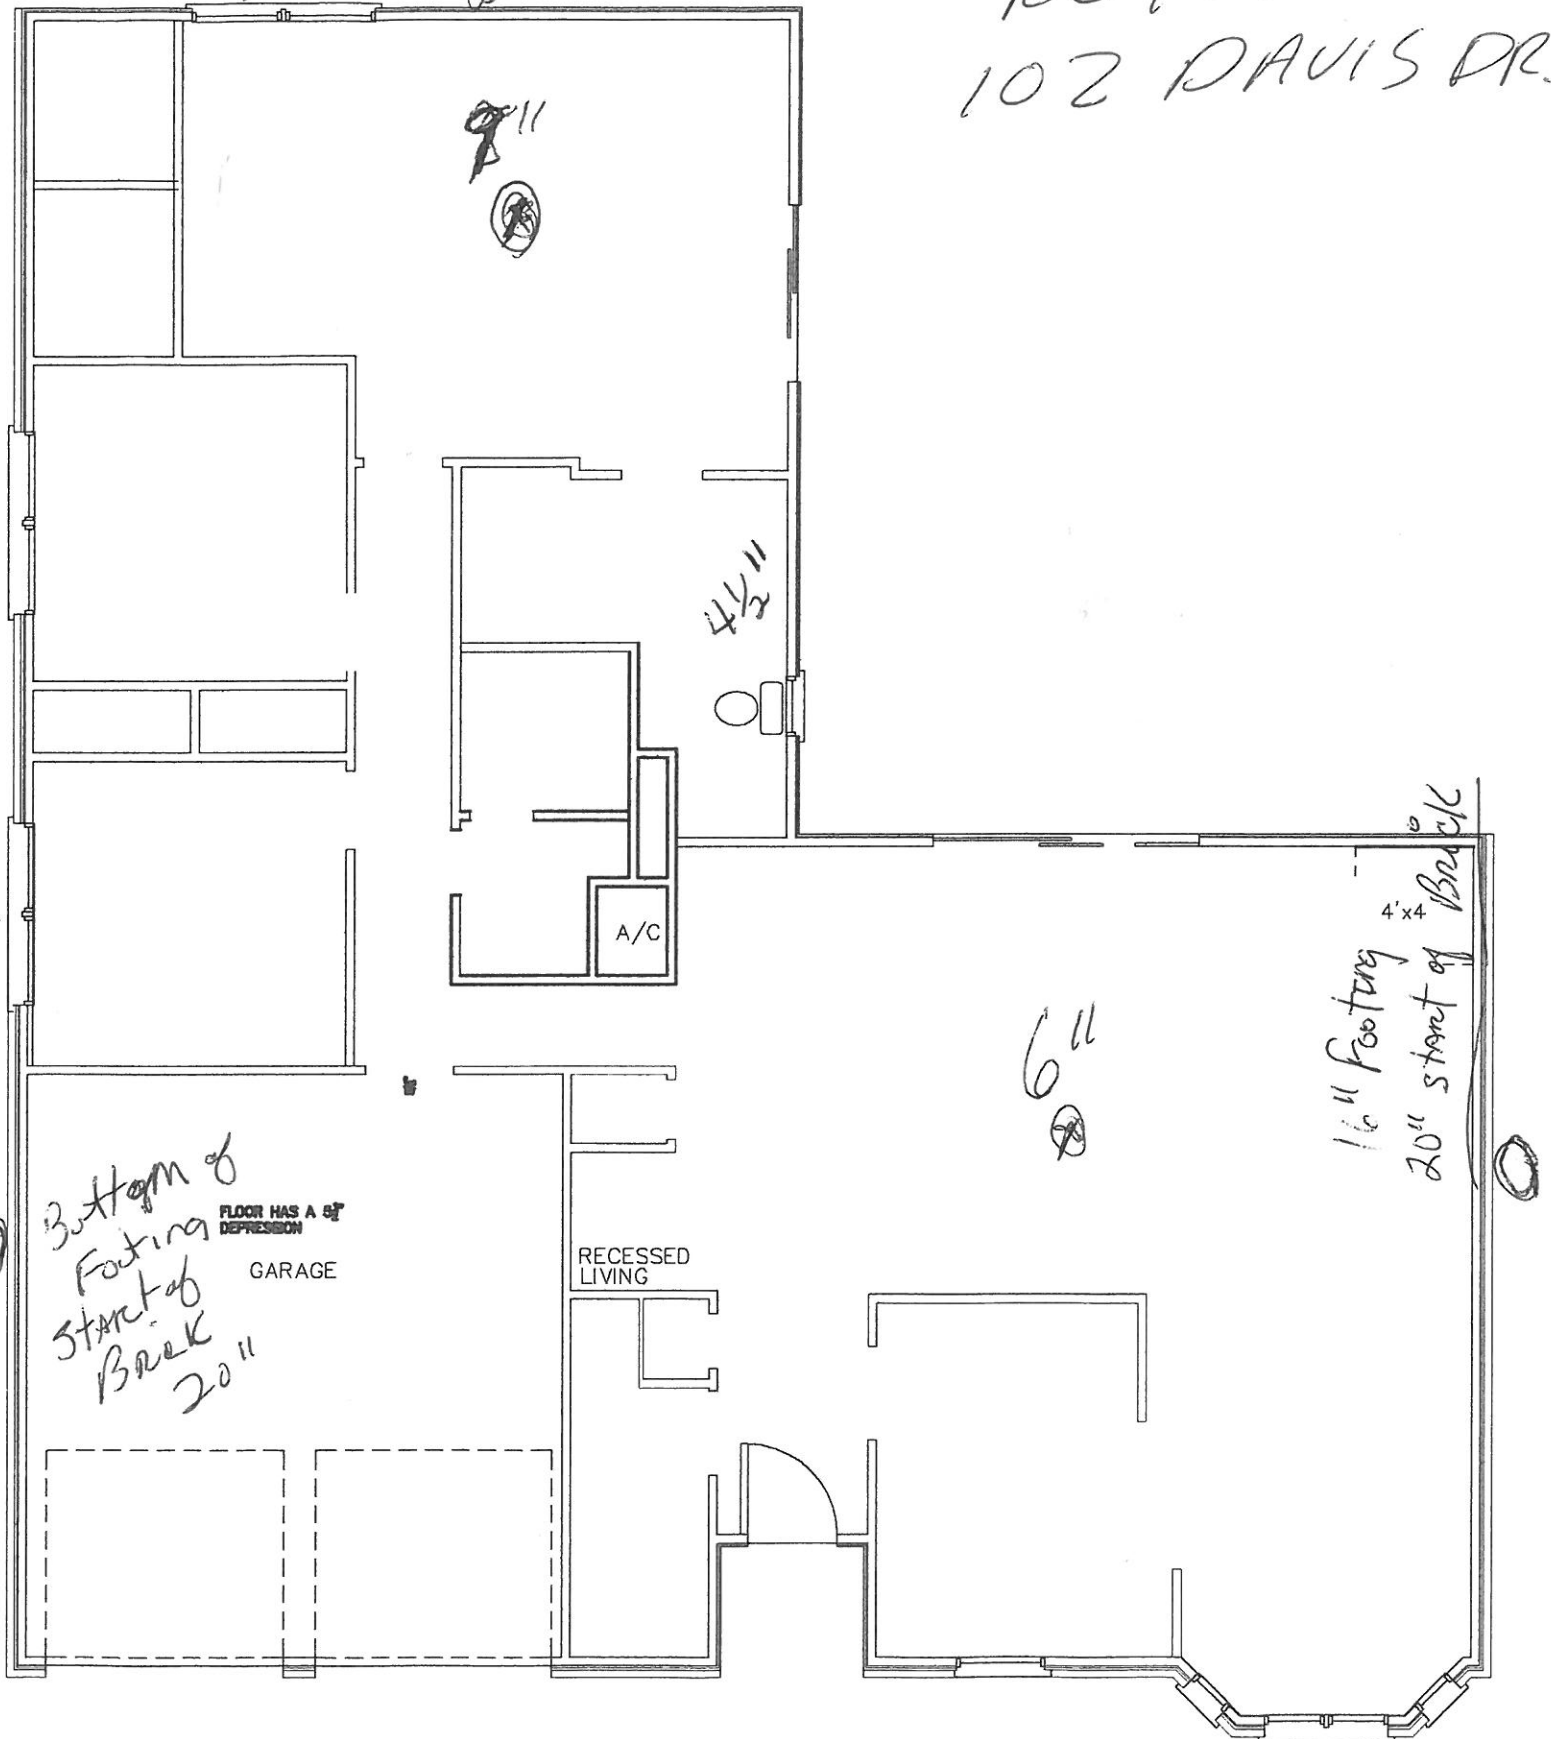

Bottom of Footing Start of BACK 20"

FLOOR HAS A 5" DEPRESSION  
GARAGE

RECESSED LIVING

A/C

4 1/2"

6 1/2"

4'x4' BACK  
16" Footing  
20" start of BACK