


Do you have a better looking window to put above Sink? Client was thinking orig. about a "Scalloped" window - Don't know what that would look like. wants it to be

A casement

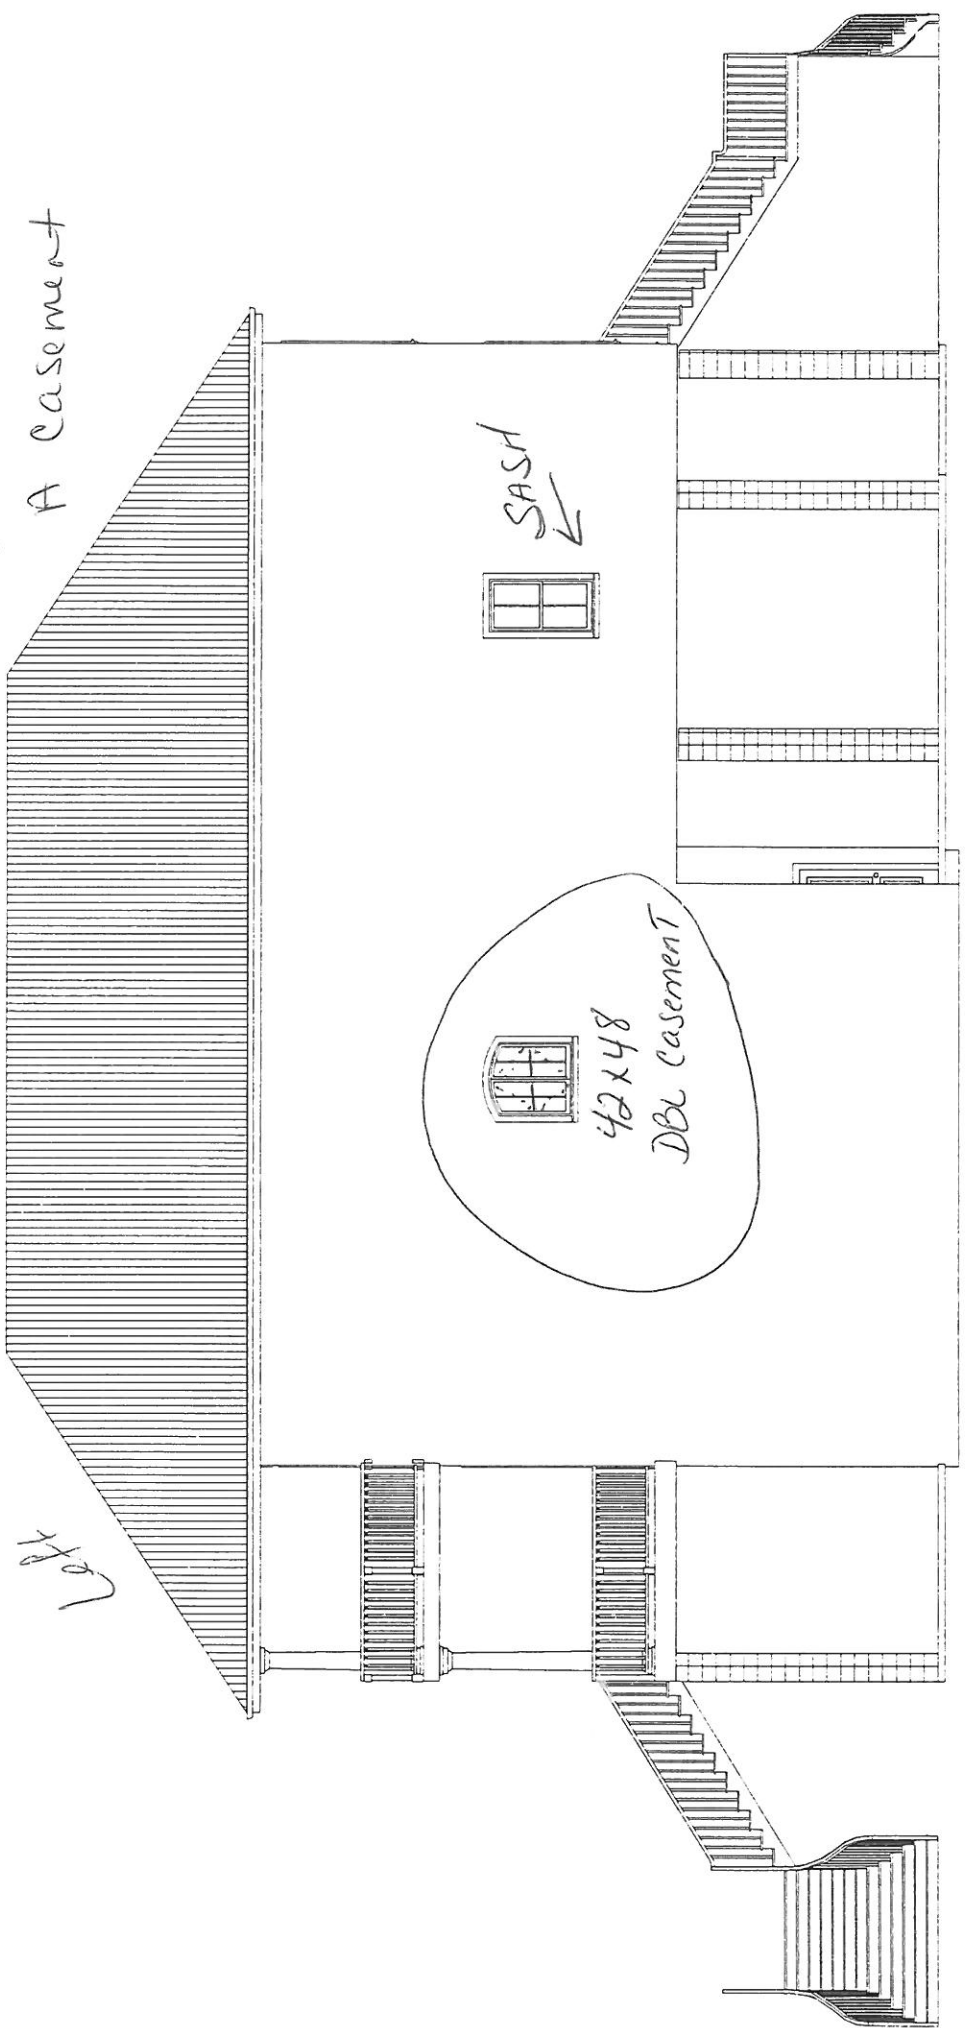


TO: Jason - 4 pgs TOTAL

From: Christy Sammel Engineering

FRONT



18x72 18x72 18x72

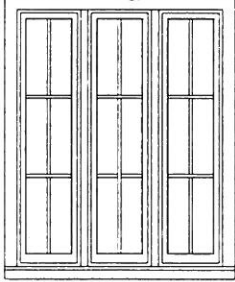

Casements











This Has to Be
A triple Because
of Space
Constraints.

36x72 Sash

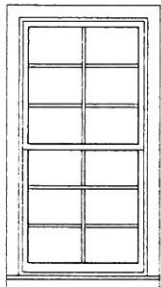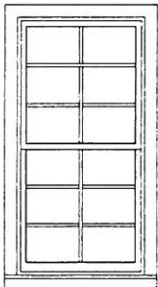

Door

Door

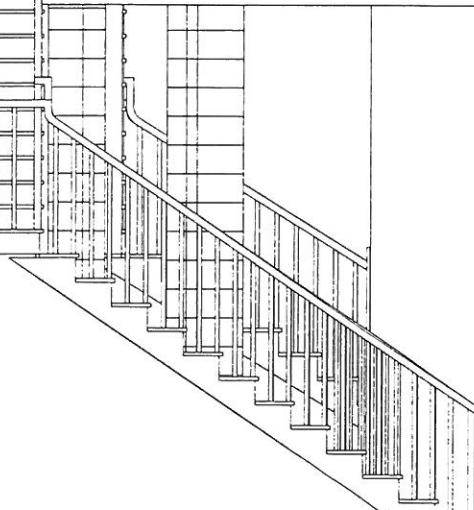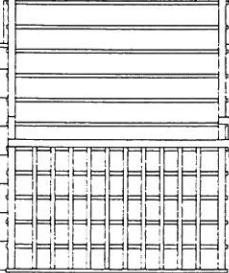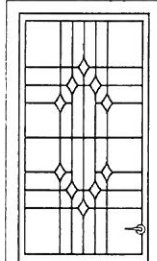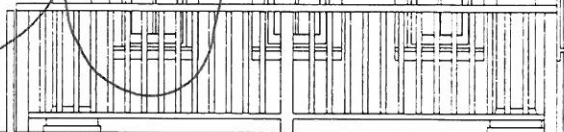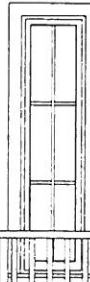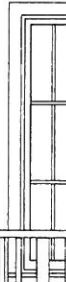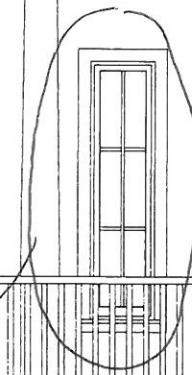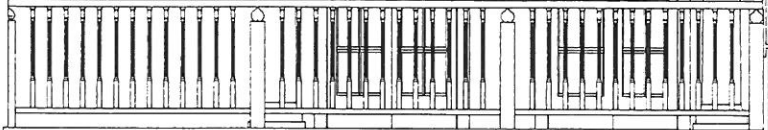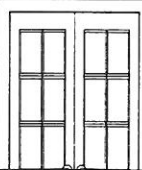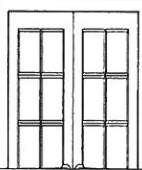

Client likes this
look on Windows
what could you
Suggest to give same
look on Sash Windows?





