


COPY

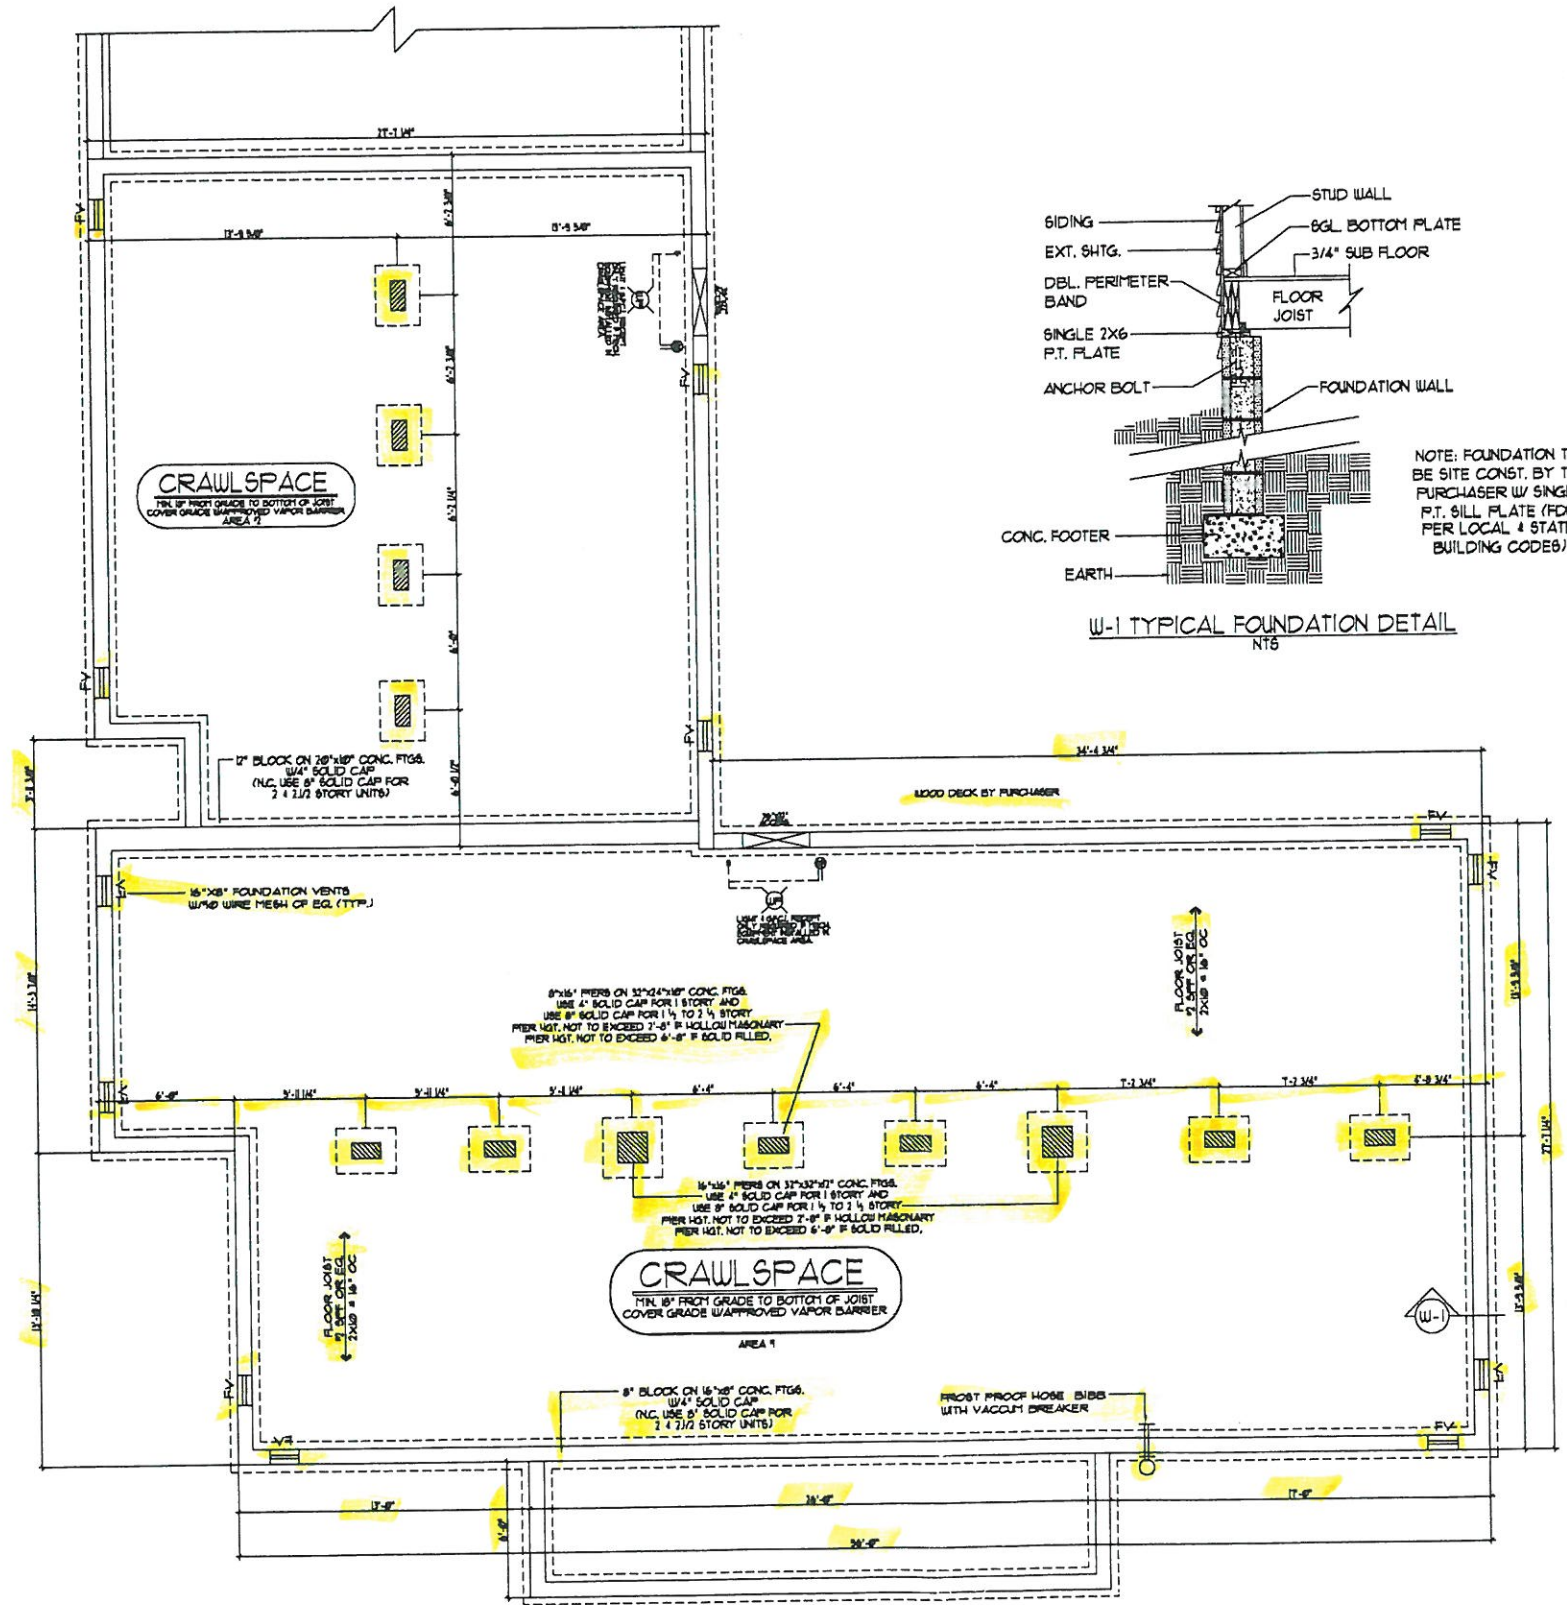

CRAWLSPACE FOUNDATION PLAN

SCALE: 3/16" = 1'-0"

CRAWLSPACE VENTILATION AREA 1	
VENTILATION BASED ON 1 SQFT. VENTILATION FOR EVERY 150 SQFT. OF AREA. CRAWLSPACE AREA TO BE COVERED WITH AN APPROVED VAPOR BARRIER TO ALLOW VENTILATION TO BE REDUCED TO 10% OF TOTAL REQUIRED (PER 1991 STD. BLDG. CODE SECT. 1604.6.2.1)	
150	SQFT. OF AREA
150	SQFT. VENT. REQ. W/ VAPOR BARRIER
15	SQFT. VENT. REQ. W/ VAPOR BARRIER
3.24	SQFT. VENT. PROVIDED
CRAWLSPACE VENTILATION AREA 2	
VENTILATION BASED ON 1 SQFT. VENTILATION FOR EVERY 150 SQFT. OF AREA. CRAWLSPACE AREA TO BE COVERED WITH AN APPROVED VAPOR BARRIER TO ALLOW VENTILATION TO BE REDUCED TO 10% OF TOTAL REQUIRED (PER 1991 STD. BLDG. CODE SECT. 1604.6.2.1)	
150	SQFT. OF AREA
150	SQFT. VENT. REQ. W/ VAPOR BARRIER
15	SQFT. VENT. REQ. W/ VAPOR BARRIER
3.24	SQFT. VENT. PROVIDED

NOTE: ONLY ONE HOUSE MAY BE BUILT UTILIZING THE PLANS THAT ARE DESIGNATED FOR THIS CONTRACT JOB





NATIONWIDE
 Custom Homes
 P.O. BOX 591 MARTINSVILLE, VA 24115
 1100 RIVES ROAD, MARTINSVILLE, VA 24115
 (716) 632-1100
 FAX (716) 632-1181
 WWW.NATIONWIDECUSTOMHOMES.COM

PLAN NAME: GLENHEAD	PURCHASER: COURSEALL COMMERCIAL	
COLLECTION/SERIES: STANDARD	JOB NO: 151-06	CONTRACT NO: 173
DESIGN DATE:	DES. BY:	CHK. BY: TA
REV. DATE:	REV. BY:	CHANGE ORDER DATE:
REV. DATE:	REV. BY:	PRODUCTION DATE:

PAGE NO.
OF

1/10/2017 10:54 AM 173-06-01

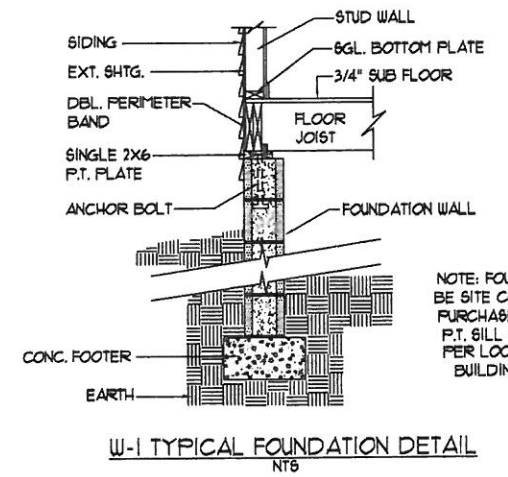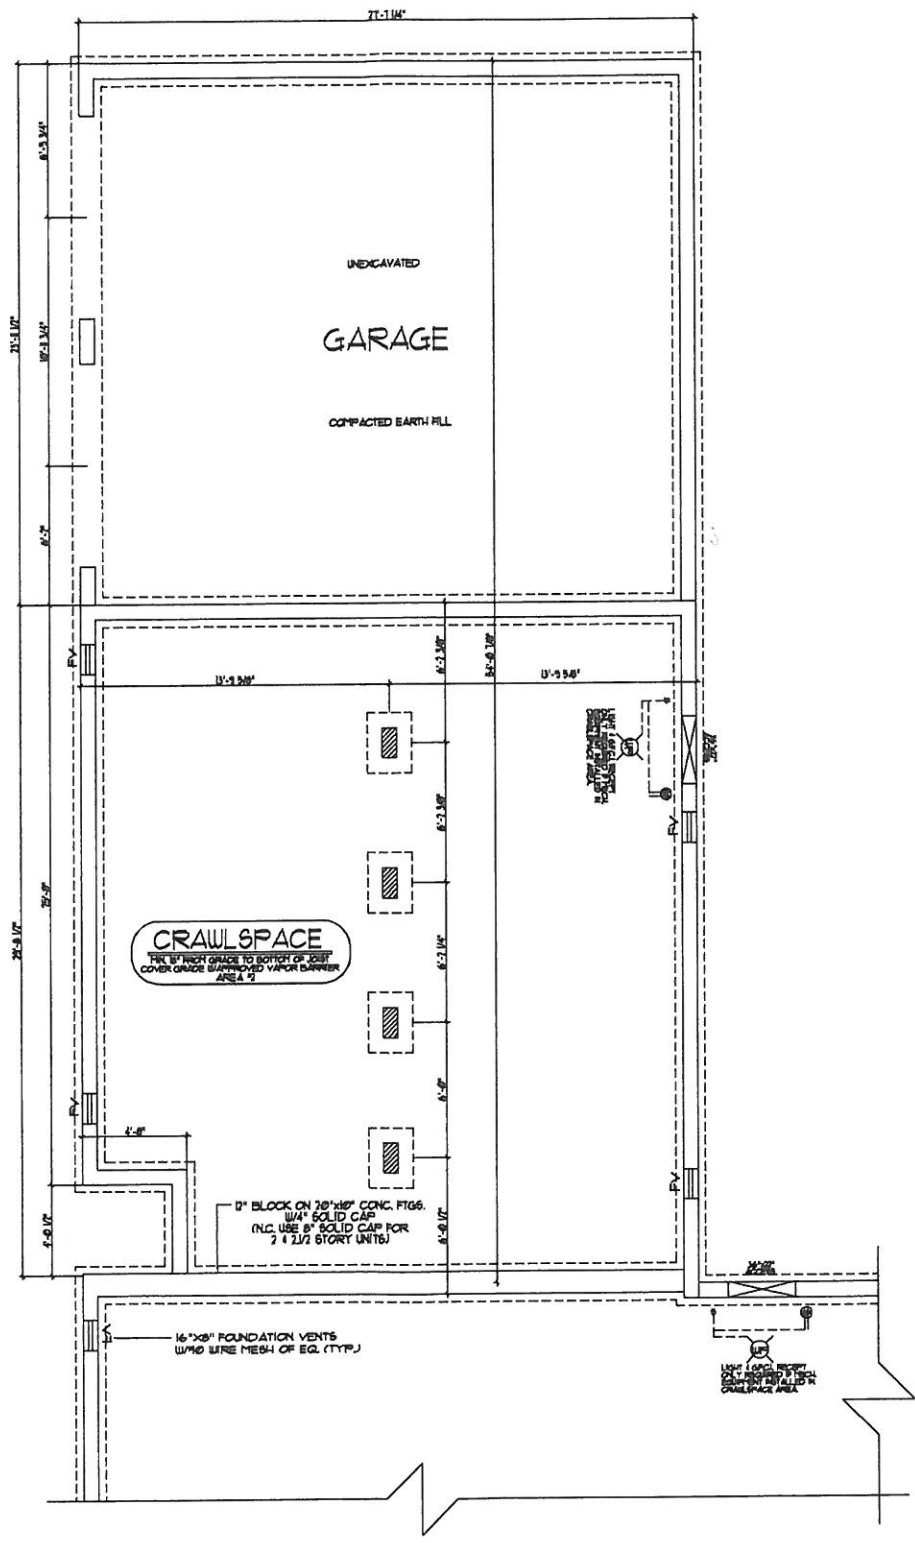

CRAWLSPACE FOUNDATION PLAN

SCALE: 3/16" = 1'-0"

NOTE: ONLY ONE HOUSE MAY BE BUILT UTILIZING THE PLANS THAT ARE DESIGNATED FOR THIS CONTRACT JOB




NATIONWIDE
Custom Homes
P.O. BOX 5511 MARTINSVILLE, VA. 24115
1000 RIVES ROAD, MARTINSVILLE, VA. 24115
(716) 637-1100
FAX (716) 632-1101
WWW.NATIONWIDECUSTOMHOMES.COM

PLAN NAME: GLENMEADOW			PURCHASER: COURSEAU COMMERCIAL		
COLLECTION/SERIES: STANDARD			JOB NO: 181-06 CONTRACT NO: 1793		
DESIGN DATE:	DWG. BY:	CHK. BY:	PROCESS DATE: 08/08/07	DWG. BY: MAR	CHK. BY: TA
REV. DATE:	REV. BY:		CHANGE ORDER DATE:		
REV. DATE:	REV. BY:		PRODUCTION DATE:	DWG. BY:	


PAGE NO.
OF

L:\06181\1793.dwg, 12 JULY 2007 10:05:00 AM, RFP352

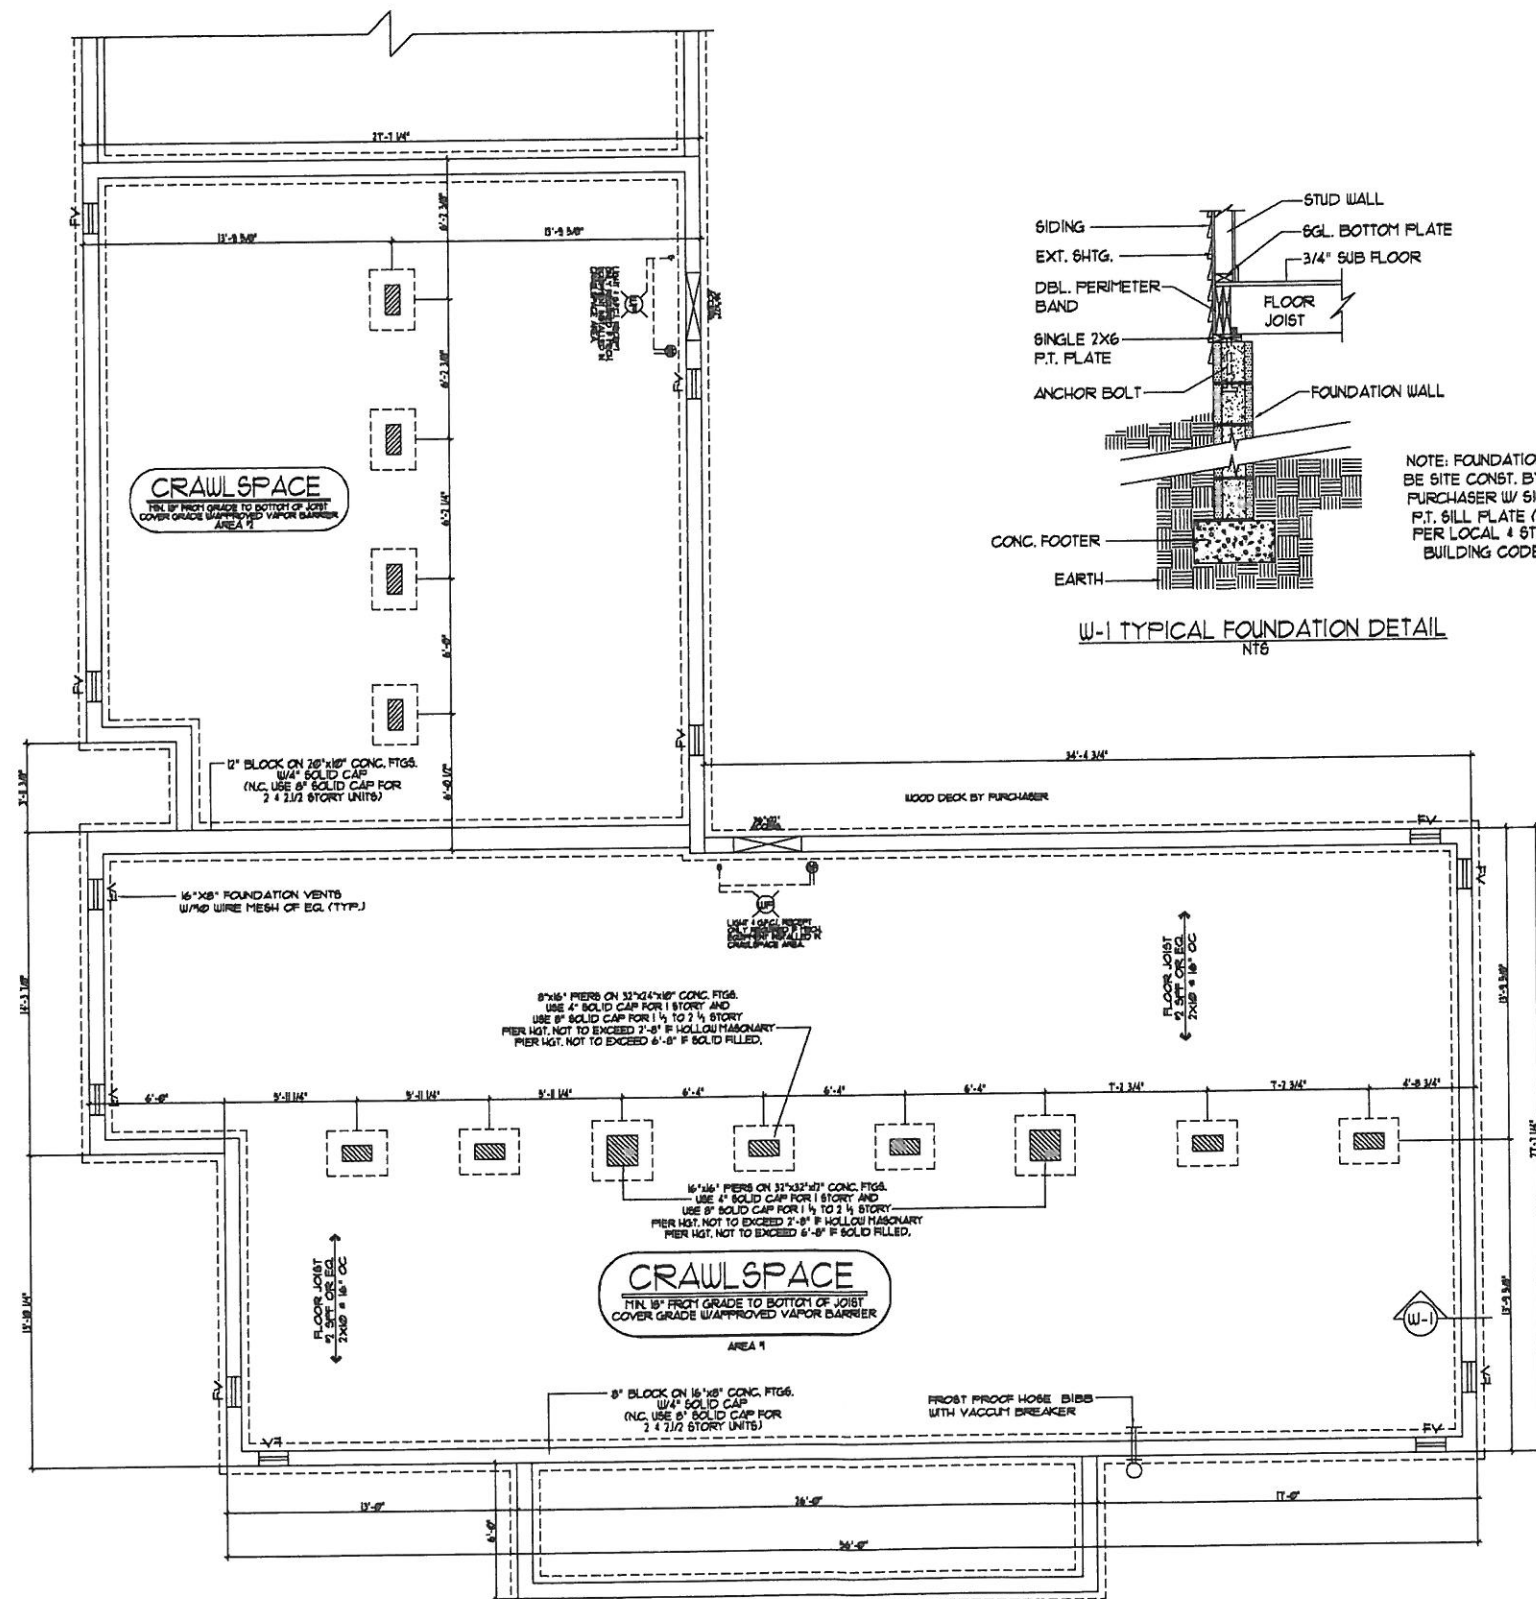

NOTE: FOUNDATION TO BE SITE CONST. BY THE PURCHASER W/ SINGLE P.T. SILL PLATE (FDN. PER LOCAL & STATE BUILDING CODES)

CRAWLSPACE VENTILATION AREA 1	
VENTILATION BASED ON 1 SQFT. VENTILATION FOR EVERY 150 SQFT. OF AREA. CRAWLSPACE AREA TO BE COVERED WITH AN APPROVED VAPOR BARRIER TO ALLOW VENTILATION TO BE REDUCED TO 10% OF TOTAL REQUIRED (PER 1991 BTD.BLDG.CODE 66CT.1804.6.2.1)	
181	SQFT. OF AREA
101	SQFT. VENT. REQU/W VAPOR BARRIER
101	SQFT. VENT. REQU/W VAPOR BARRIER
8	VENTS SHOWN (62 SQ. INCHES PER VENT)
3.44	SQFT. VENT. PROVIDED
CRAWLSPACE VENTILATION AREA 2	
VENTILATION BASED ON 1 SQFT. VENTILATION FOR EVERY 150 SQFT. OF AREA. CRAWLSPACE AREA TO BE COVERED WITH AN APPROVED VAPOR BARRIER TO ALLOW VENTILATION TO BE REDUCED TO 10% OF TOTAL REQUIRED (PER 1991 BTD.BLDG.CODE 66CT.1804.6.2.1)	
160	SQFT. OF AREA
3.21	SQFT. VENT. REQU/W VAPOR BARRIER
3.21	SQFT. VENT. REQU/W VAPOR BARRIER
4	VENTS SHOWN (62 SQ. INCHES PER VENT)
1.13	SQFT. VENT. PROVIDED

NOTE: ONLY ONE HOUSE MAY BE BUILT UTILIZING THE PLANS THAT ARE DESIGNATED FOR THIS CONTRACT JOB

NATIONWIDE
Custom Homes


P.O. BOX 591 MARTINSVILLE, VA. 24115
1100 RIVES ROAD, MARTINSVILLE, VA. 24115
(716) 632-1100
FAX (716) 632-1181
WWW.NATIONWIDECUSTOMHOMES.COM

PLAN NAME: GLENHEADOU	PURCHASER: COURSEAU COMMERCIAL	
COLLECTION/SERIES: STANDARD	JOB NO: 151-06	CONTRACT NO: 1759
DESIGN DATE:	DWG. BY:	CHK. BY:
REV. DATE:	REV. BY:	CHK. BY: TA
REV. DATE:	REV. BY:	CHANGE ORDER DATE:
	PRODUCTION DATE:	DWG. BY:

PAGE NO.
OF

J:\Customer\151\151-06\151-06.dwg, 11/20/07, 10:29:55 AM, 151-06.dwg

200'

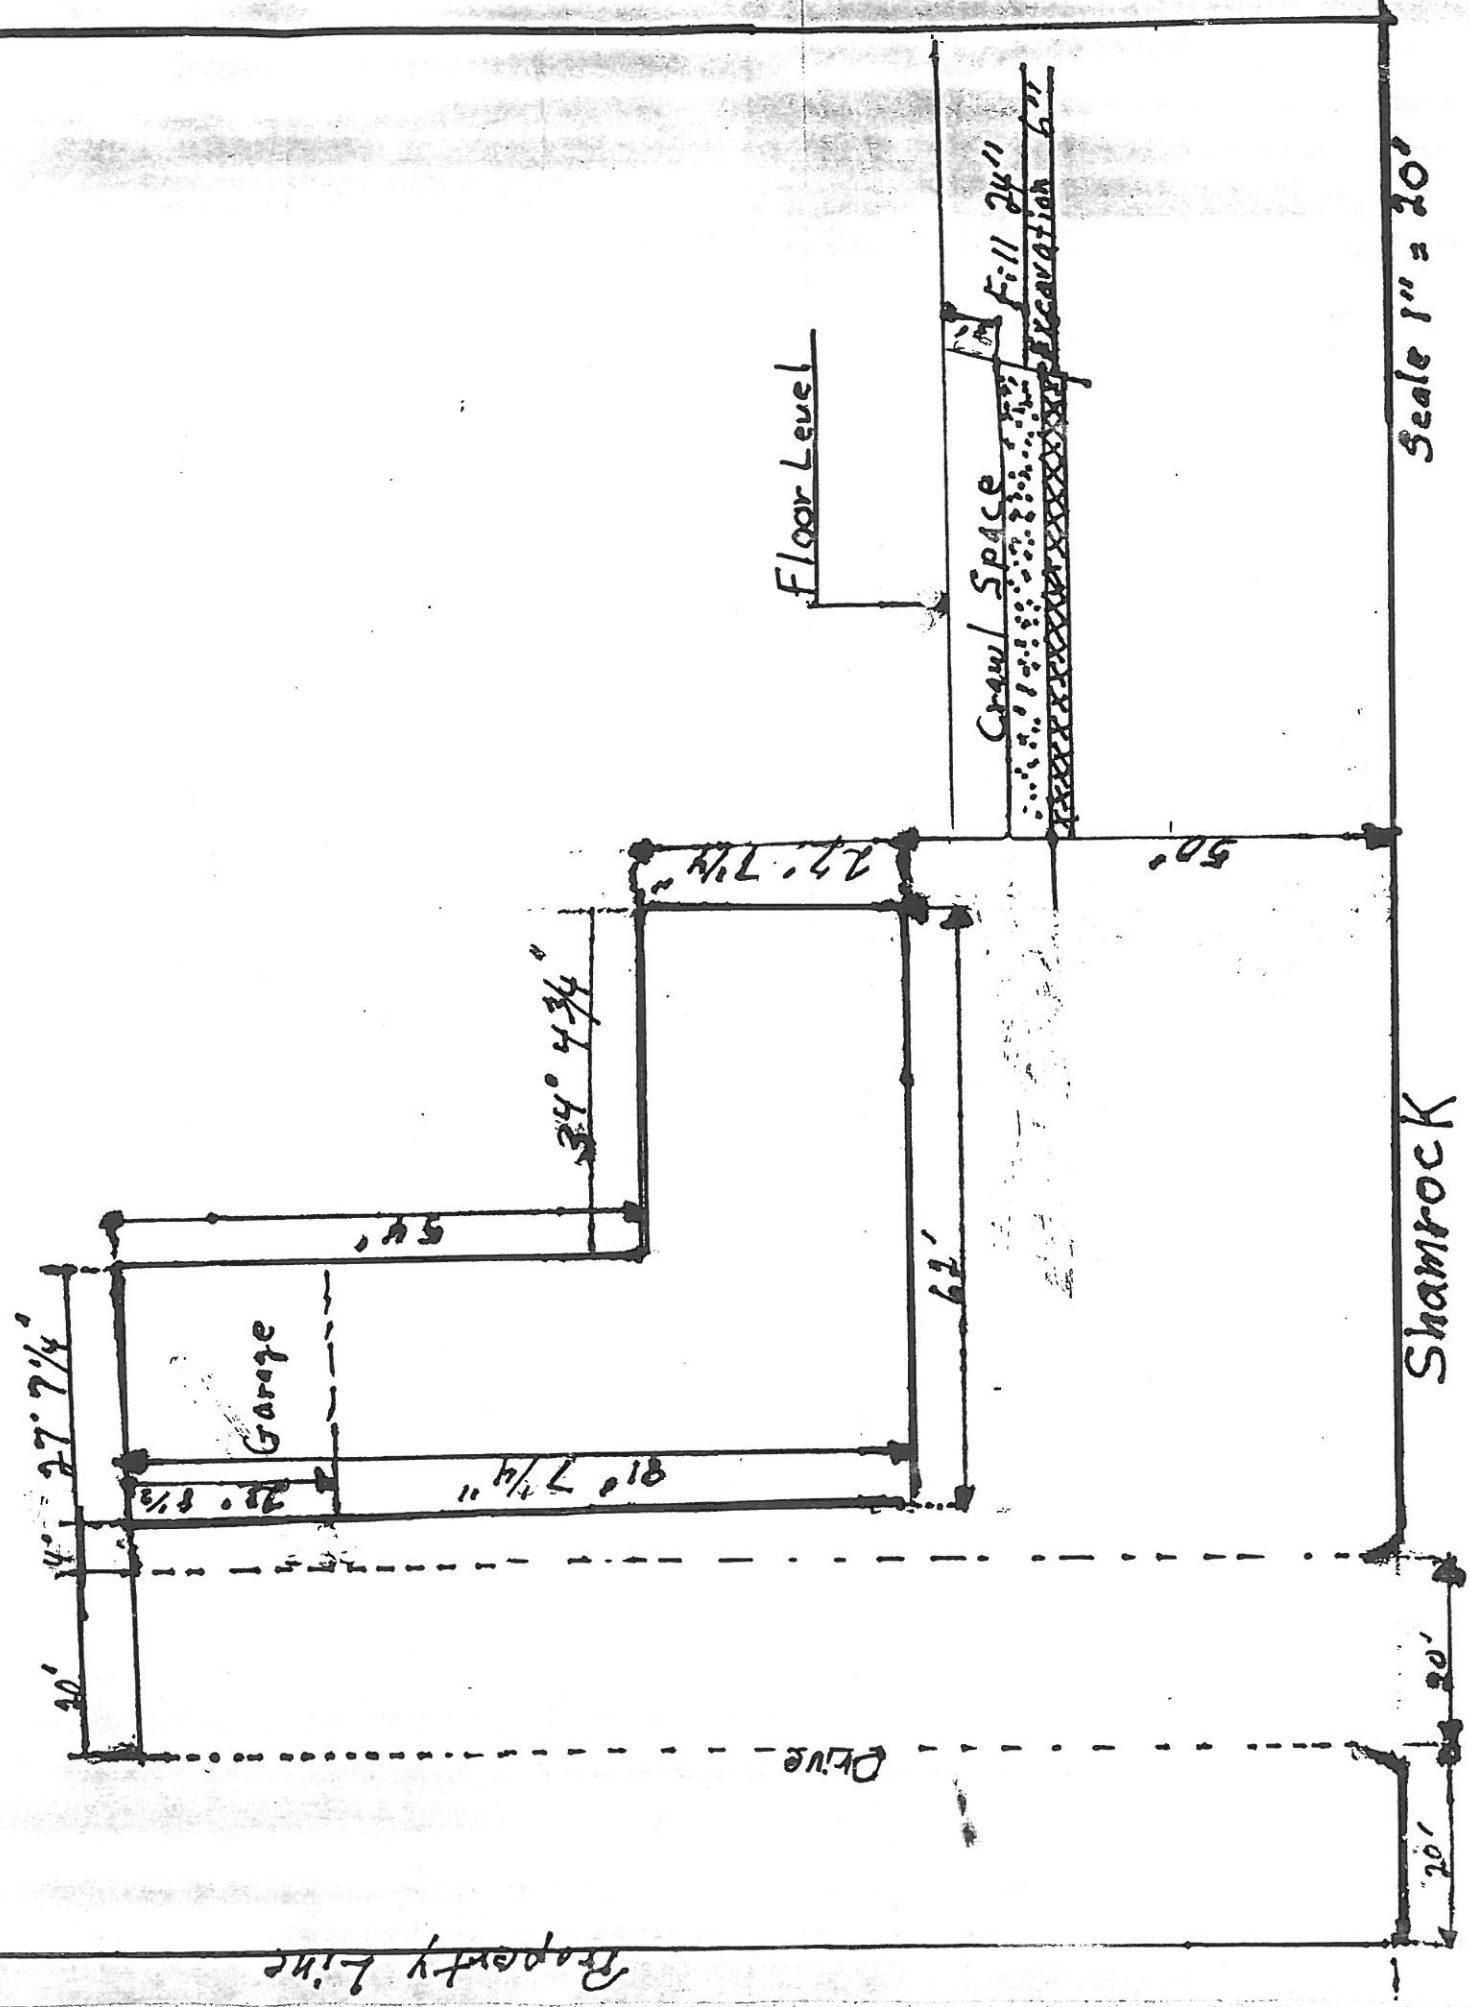

Scale 1" = 20'

Shamrock

Property Line

Driveway

Garage

Floor Level

Crawl Space

Excavation 62"

Fill 24"

27' 7/4"

54'

62'

27' 7/4"

20'

20'

20'

25' 8 1/2"

27' 7/4"