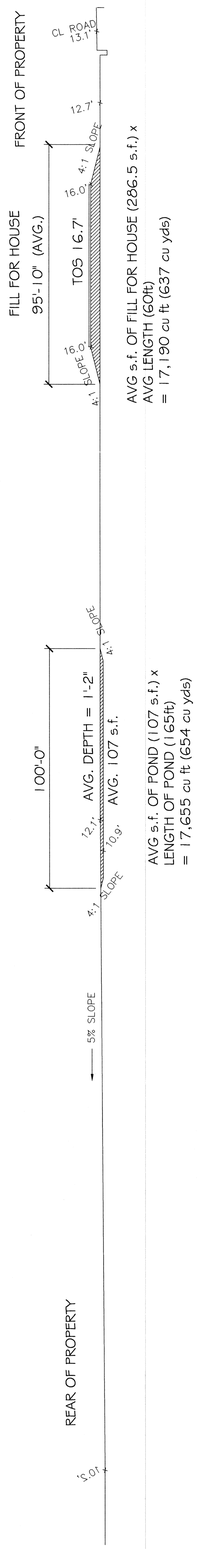

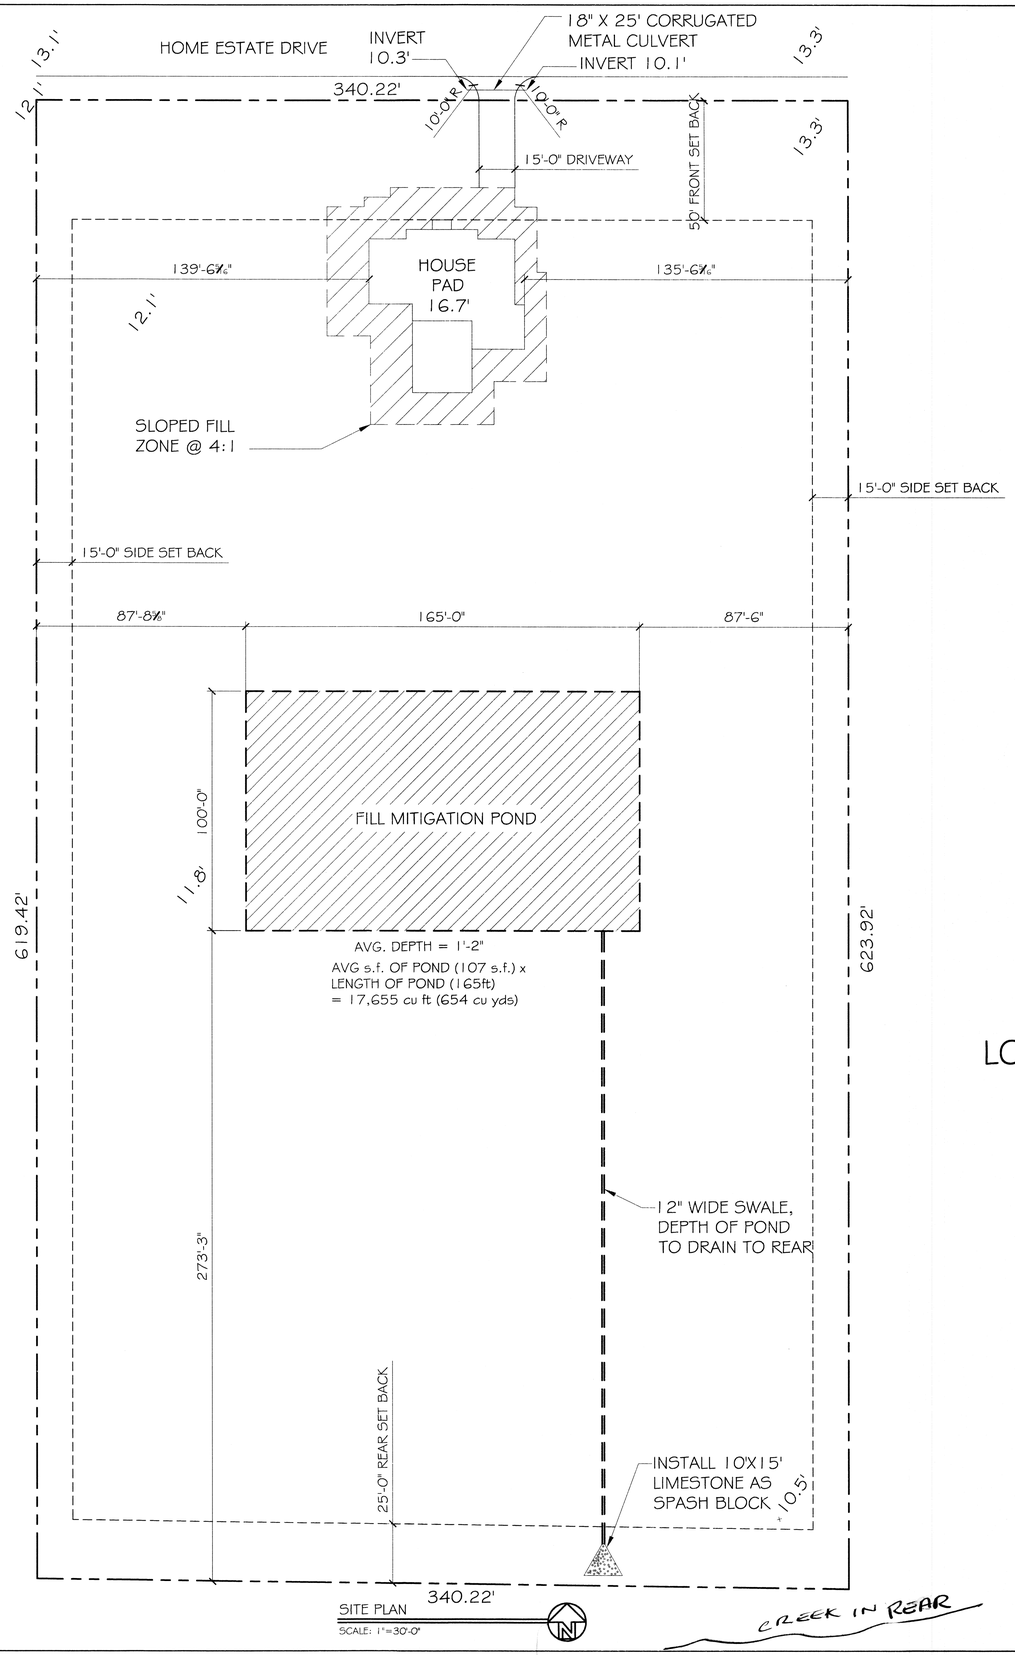

SITE PLAN
SCALE: 1"=30'-0"

LOT Q HOME ESTATES ACRES
ST.TAMMANY PARISH

SITE LEGEND
PROPERTY LINE
SETBACK MINIMUM

DAMMON ENGINEERING INC.
Architects & Engineers
dammoneng@bellsouth.net
PHONE: 985-649-5832
FAX: 985-641-5953
CHIEF ENGINEER: BRIAN MISTICH, P.E.
CHIEF ARCHITECT: KEVIN KINCHEN
554 OLD SPANISH TRAIL
SLIDELL, LA 70458

The above drawings and specifications, designs and ideas herein are the property of Dammon Engineering and are loaned for the use of the addressee for the specific project for which the fees have been paid. Reproduction or other use by others is prohibited without the express written consent of Dammon Engineering. Visual contact with these drawings and specifications shall constitute prima facie evidence of acceptance of these restrictions.

DUSTIN & RAVEN MAUKER
35562 HOME ESTATE DRIVE
SLIDELL, LOUISIANA 70460

JOB No:	2214
DATE:	07-02-2014
DRAWN BY:	CKD
CHECKED BY:	DPD

#	DESCRIPTION	DATE
REVISIONS		

STATE OF LOUISIANA
BRIAN A. MISTICH
License No. 32187
PROFESSIONAL ENGINEER
9/30/2014

SITE PLAN

SHEET No: 01 OF 01

C1