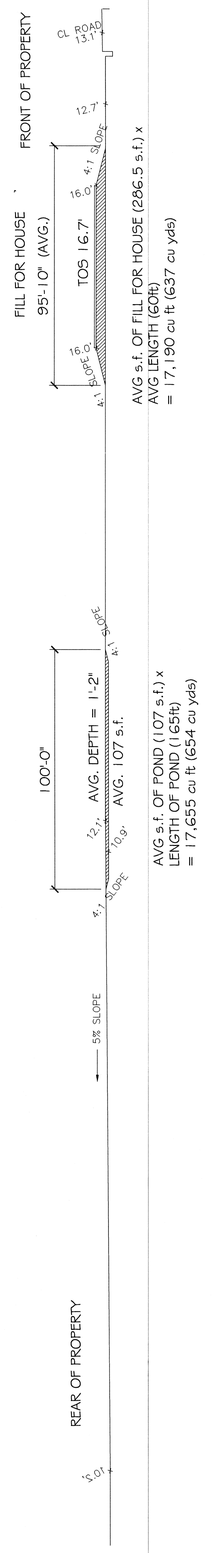

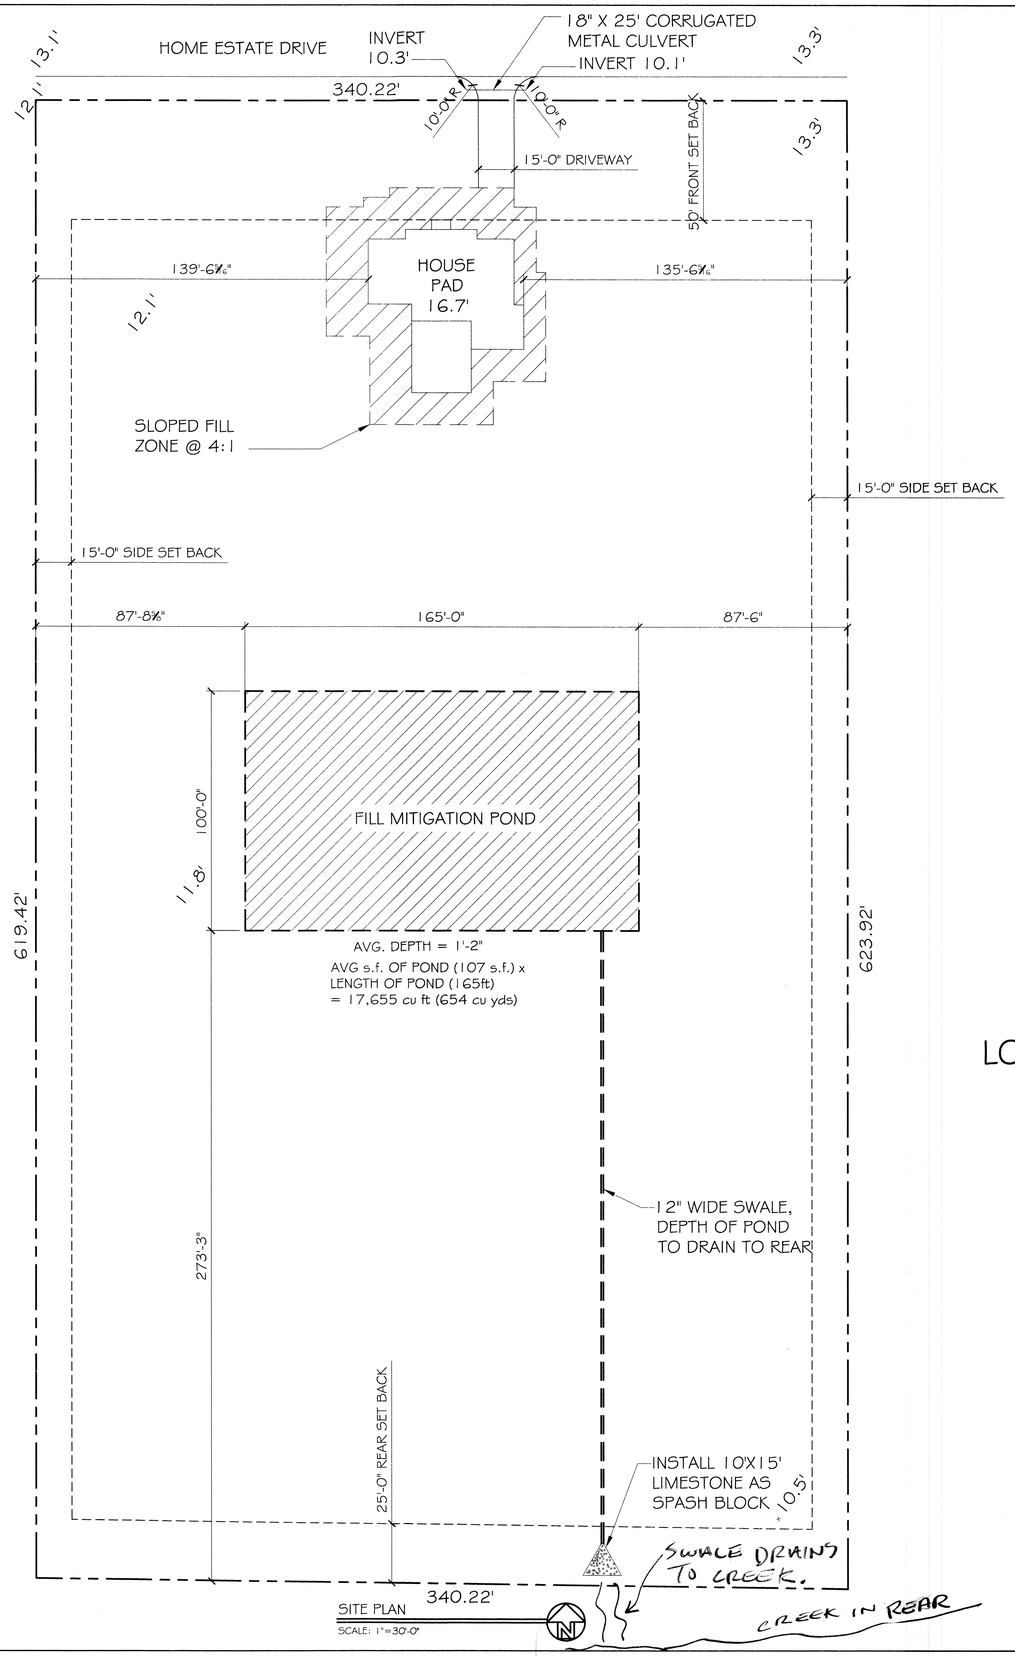

LOT Q HOME ESTATES ACRES
ST.TAMMANY PARISH

SITE LEGEND

PROPERTY LINE

SETBACK MINIMUM

DAMMON ENGINEERING, INC.
Architects & Engineers
dammoneng@bellsouth.net
PHONE: 985-649-5832
FAX: 985-641-5950
CHIEF ENGINEER: BRIAN MISTICH, P.E.
CHIEF ARCHITECT: KEVIN KINCHEN
554 OLD SPANISH TRAIL
SLIDELL, LA 70458

The above drawings and specifications, designs and ideas herein are the property of Dammon Engineering and remain this property of Dammon Engineering, and no copies of them shall be made or reproduced in any form or used in connection with any work or project other than the specified project for which they have been prepared and developed without written consent of Dammon Engineering. Visual contact with these drawings or specifications shall constitute conclusive evidence of acceptance of these restrictions.

DUSTIN & RAVEN MAUKER
35562 HOME ESTATE DRIVE
SLIDELL, LOUISIANA 70460

JOB No: 2214 | DATE: 07-02-2014

DRAWN BY: CKD | CHECKED BY: DPD

#	DESCRIPTION	DATE

REVISIONS

STATE OF LOUISIANA
BRIAN A. MISTICH
License No. 30487
Professional Engineer
9/30/2014

SITE PLAN

SHEET No: 01 OF 01

C1