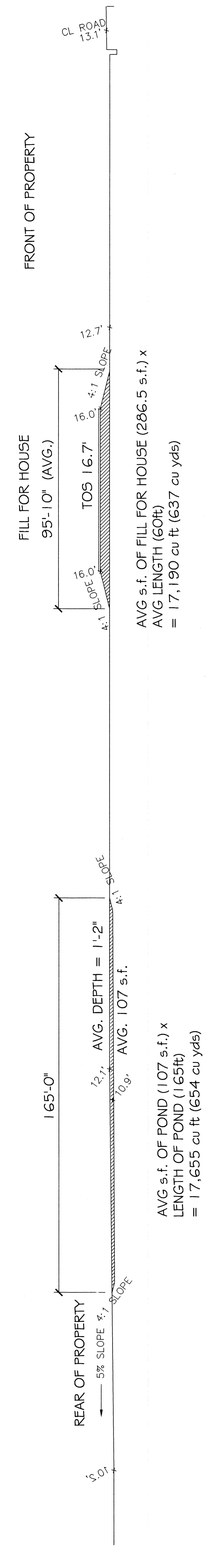

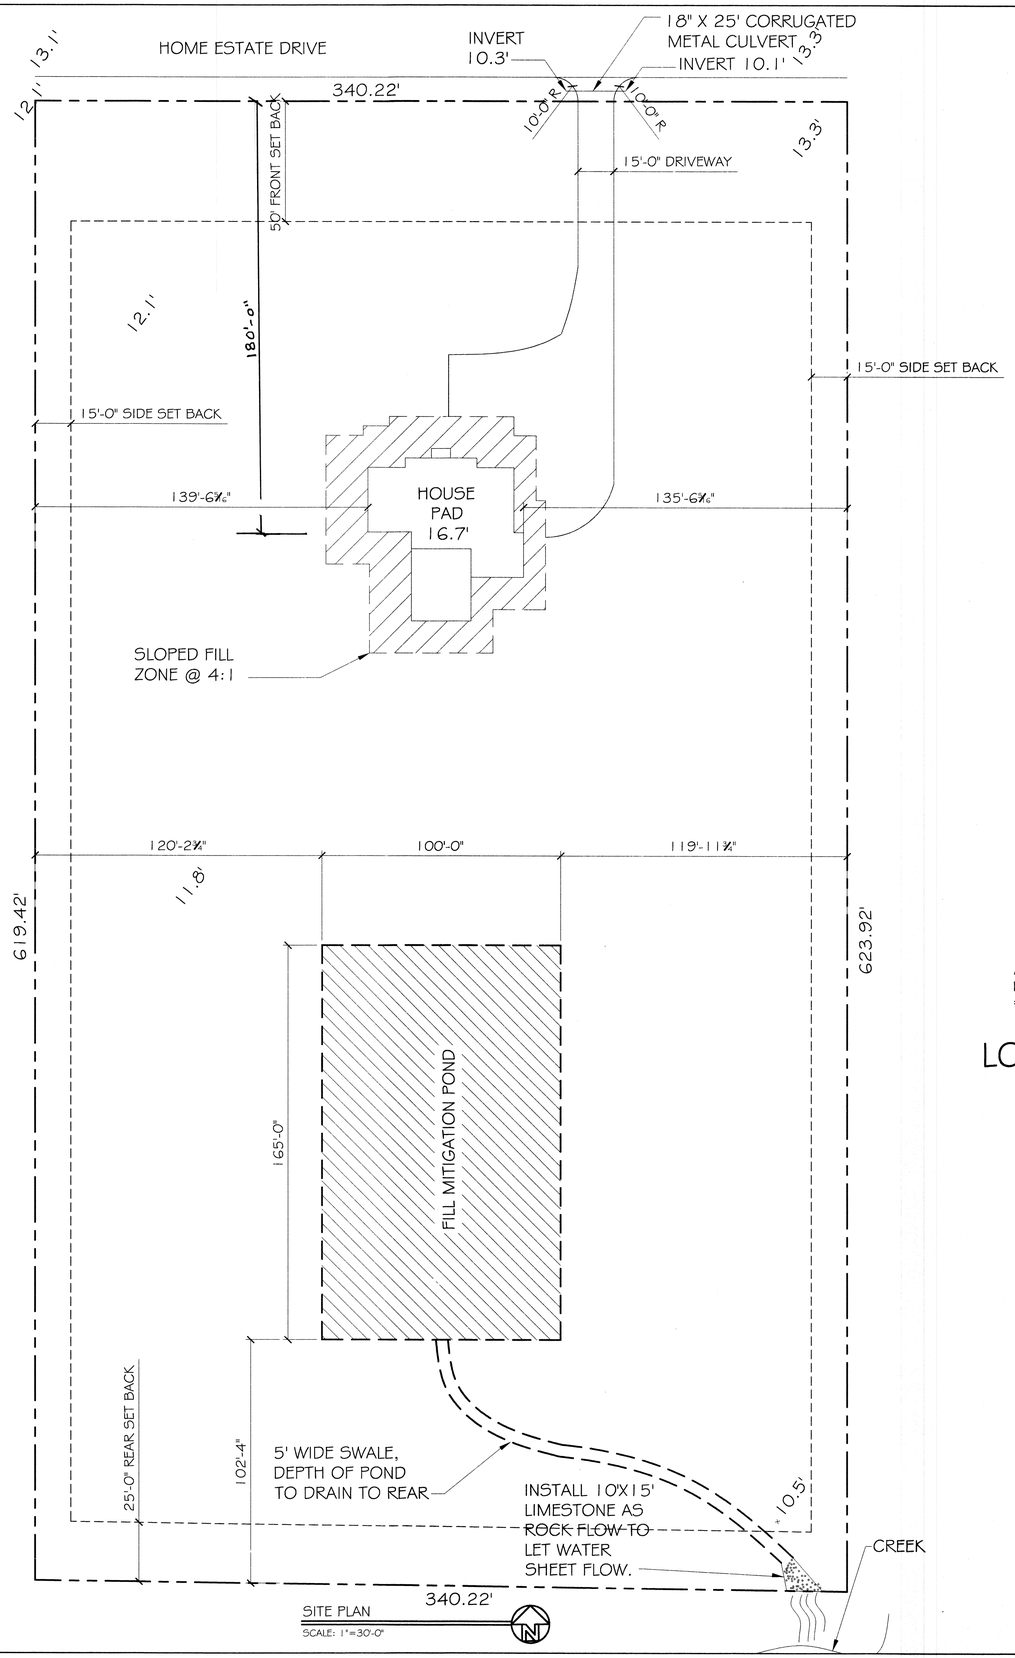

SITE PLAN
SCALE: 1"=30'-0"

AVG. DEPTH = 1'-2"
AVG s.f. OF POND (107 s.f.) x
LENGTH OF POND (165ft)
= 17,655 cu ft (654 cu yds)

LOT Q HOME ESTATES ACRES
ST.TAMMANY PARISH

SITE LEGEND
PROPERTY LINE
SETBACK MINIMUM

DAMMON ENGINEERING, INC.
Architects & Engineers
CHIEF ENGINEER: BRIAN MISTICH, P.E.
CHIEF ARCHITECT: KEVIN KINCHEN
534 ROLLING SPANISH TRAIL
SLIDELL, LA 70458
dammoneng@bellsouth.net
PHONE: 985-649-5832
FAX: 985-641-5950

DUSTIN & RAVEN MAURER
35562 HOME ESTATE DRIVE
SLIDELL, LOUISIANA 70460

JOB No:	2214	DATE: 10-03-2014
DRAWN BY:	CKD	CHECKED BY: DPD

The above drawings and specifications, designs and arrangements represented thereby are and shall remain the property of Dammon Engineering, Inc. and no part of or copies of the drawings or specifications thereof may be used in any way, place or purpose other than those for which they are specifically prepared and delivered, and shall not be copied, reproduced and distributed without written consent of Dammon Engineering, Inc. Visual contact with these drawings or specifications shall constitute conclusive evidence of acceptance of these restrictions.

#	DESCRIPTION	DATE
	RELOCATED POND AND PAD	10-16-14

REVISIONS

STATE OF LOUISIANA
BRIAN A. MISTICH
License No. 30187
PROFESSIONAL ENGINEER
10/16/2014

SITE PLAN

SHEET No: 01 OF 01

C1