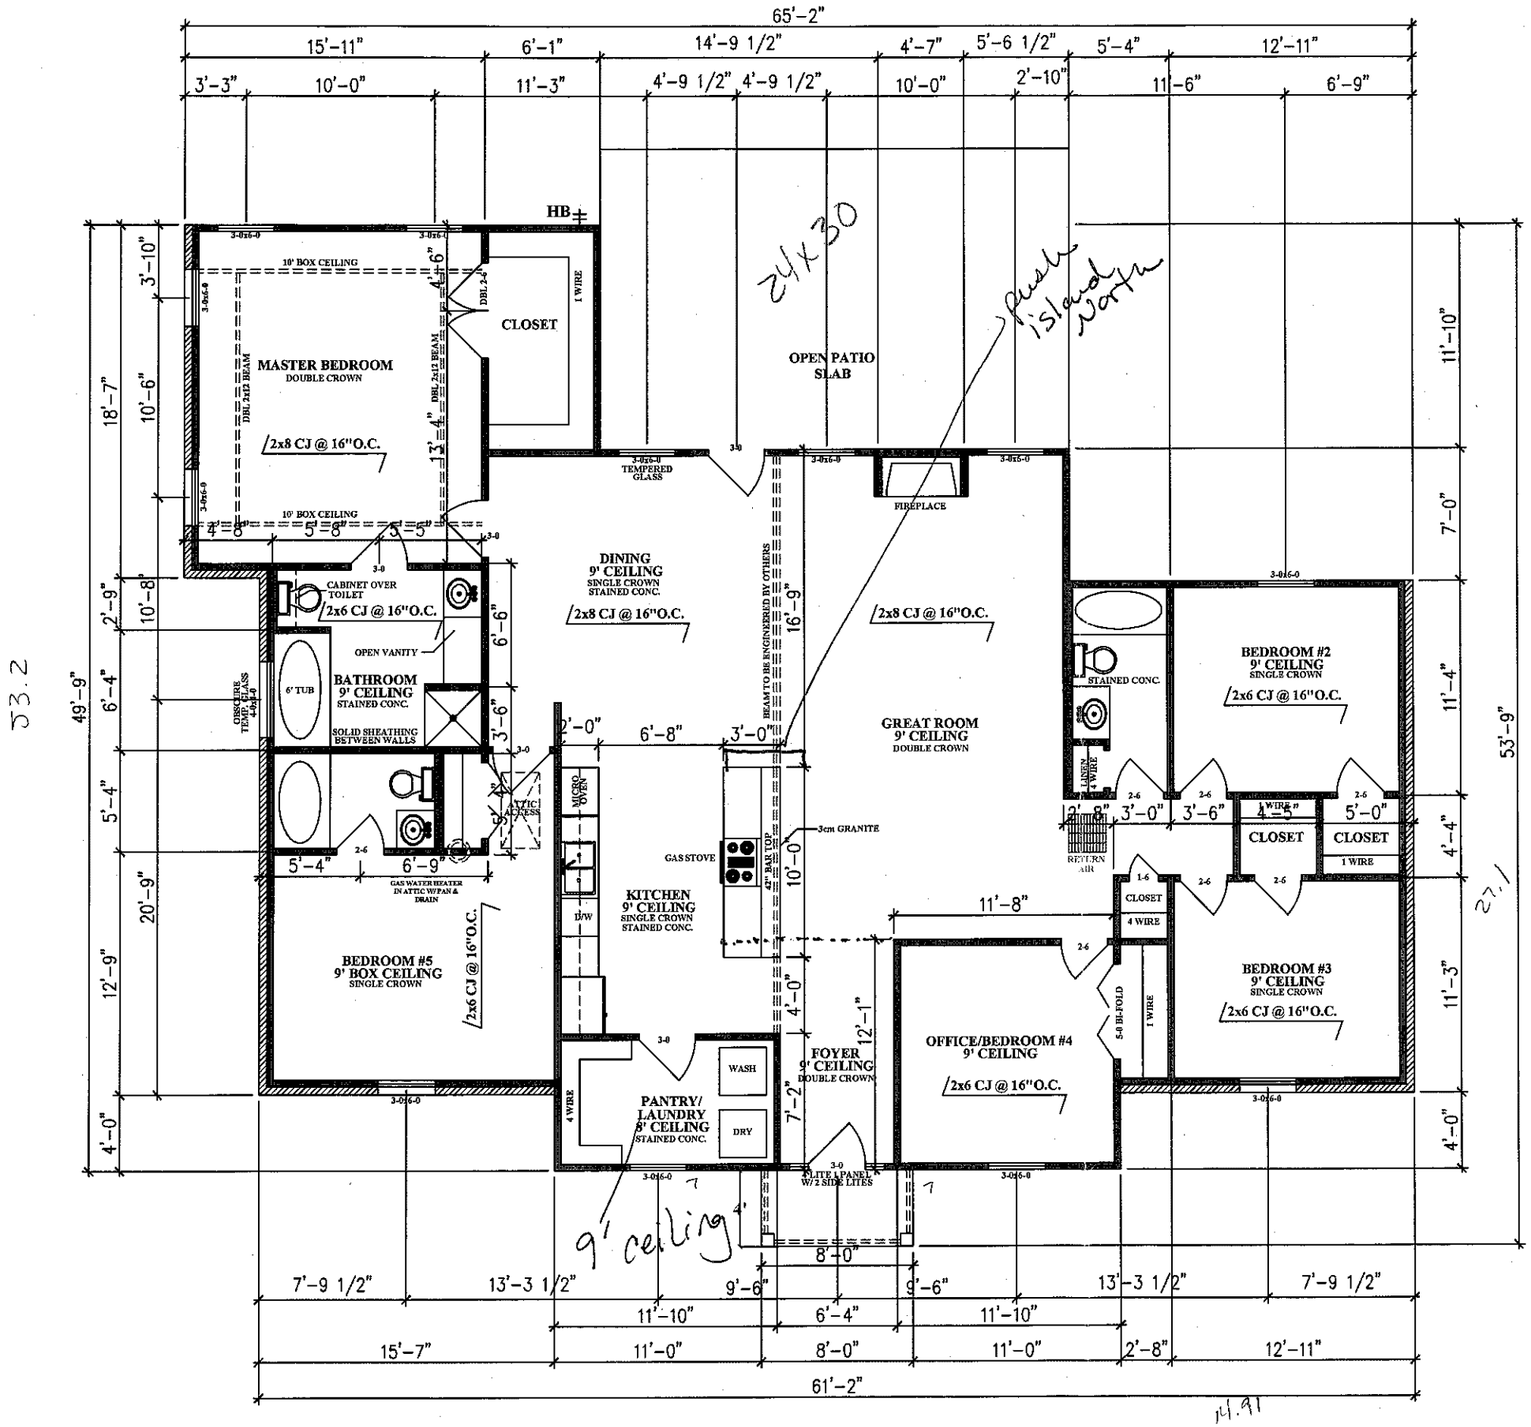

FLOOR PLAN

53.2

NOTES:
9' CEILING HEIGHT THROUGHOUT
10' CEILING HEIGHT IN MASTER BEDROOM
EXTERIOR OUTLETS TO BE GFI PROTECTED
110v SMOKE ALARMS
CONDUIT 6" UNDER SLAB (POWER TO ISLAND
GRANITE COUNTER TOPS THROUGHOUT
36" FIREPLACE
STAINED CONCRETE FLOORS
RETURN AIR UNITS & WATER HEATERS TO HAVE MIN.
2'-0" DECKING IN EACH DIRECTION FOR WORK AREA.
TALL TOILETS
NO BEVELED GLASS ON MASTER SHOWER DOOR

23x5 frt. porch → #3089
Raised 8' = #38,987

FINAL SET

APPROVALS:

PURCHASER: DATE

PURCHASER: DATE

DATE

LIVING AREA	2354 SQ FT
FRT PORCH	32 SQ FT
TOTAL SQ. FT.	2386 SQ FT

Cretin Homes
18300 S. I-12 Service Rd.
Ponchatoula, LA 70454
(985) 419-9883

SCALE: 1/8"=1'
DATE: 5/15/2014

RESIDENCE FOR:
Maurer Residence
35562 Home Estate Drive
Slidell, LA 70460

(St. Tammany Parish)
JOB NUMBER:
DRAWN BY: Jeff Albarez
SHEET NUMBER: