


20
19

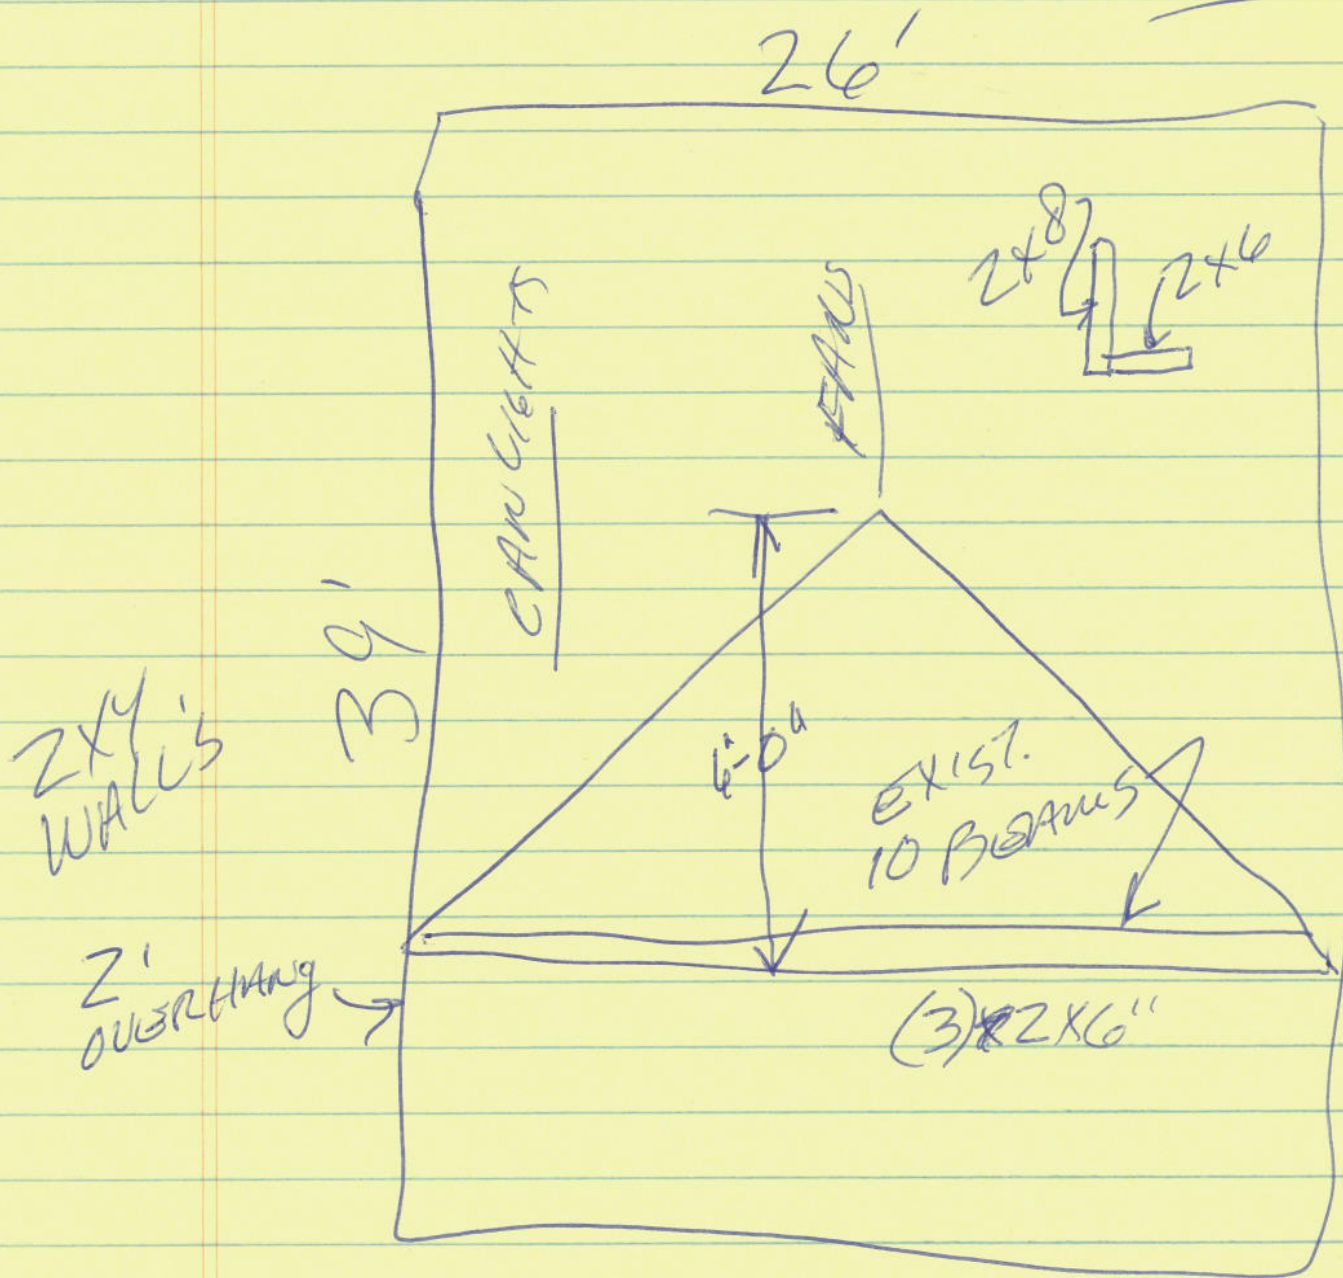

REMOVE EXIST LIGHTS & BEAMS
INSTALL NEW CAN LIGHTS