


UPPER STAIRS
DOWN



↑
USBL5M@Yahoo.com

Huko Ct.
Craig Bergeron
DIAMOND HEAD MS 39525
(985)7680075

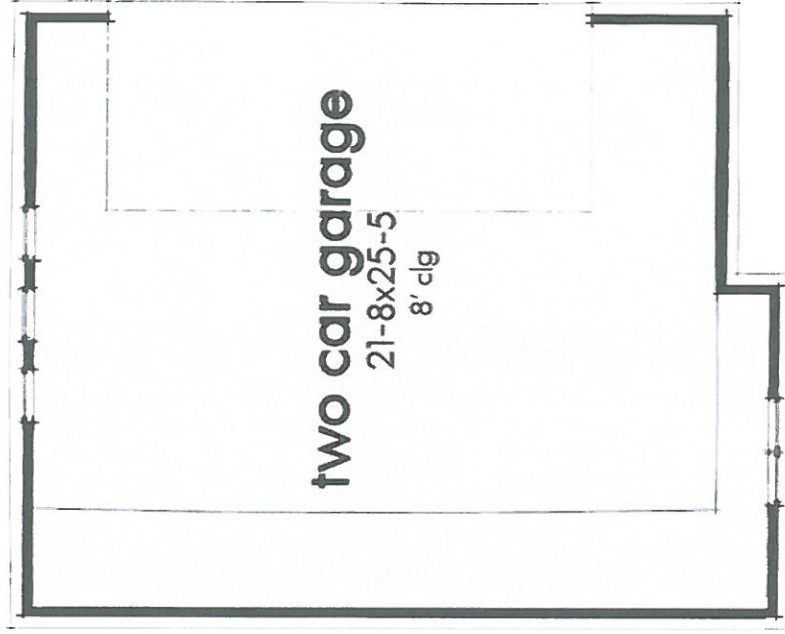

Do

UPDATE


10' ceiling



two car garage

21-8x25-5

8' clg

24x20

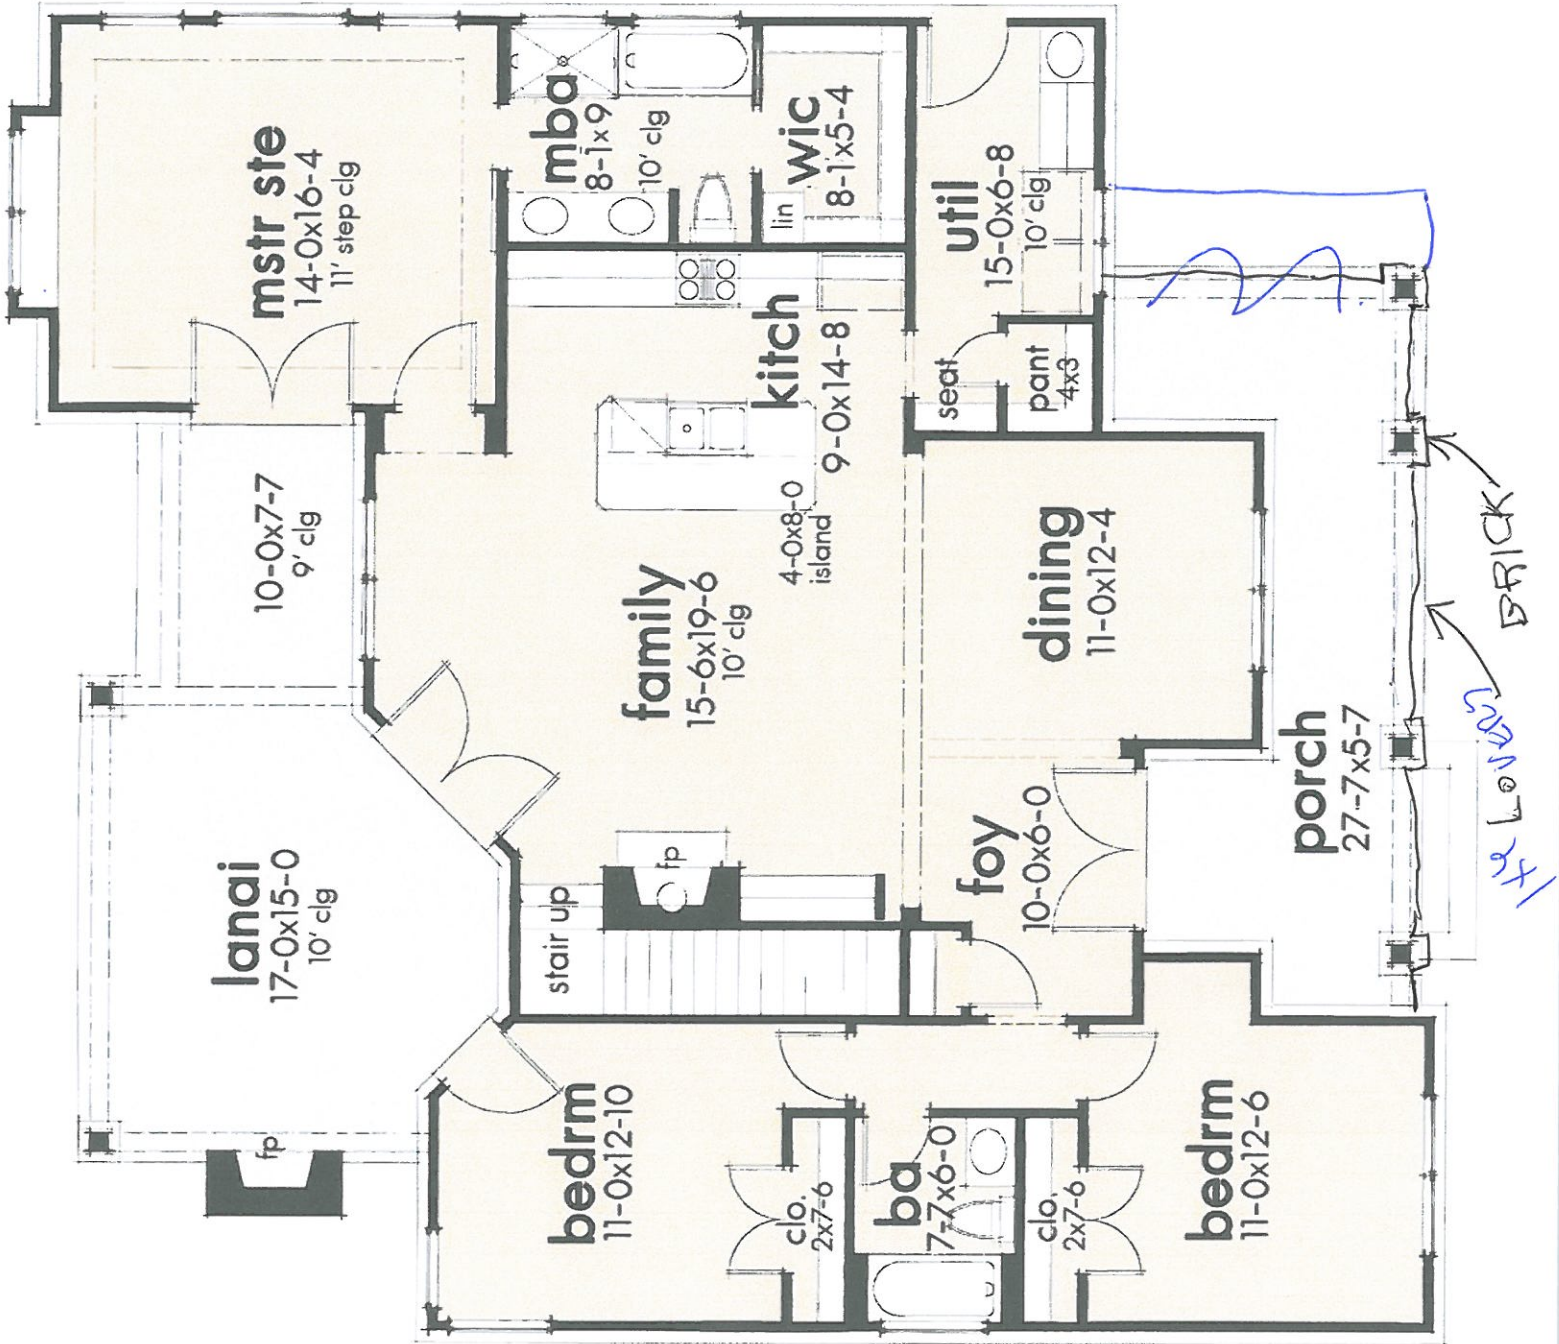

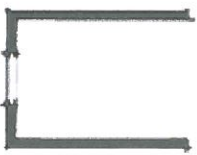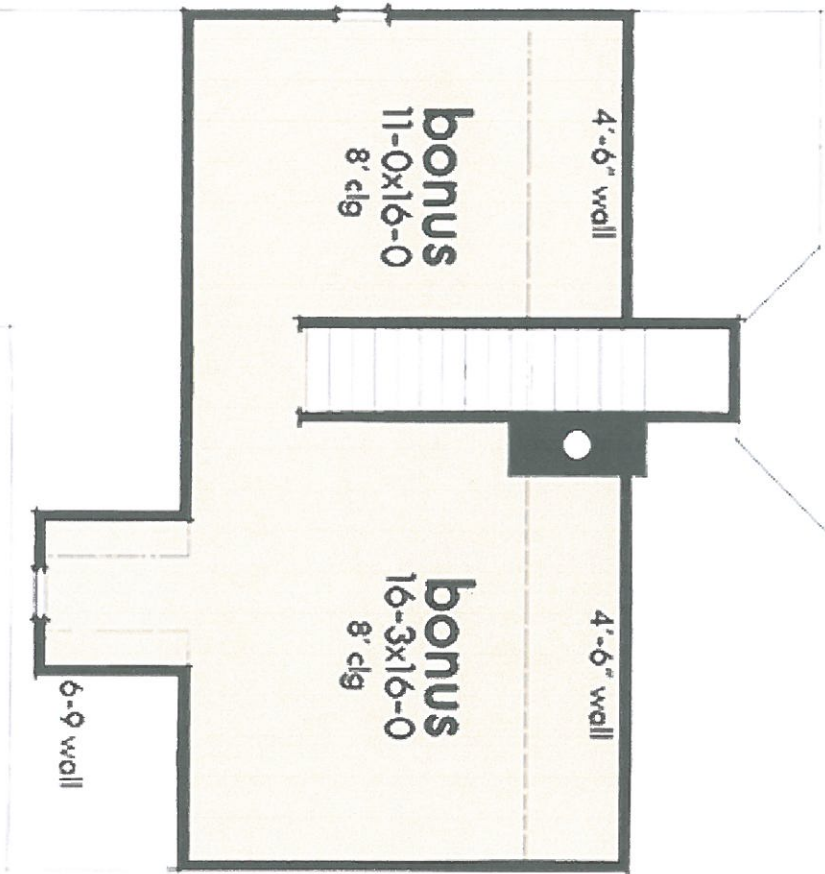

second floor plan







FLUSH




AD Plan 16853WG built in North Carolina
ArchitecturalDesigns.com

DUAL RADIUS TOP DOORS

OMIT



 Plan 16853WG built in Georgia
ArchitecturalDesigns.com

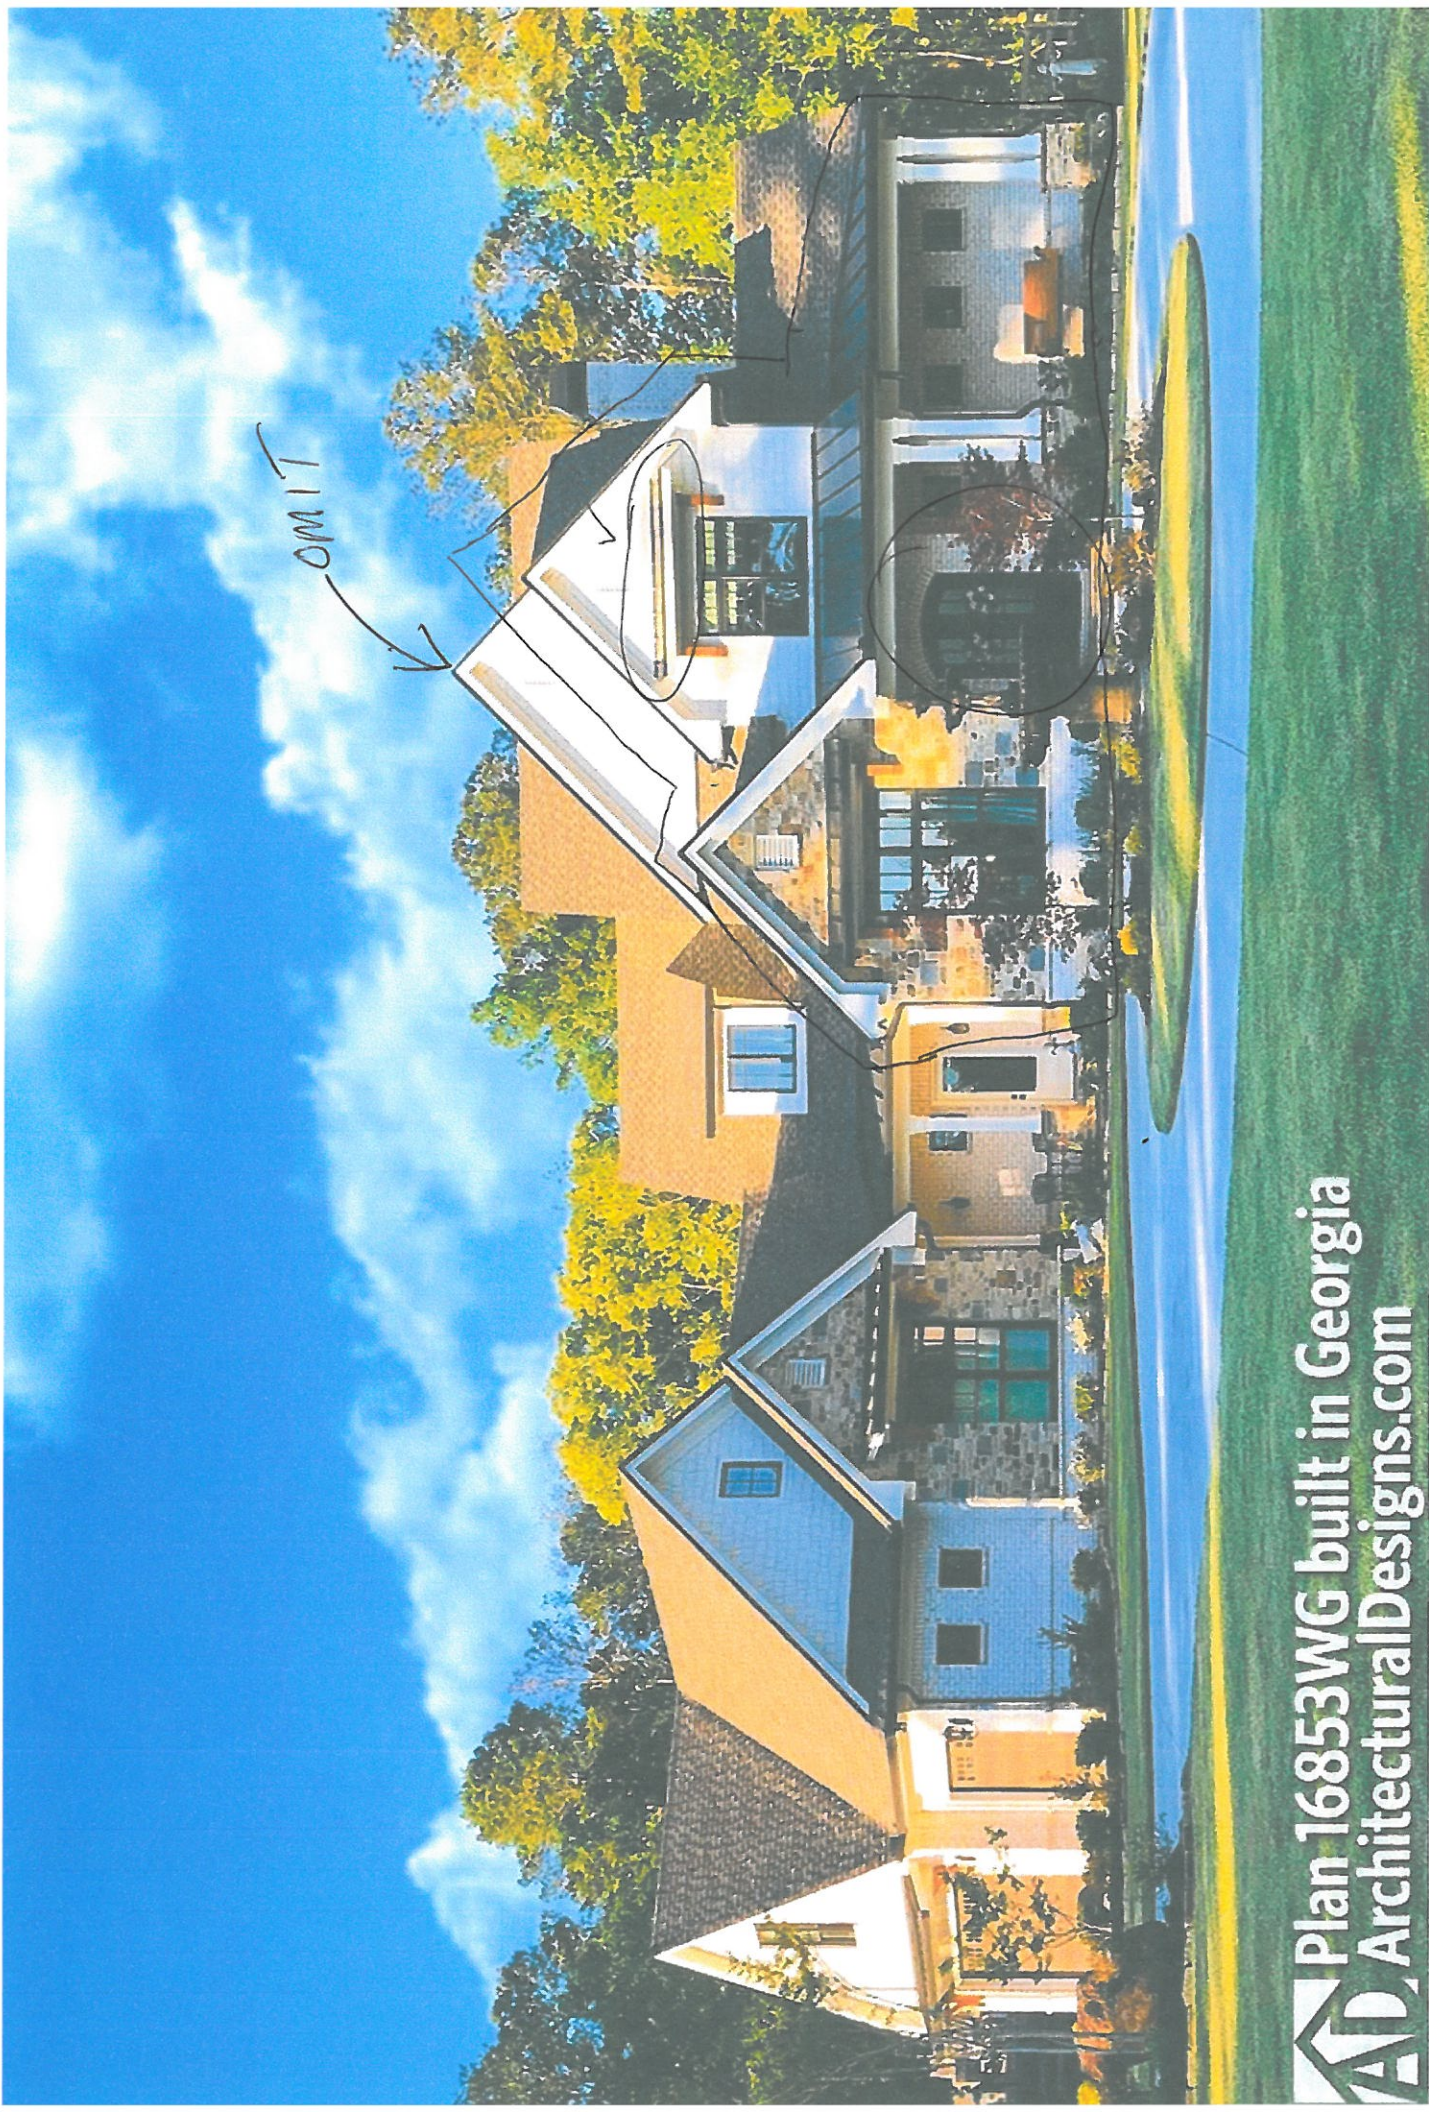

AD Plan 16853WG built in Georgia
ArchitecturalDesigns.com

ASPHALT SHINGLES MAIN ROOF

STANDING SEAM ON PORCHES / DOWNER-FISHED COVERINGS

NO EXPOSED RAFTER TAILS

OMIT



 Plan 16853WG built in North Carolina
ArchitecturalDesigns.com