Exhibit "A"

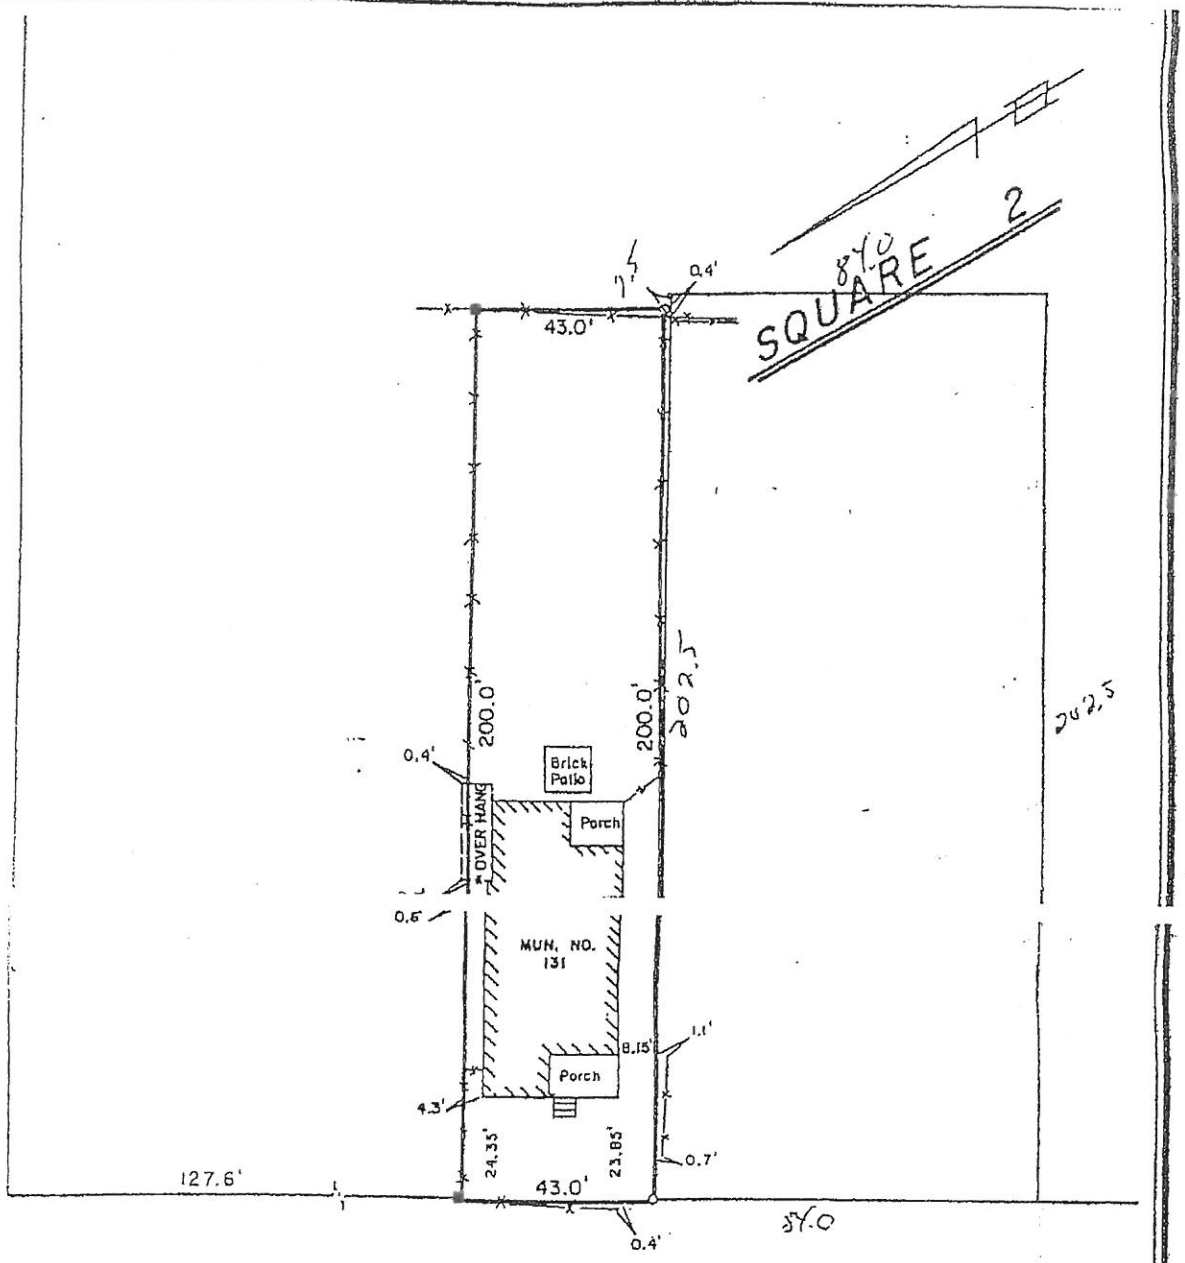

NOTE:
This survey is in accordance with a plat of survey by Land Surveying, Inc., Jeron R. Fitzmorris, R.L.S., for John L. Carter, dated April 26, 1988.

This is to certify that I have consulted the F.E.M.A. Flood Insurance Rate Maps and find that the subject property is located in a special flood hazard zone (Flood Zone A-10) per panel number 220202 0002C of said maps, having an effective date of April 4, 1983.

SURVEY OF A PART OF
SQUARE 2
TOWN OF MANDEVILLE
ST. TAMMANY PARISH, LA.

STATE OF LOUISIANA

FONTCUBERTA Surveys INCORPORATED