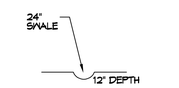

SWALE
SCALE: N.T.S.

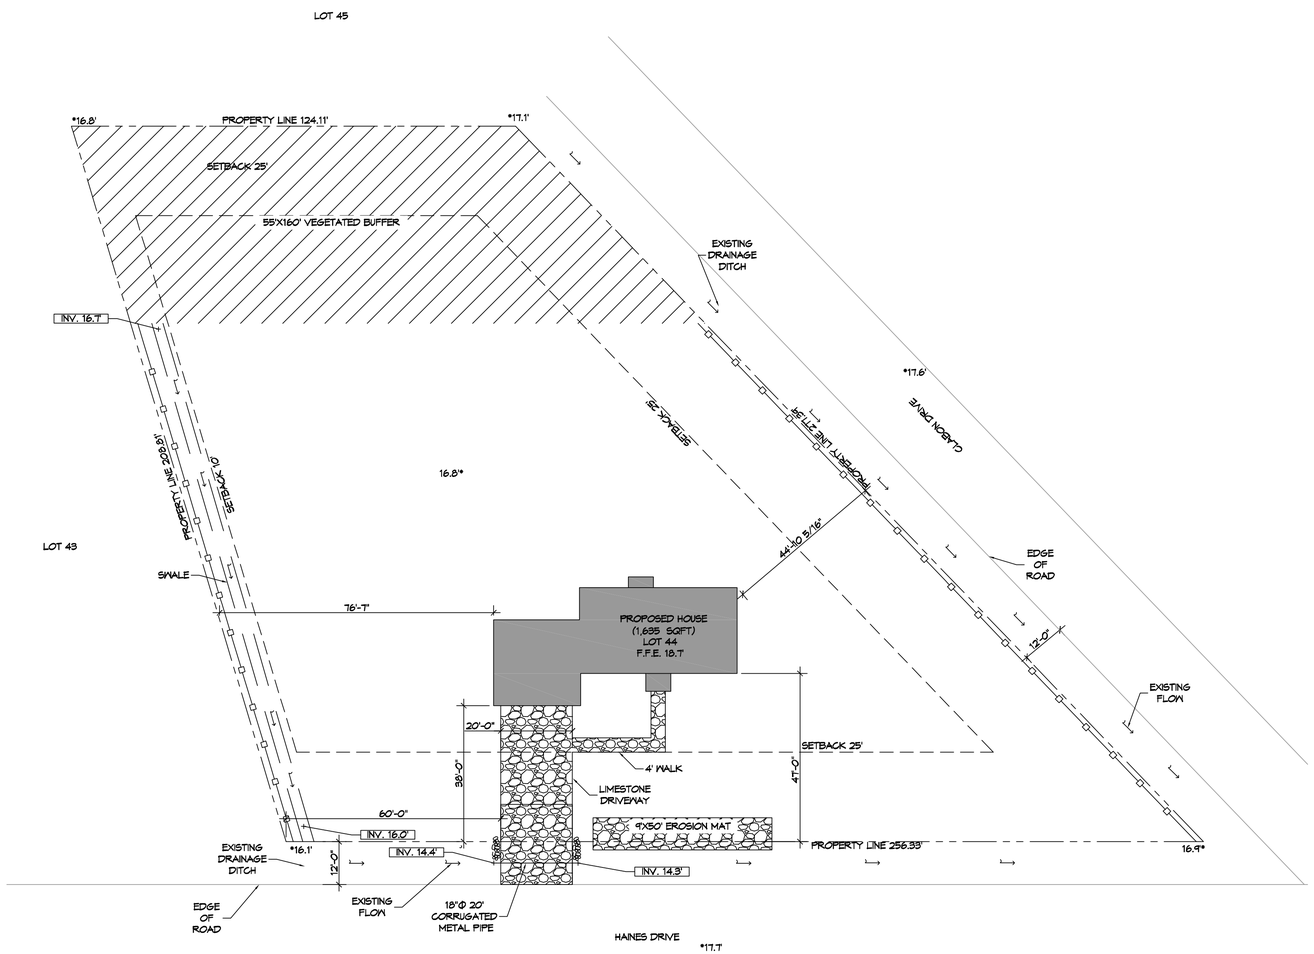

N

1 SITE PLAN
SCALE: 1"=20'-0"

PLANNING

ZONED "A2" SUBURBAN

FLOOD ZONE

ZONE "X"

BUILDING SETBACK LINES

FRONT - 25'
SIDE - 10'
STREET SIDE - 25'
REAR - 25'

BUILDING ELEVATION

BASE FLOOD ELEVATION = "X"
FINISHED FLOOR ELEVATION = 18.7

STORMWATER CONTROL LEGEND

- SILT FENCE
- VEGETATED BUFFER
- EROSION MAT
- RIP RAP
- WATER FLOW
- EXIT PAD

AS-BUILT 11-30-21

DAMMON ENGINEERING, INC.
www.dammonengineering.com
info@dammonengineering.com
Fax: 985.641.5950
554 Old Spanish Trail
Slidell, LA 70458
PH: 985.649.5832

#	DESCRIPTION	DATE
	REVISIONS	

STATE OF LOUISIANA
BRIAN A. MISTICH
License No. 30187
PROFESSIONAL ENGINEER

JASON AND CHERRIE DAMMON
LOT 44 OAK RANCH ESTATES
SLIDELL, LOUISIANA

JOB No: 2019 DATE: 11-30-21
DRAWN BY: CKD CHECKED BY: BAM

THIS DRAWING AND SPECIFICATIONS AS INSTRUMENTS OF SERVICE IS THE PROPERTY OF DAMMON ENGINEERING, INC. AND SHALL NOT BE USED FOR ANY PURPOSE NOT SPECIFICALLY AGREED TO IN WRITING BY DAMMON ENGINEERING, INC. THIS DRAWING AND SPECIFICATIONS SHALL BE RETURNED UPON REQUEST OF DAMMON ENGINEERING, INC. UPON COMPLETION OF THE PROJECT. THIS WORK HAS BEEN PREPARED BY A PROFESSIONAL ENGINEER UNDER HIS DIRECT SUPERVISION AND CONTROL. ALL PROFESSIONAL ENGINEERING DECISIONS HAVE BEEN MADE BY A LICENSED PROFESSIONAL ENGINEER.

SHEET TITLE:
SITE PLAN

DRAWING NUMBER:
C101

SHEET No: 1 of # 1

FILE NAME: J:\- Closed Jobs\- Residential\Jason and Cherrie Dammon\Current drawings\C101 - Site Plan.dwg PLOT DATE & TIME: Tuesday, November 30, 2021 8:03:54 AM