
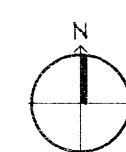


**1 FLOOR PLAN**  
SCALE: 1/4" = 1'-0"

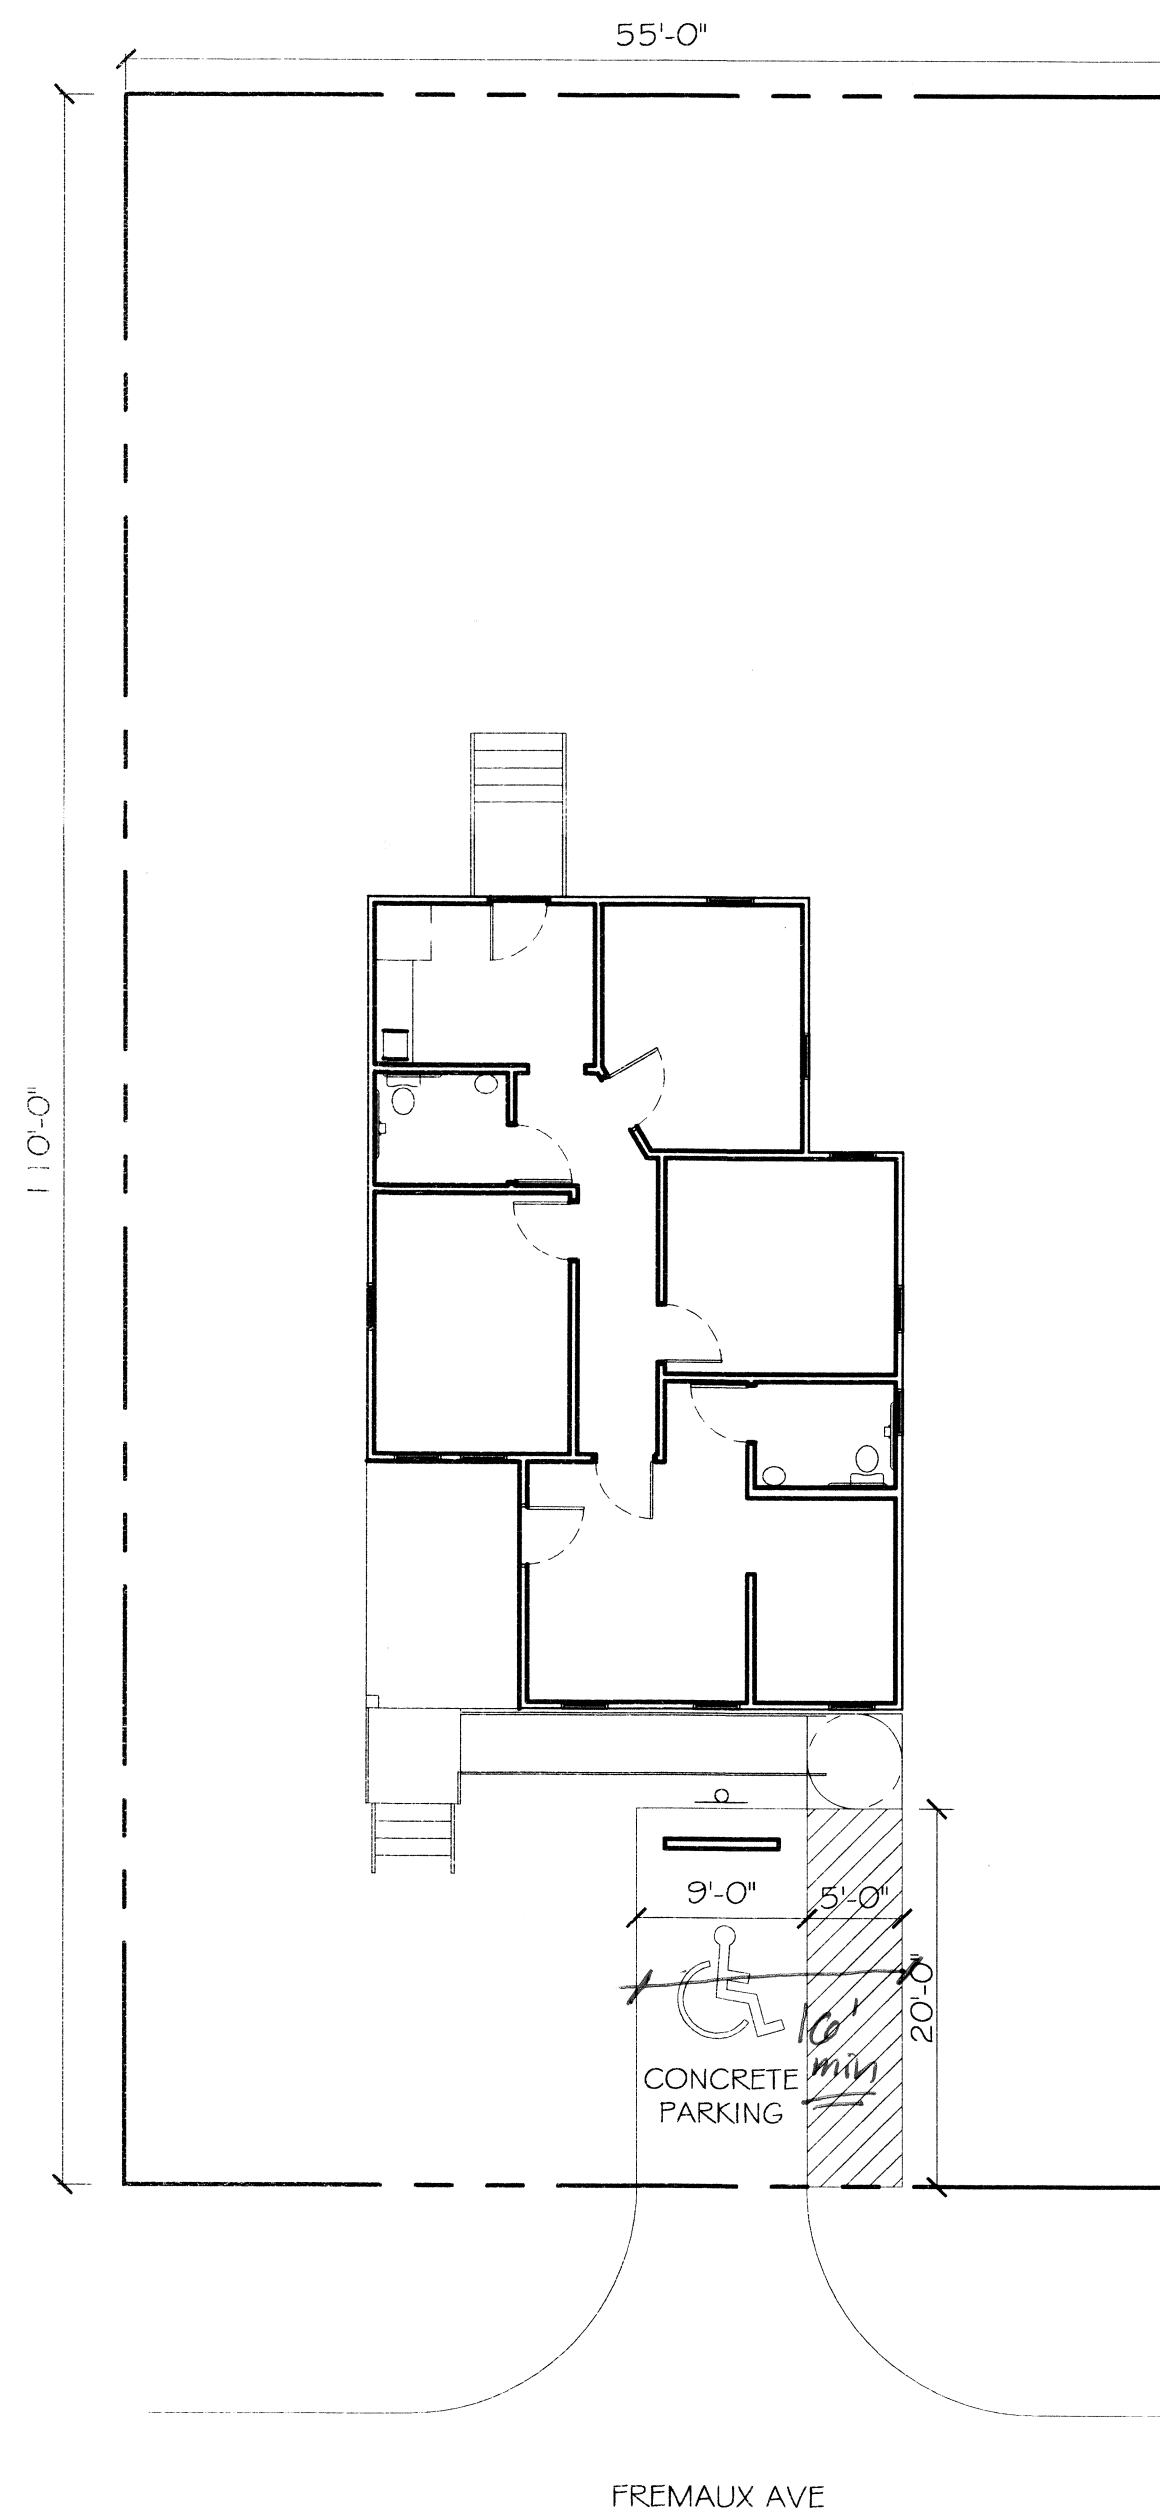

**1 SITE PLAN**  
SCALE: 1" = 10'

**BLDG CODE INFORMATION**


1. OCCUPANCY TYPE (BUSINESS)
2. CONSTRUCTION TYPE (VB)
3. OCCUPANCY LOAD 1000 SQ.FT. / 100 = (10 OCCUPANTS)
4. EXIT REQUIREMENTS (2)

**GENERAL FLOOR PLAN NOTES**

1. DIMENSIONS ARE FINISH SURFACE TO STUD SURFACE UNLESS OTHERWISE NOTED.
2. REFER TO SHEET G1 FOR TYPICAL MOUNTING HEIGHTS AND REQUIRED ADAAG FLOOR CLEARANCES.

**DAMMON ENGINEERING, INC.**  
Architects & Engineers  
www.dammonengineering.com  
info@dammonengineering.com  
Ph: 985.649.9852  
Chief Architect: Kevin J. Kitchin, NCARB  
Chief Engineer: Brian Misch, PE  
554 Old Spanish Trail  
Slidell, LA 70458  
F: 985.641.9550

REVISIONS	DATE
#   DESCRIPTION	

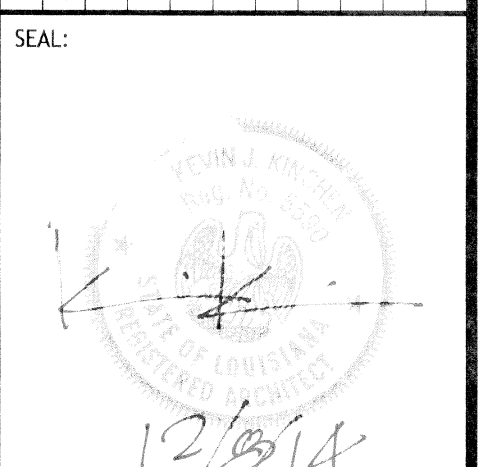

REVIEWED FOR  
STATE FIRE MARSHAL  
AS PER REVIEW LETTER  
BY JULIE TITUS ARCHITECT

**SIV PROPERTIES**  
442 FREMAUX AVE  
SLIDELL, LA 70458

JOB No: 2014 DATE: 12-03-14  
DRAWN BY: CKD CHECKED BY: KJK

SHEET TITLE:  
SITE PLAN  
# FLOOR PLAN

DRAWING NUMBER:  
**A-1**

SHEET No: 02 of 02