


North ←

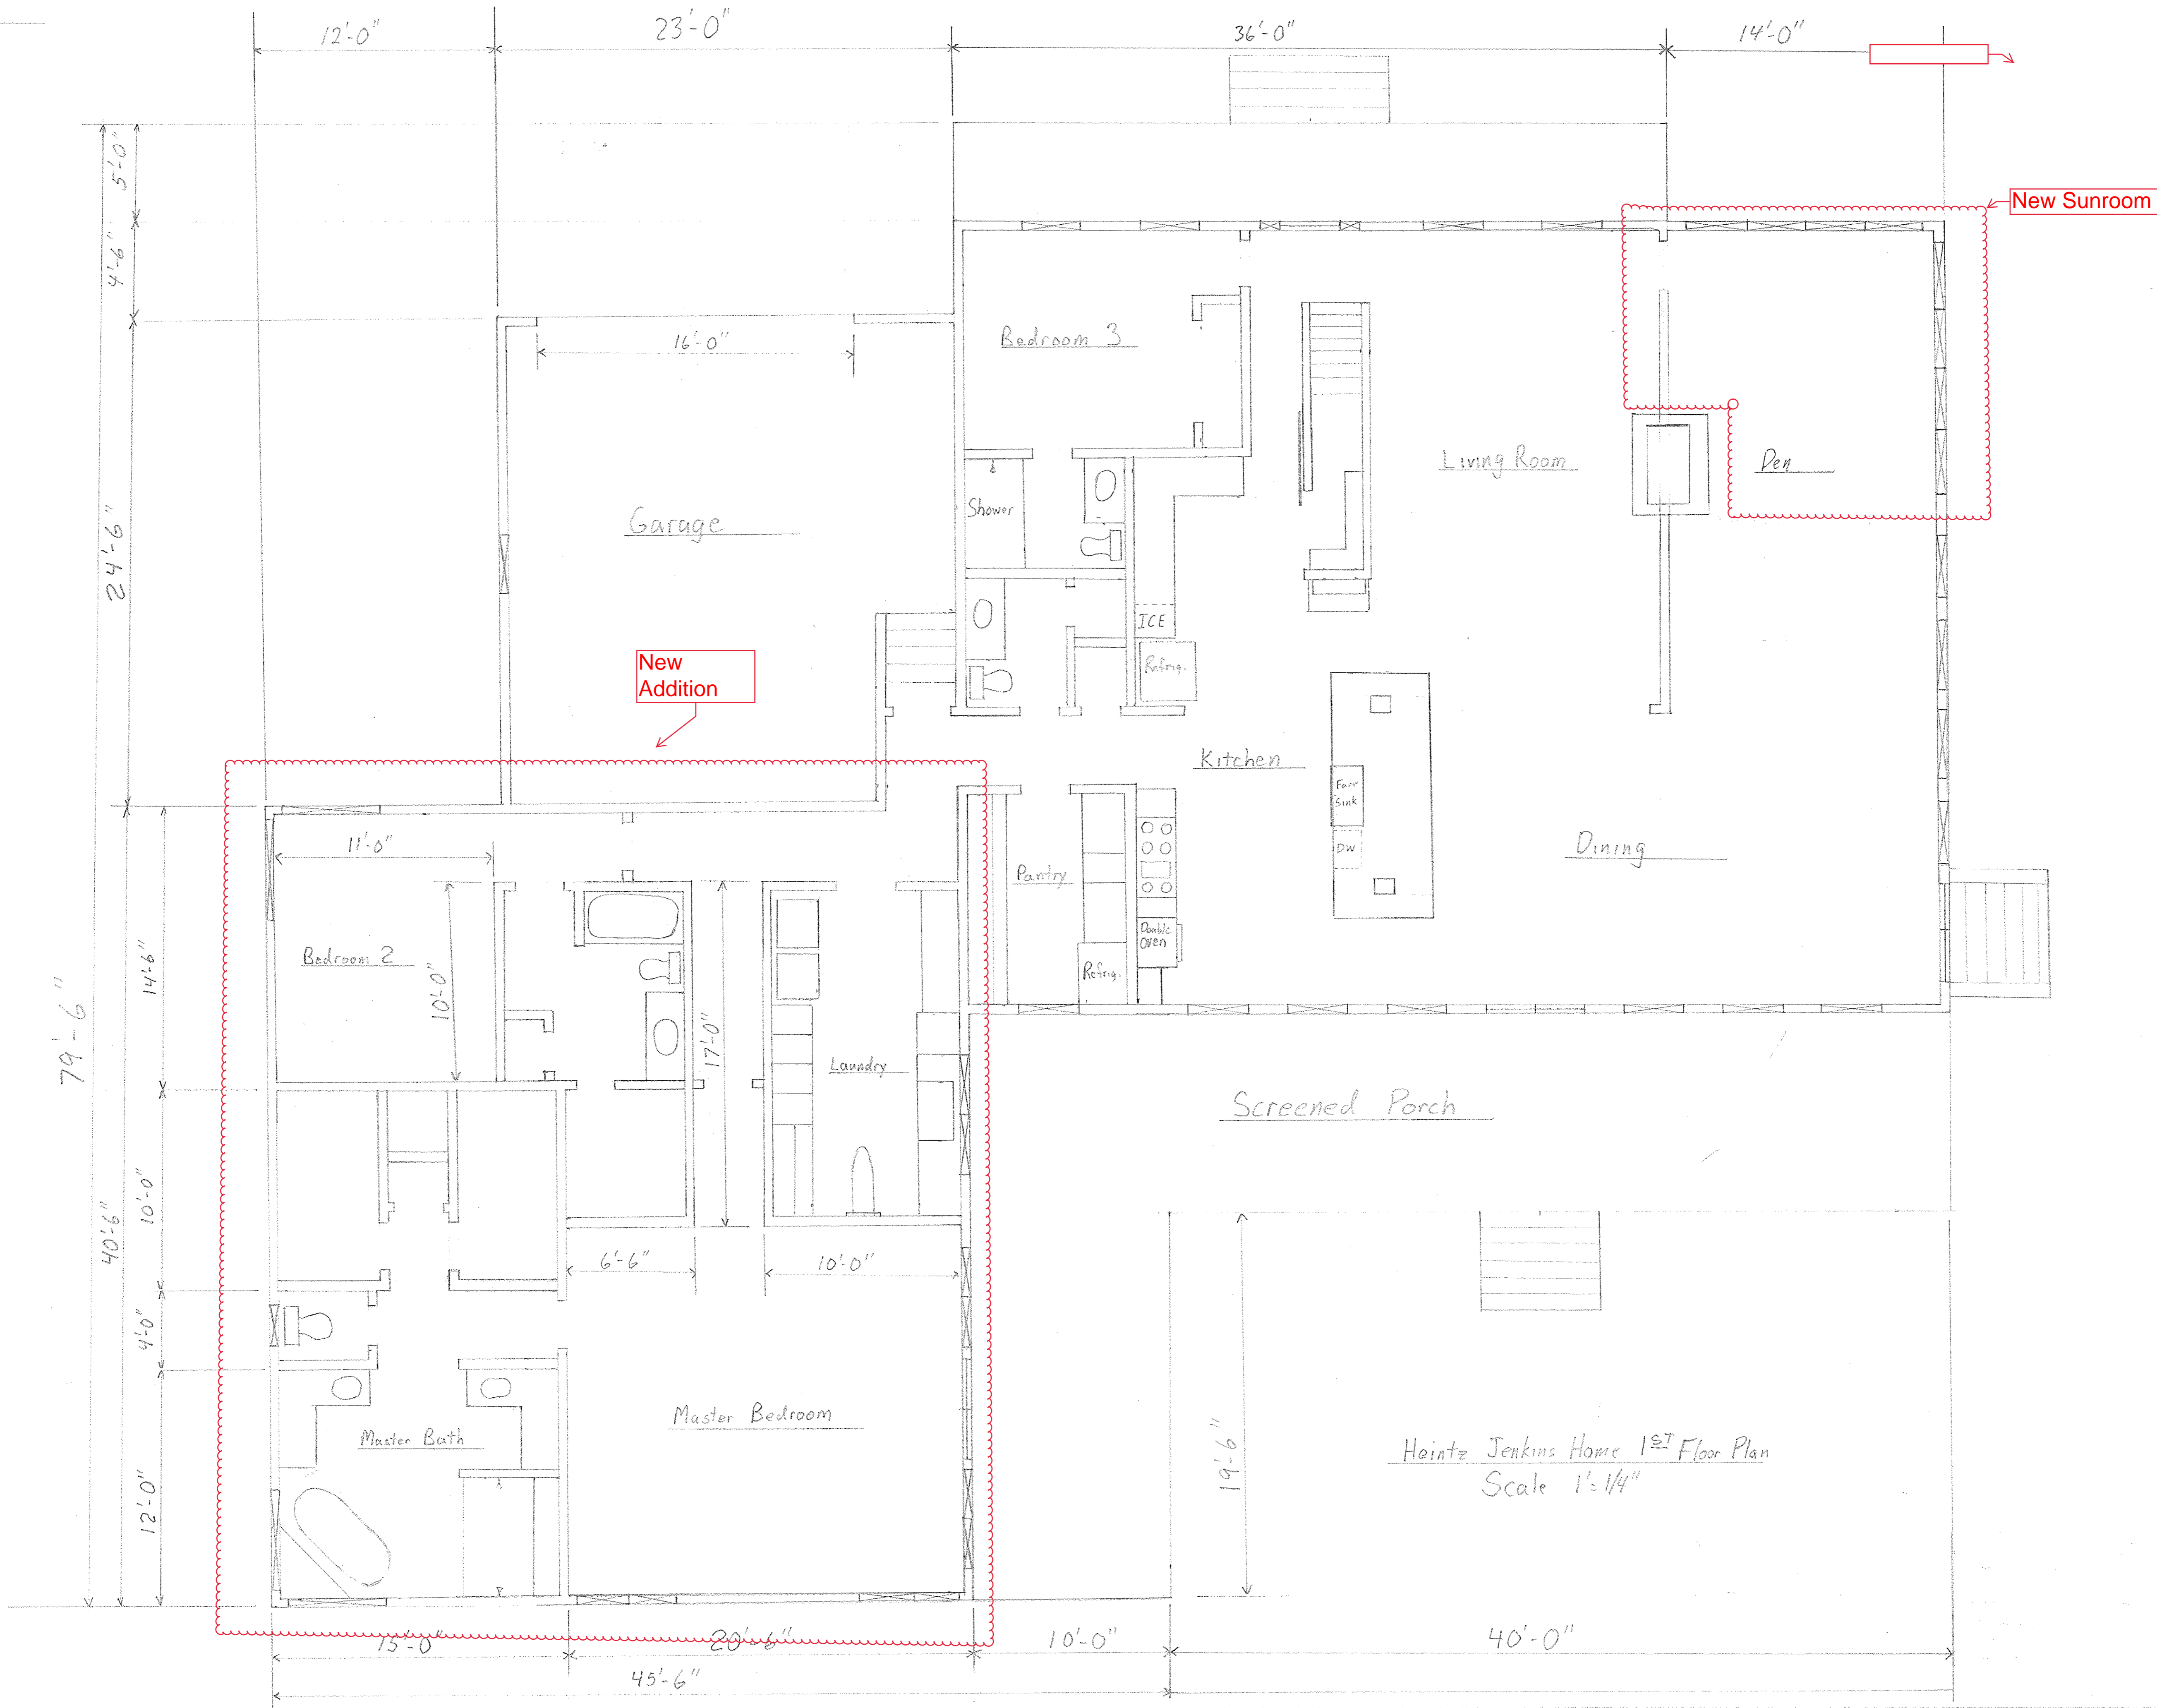

Heintz Jenkins Home 1<sup>st</sup> Floor Plan  
Scale 1"=1/4"