


DNR

NOTE: NO CORNERS SET IN CANAL

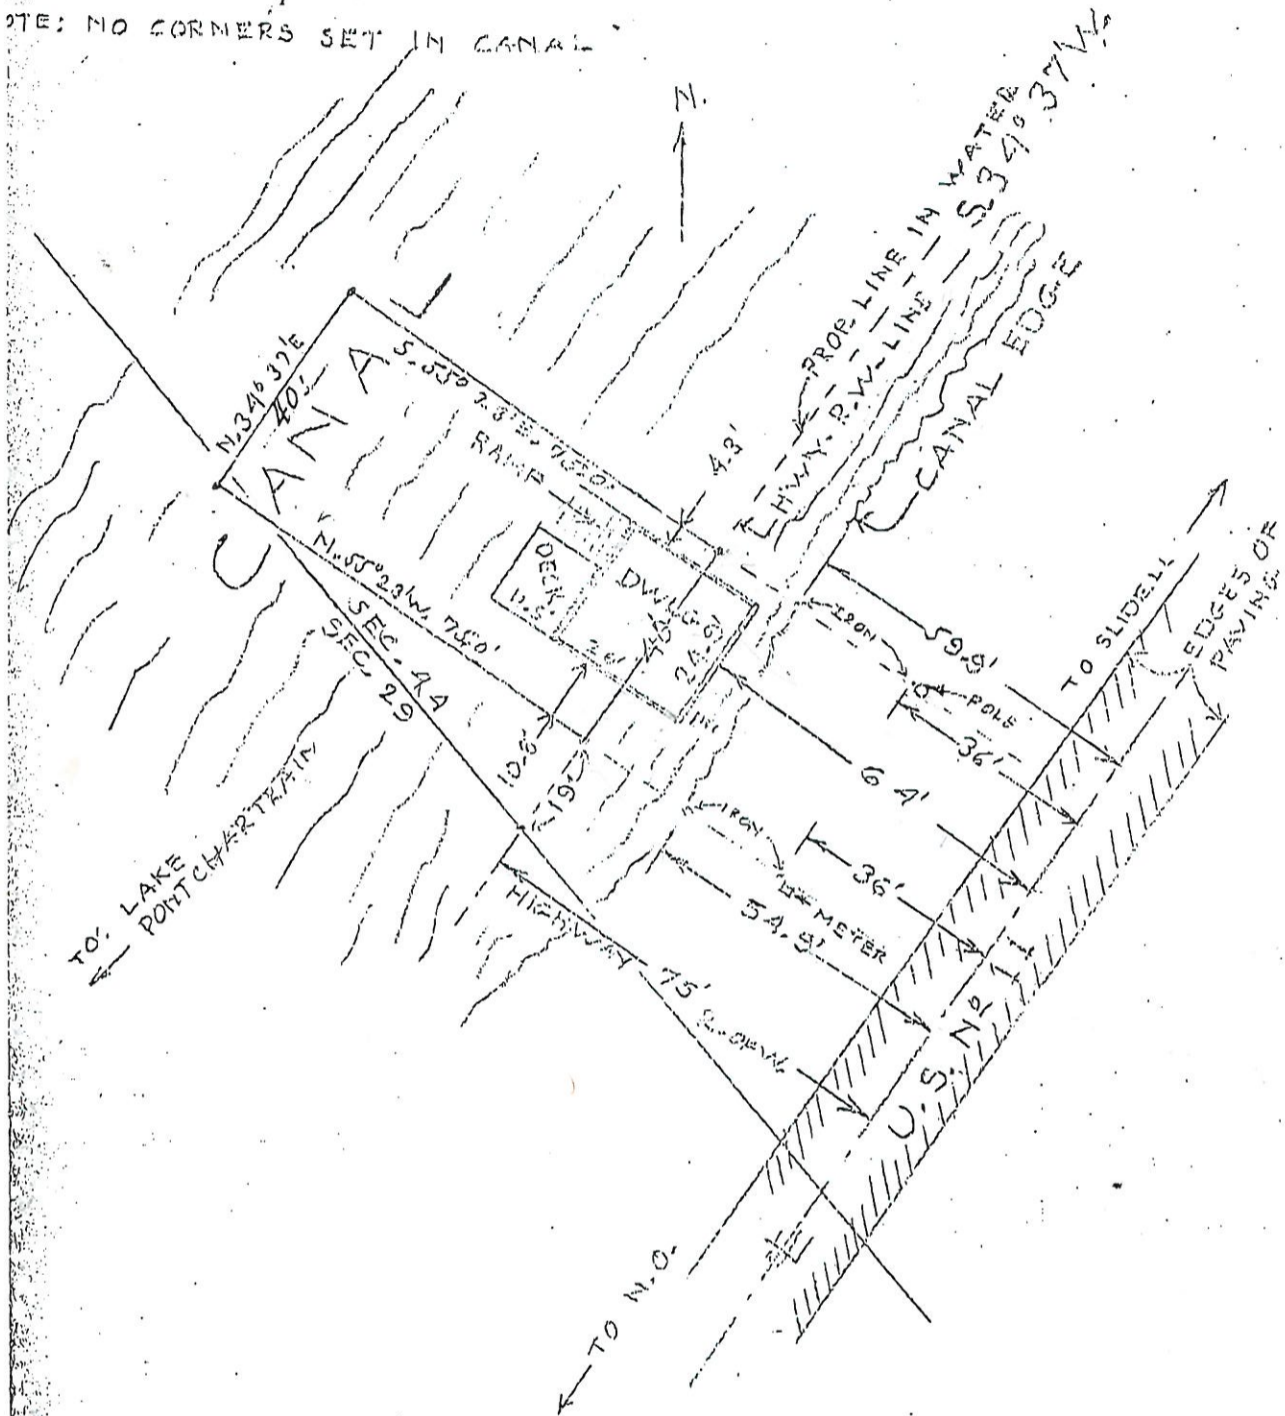

MAP OF LOT IN SEC. 44-T. 9S-R. 14E.
 5TH WARD ST. TAMMANY PARISH-LA.
 MEANESPY PROP. - C.O.S. 257-FO. 249
 BASED ON H.G. FRITCHIE PARISH SURVEYOR-MAP JULY 20-1956

SCALE 1" = 30 FT.

SURV. DEC. 14, 1967

Lamar P. Harrison
 LAMAR P. HARRISON-C.E.
 SLIDELL-LA.

ALL RIGHTS RESERVED
 REPRODUCTION
 PROHIBITED
 WITHOUT
 PERMISSION
 OF THE
 ENGINEER