



MASTERBED CLG
1/4" = 1'

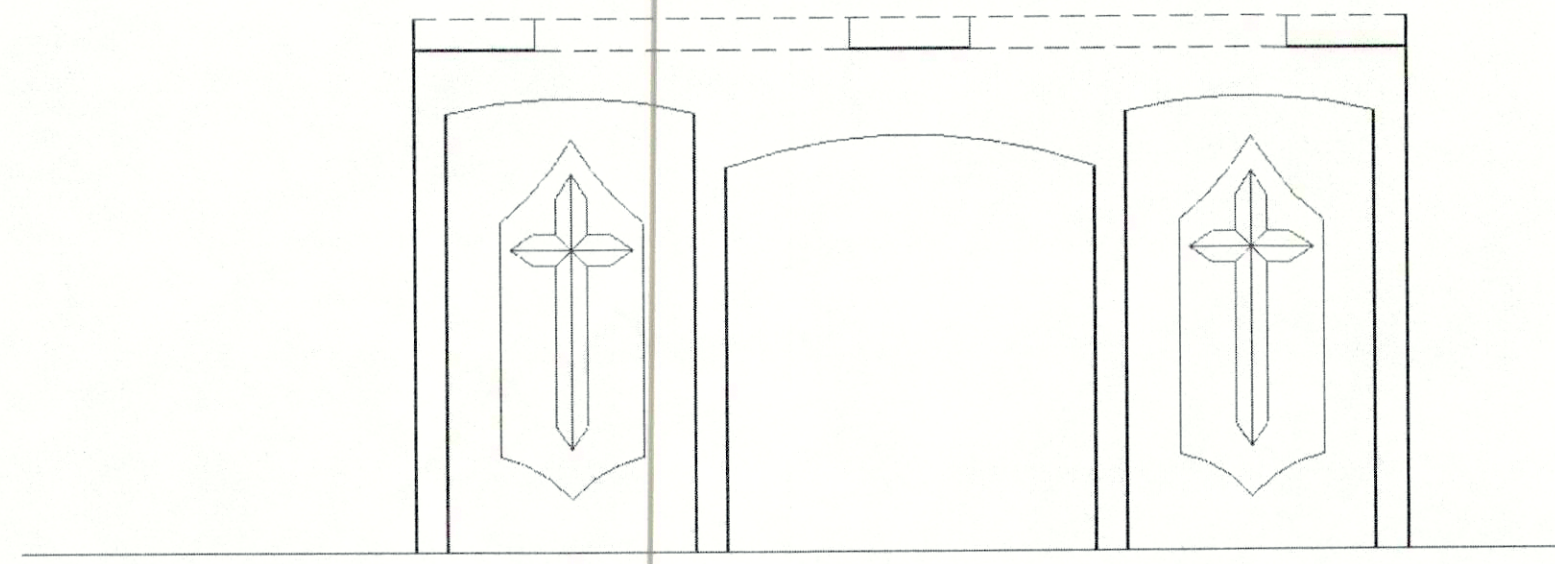


LIVINGROOM NITCH
1/4" = 1'

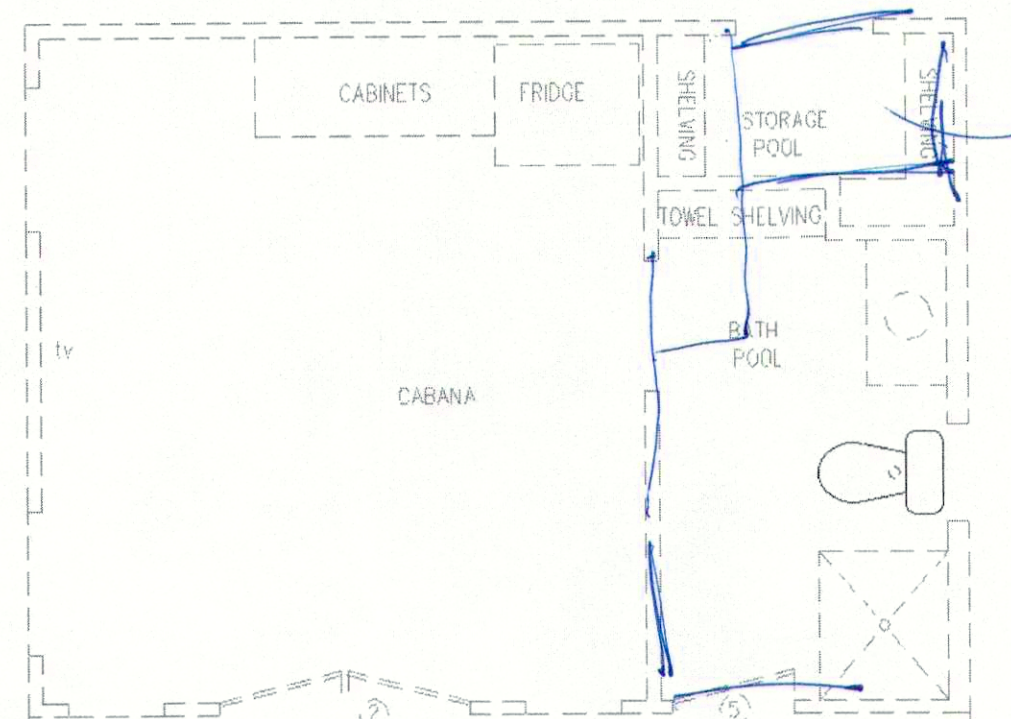

WINDOW SCHEDULE			
MK	SIZE	HEADER	DESCRIPTION
A	2880	9'-4"	VINYL EYEBROW
B	2880	9'-4"	VINYL EYEBROW TEMPERED
C	2840	8'-0"	VINYL
D	3080	7'-6"	VINYL
E	3080	7'-0"	VINYL
F			
G	3060	7'-0"	VINYL
H	3006	7'-7"	VINYL EYEBROW
I	3850	8'-0"	VINYL
J	4040	7'-0"	VINYL TEMPERED
K	2840	8'-0"	VINYL
L	3070	8'-0"	VINYL
M	2850	7'-10" FROM STAIR PLATFORM	VINYL EYEBROW TEMPERED

DOOR SCHEDULE			
MK	SIZE	JAMB	DESCRIPTION
1	5'-0 1/2"-0"	4 9/16"	EXTERIOR WOOD DOUBLE DOOR FULL GLASS ARCHED TOP
2	5'-0 1/2"-0"	4 9/16"	EXTERIOR FIBERGLASS DOUBLE DOOR FULL GLASS
3	2'-8 1/2"-8"	4 9/16"	EXTERIOR FIBERGLASS W/1'-0" TRANSOM FULL GLASS
4	2'-8 1/2"-8"	4 9/16"	EXTERIOR SOLID FIBERGLASS DOOR
5	2'-8 1/2"-8"	4 9/16"	EXTERIOR FIBERGLASS HALF GLASS
6	2'-8 1/2"-8"	4 9/16"	INTERIOR DOOR
7	2'-8 1/2"-8"	4 9/16"	INTERIOR DOOR
8	2'-8 1/2"-8"	4 9/16"	INTERIOR DOOR
9	2'-0 1/2"-8"	4 9/16"	INTERIOR DOOR
10	1'-8 1/2"-8"	4 9/16"	INTERIOR DOOR
11	2'-8 1/2"-0"	4 9/16"	CASED OPENING
12	2'-8 1/2"-0"	4 9/16"	INTERIOR DOOR
13	2'-8 1/2"-0"	4 9/16"	INTERIOR DOOR
14	2'-4 1/2"-0"	4 9/16"	INTERIOR DOOR
15	2'-0 1/2"-0"	4 9/16"	INTERIOR DOOR
16	3'-0 1/2"-8"	4 9/16"	INTERIOR DOUBLE DOOR WITH BALL HINGE
17	4'-0 1/2"-0"	6 9/16"	INTERIOR DOUBLE POCKET DOOR
18	4'-0 1/2"-0"	6 1/16"	INTERIOR DOUBLE DOOR W/ BALL HINGE FULL GLASS
19	2'-8 1/2"-0"	4 9/16"	EXTERIOR WOOD HALF GLASS
20	8'x8'	4 9/16"	GARAGE DOOR
21	8'x8'	4 9/16"	GARAGE DOOR
22	4'-0 1/2"-8"	4 9/16"	BI-FOLD INTERIOR DOOR
23	2'-8 1/2"-8"	4 9/16"	EXTERIOR FIBERGLASS HALF GLASS

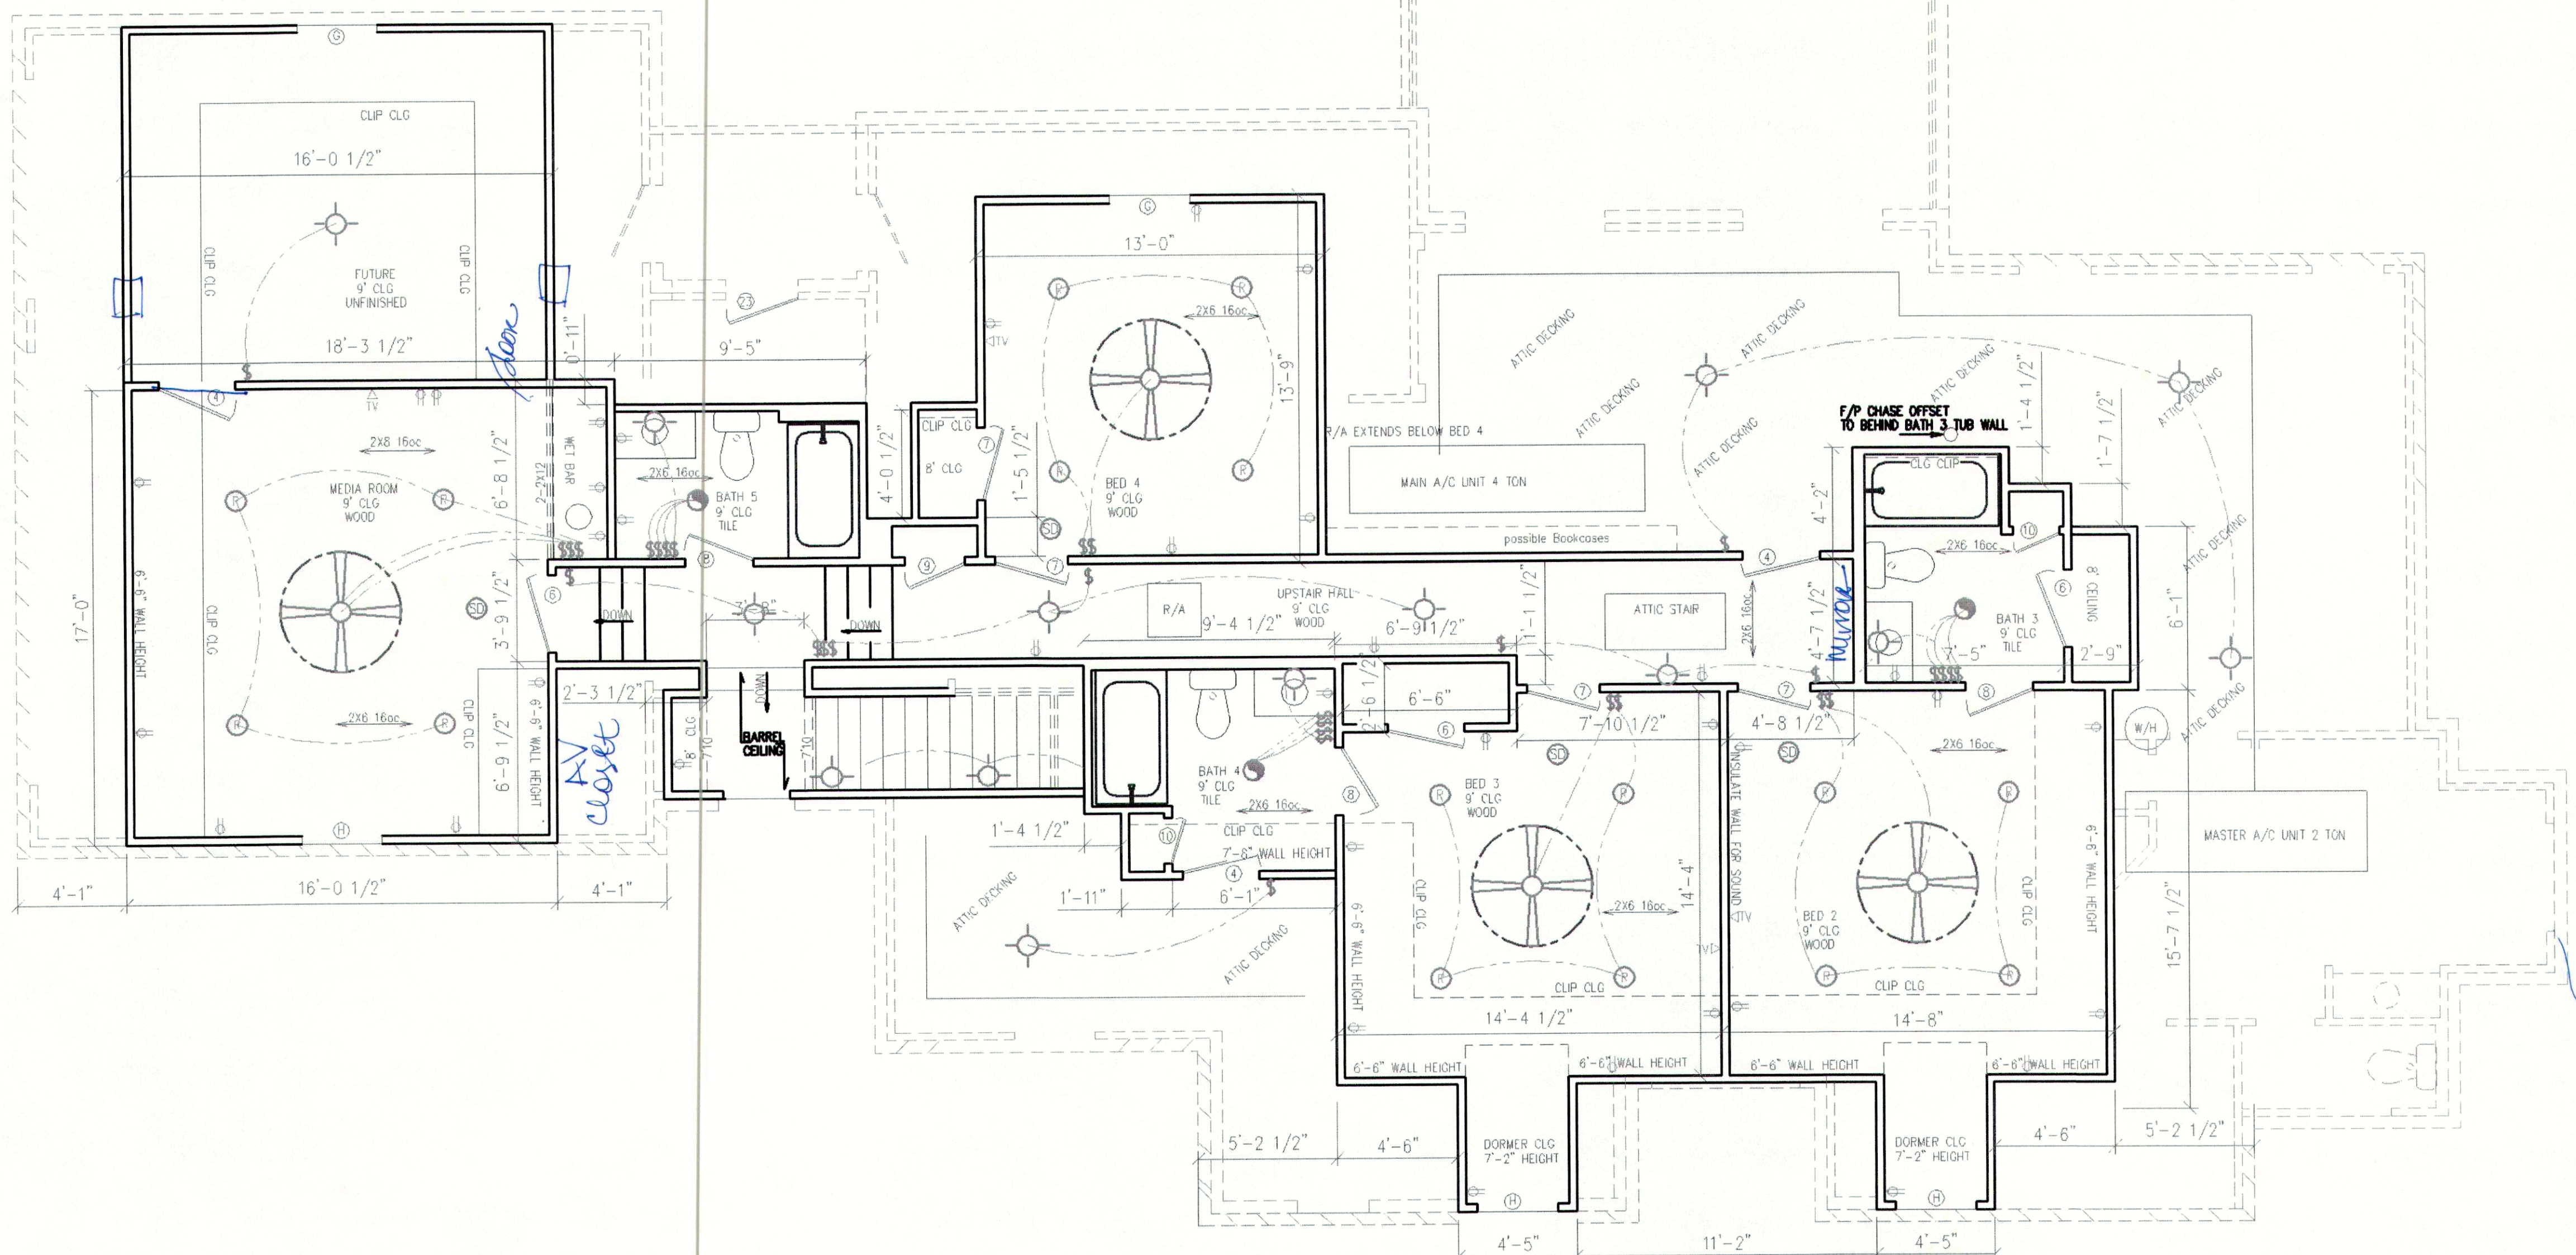

SECOND FLOOR PLAN
1/4" = 1'



RESIDENCE FOR: PATRICIA & RAY POSECAL		
SCALE: NOTED	APPROVED BY:	DRAWN BY:
DATE: JULY 15	S.E.L.	SCOTT LASSERE
TURTLE CREEK SLIDELL LA		SHEET 3 OF 5
CONTACT NUMBER: 985-445-7128		