

# Dammon Engineering, Inc.

dammonengineering.com

---

1095 Florida Ave.  
Slidell, LA 70458

P.O. Box 2830  
Slidell, LA 70459

985-649-5832  
FAX 985-641-5950

September 25, 2006

Mr. Anthony O Emukah  
1300 Perdido Street  
Suite 7E06  
New Orleans, LA 70112

RE: Dong Phuong Oriental Bakery  
Permit No. 06COM-01415

Dear Mr. Emukah,

Please note the following responses to your letter dated August 23, 2006.

## ARCHITECTURAL:

1. The following statement was inadvertently omitted from the following plans: C-1, C-2, S-1, A-1, A-2, A-3, A-4

These plans have been prepared under my direct supervision, and to the best of my knowledge and belief, meet all the building codes of the City of New Orleans, as well as state and national codes. I am not supervising the work.

---

Ed Gremillion      Date:

2. The nature of materials to be stored in this facility will consist of dry goods: salt, flour, frozen goods and other food products.
3. Separation between the storage space and the bakery has been modified to 3 hrs. Please see attached revised drawing that now shows a 3-hr separation between the storage and bakery.
4. Exterior walls less than 5ft from the adjacent property line shall be not less than 2-hr fire resistive construction for S-1 occupancy. Please see attached revised drawing that now shows a 2-hr rated wall next to the property line.
5. Please find the attached letter from State Fire Marshal dated June 19, 2006.

MECHANICAL:

1. The following statement was inadvertently omitted from the mechanical plan:

These plans have been prepared under my direct supervision, and to the best of my knowledge and belief, meet all the building codes of the City of New Orleans, as well as state and national codes. I am not supervising the work.

---

Brian Mistich      Date:

PLUMBING:

2. The following statement was inadvertently omitted from the plumbing plan:

These plans have been prepared under my direct supervision, and to the best of my knowledge and belief, meet all the building codes of the City of New Orleans, as well as state and national codes. I am not supervising the work.

---

Brian Mistich      Date:

ELECTRICAL:

1. The following statement was inadvertently omitted from the electrical plan:


These plans have been prepared under my direct supervision, and to the best of my knowledge and belief, meet all the building codes of the City of New Orleans, as well as state and national codes. I am not supervising the work.

---

Emmett G. Dammon      Date:

Sincerely,

David Dammon  
Project Engineer  
Dammon Engineering

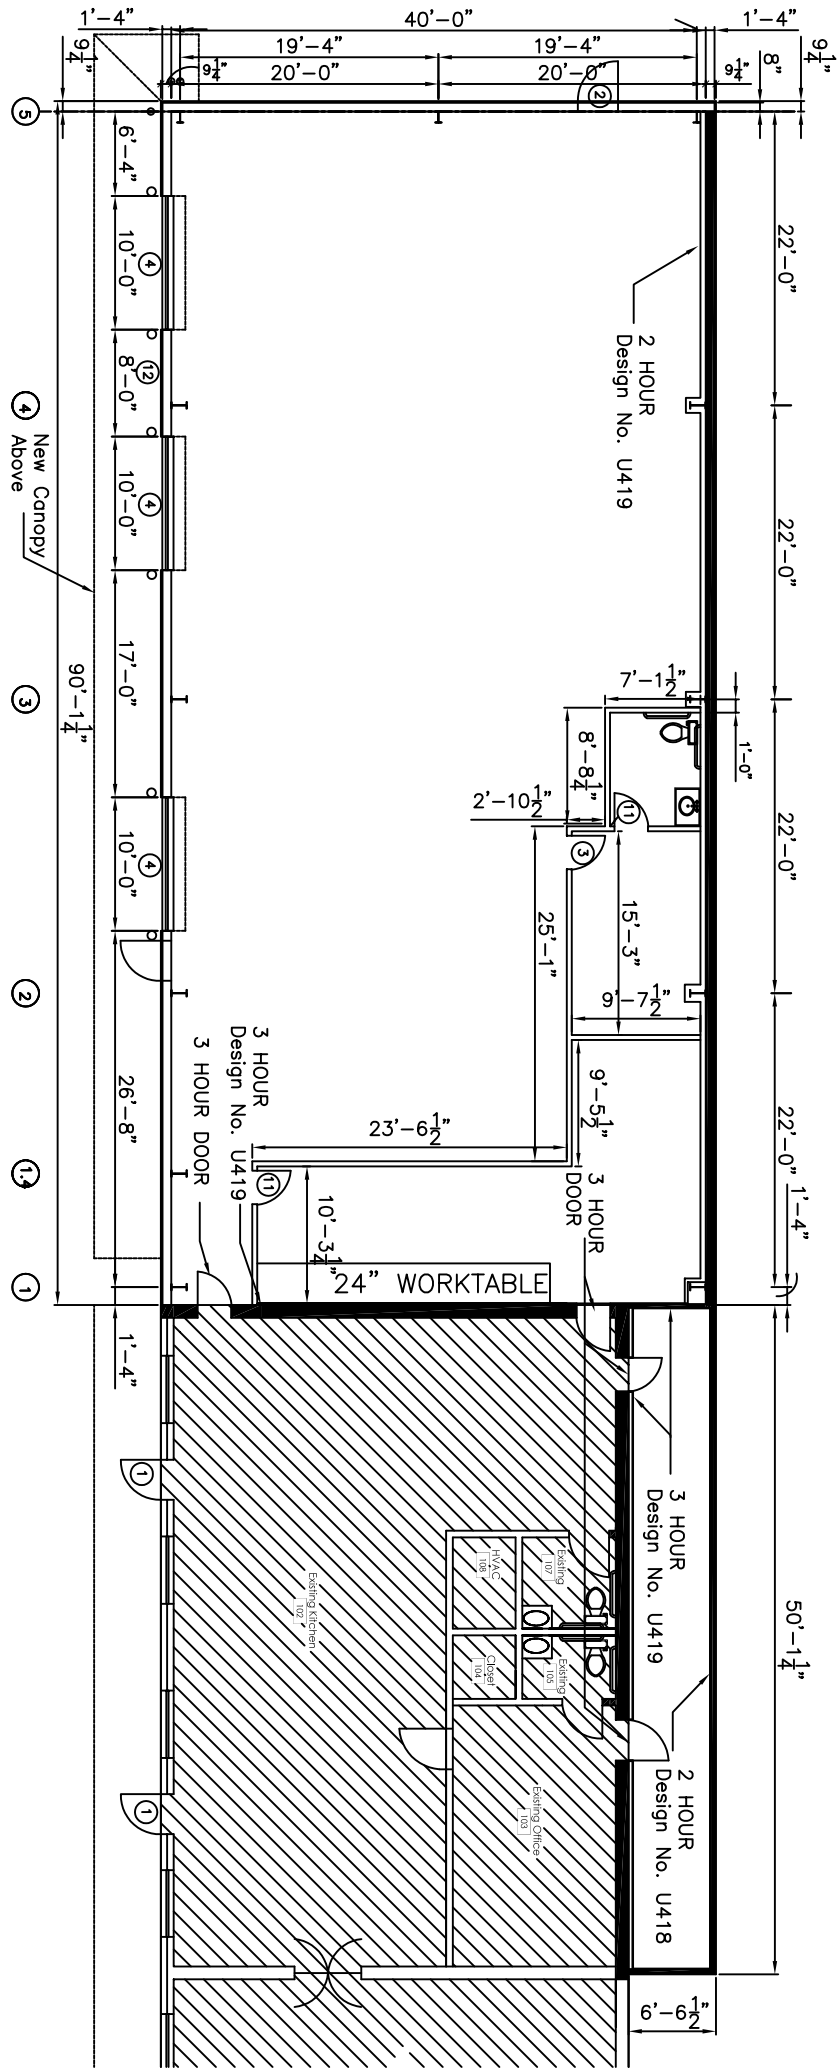

**1st FLOOR PLAN**  
 SCALE: 3/32"=1'-0"