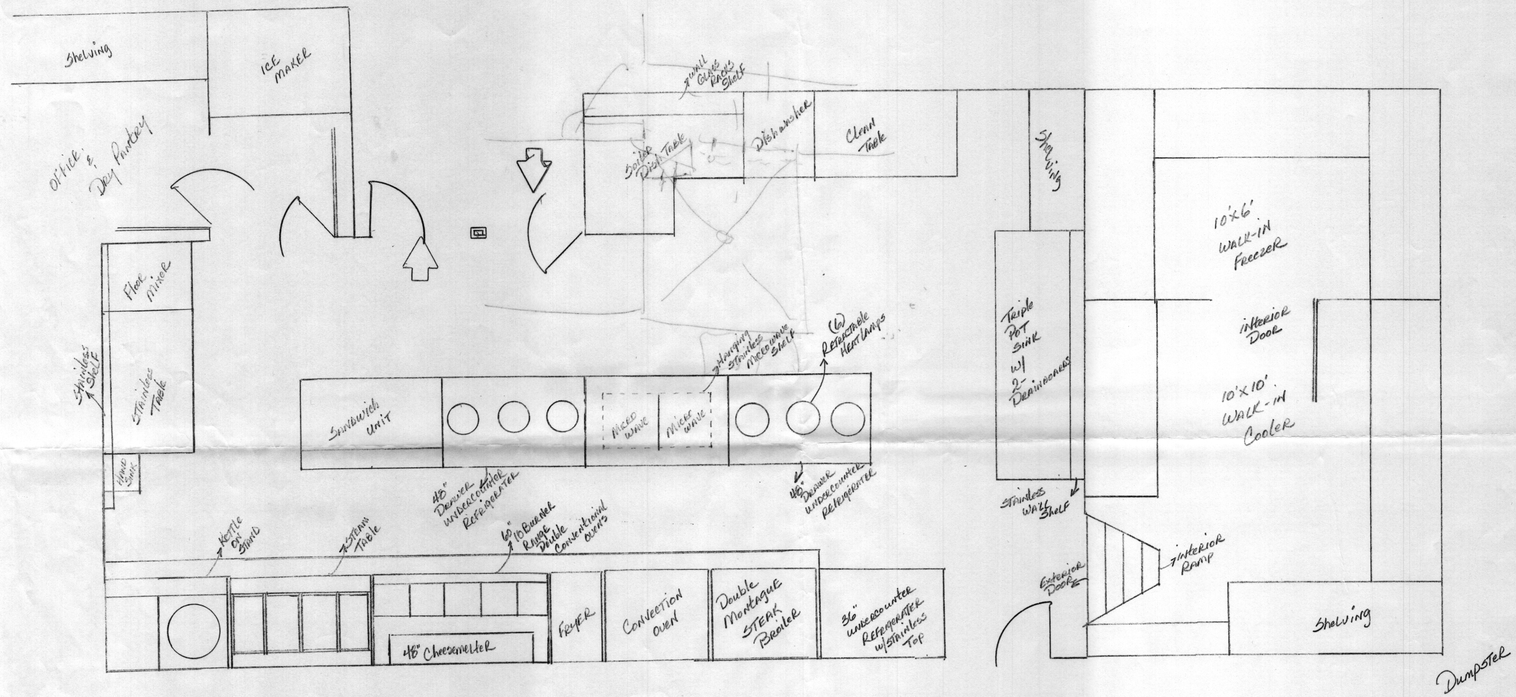

Christiano's Ristorante

Primo Steaks & Italian

300 Oak Harbor Blvd.
Slidell, LA. 70458

Kitchen Plan

Scale ⇒ 1/2" = 1'