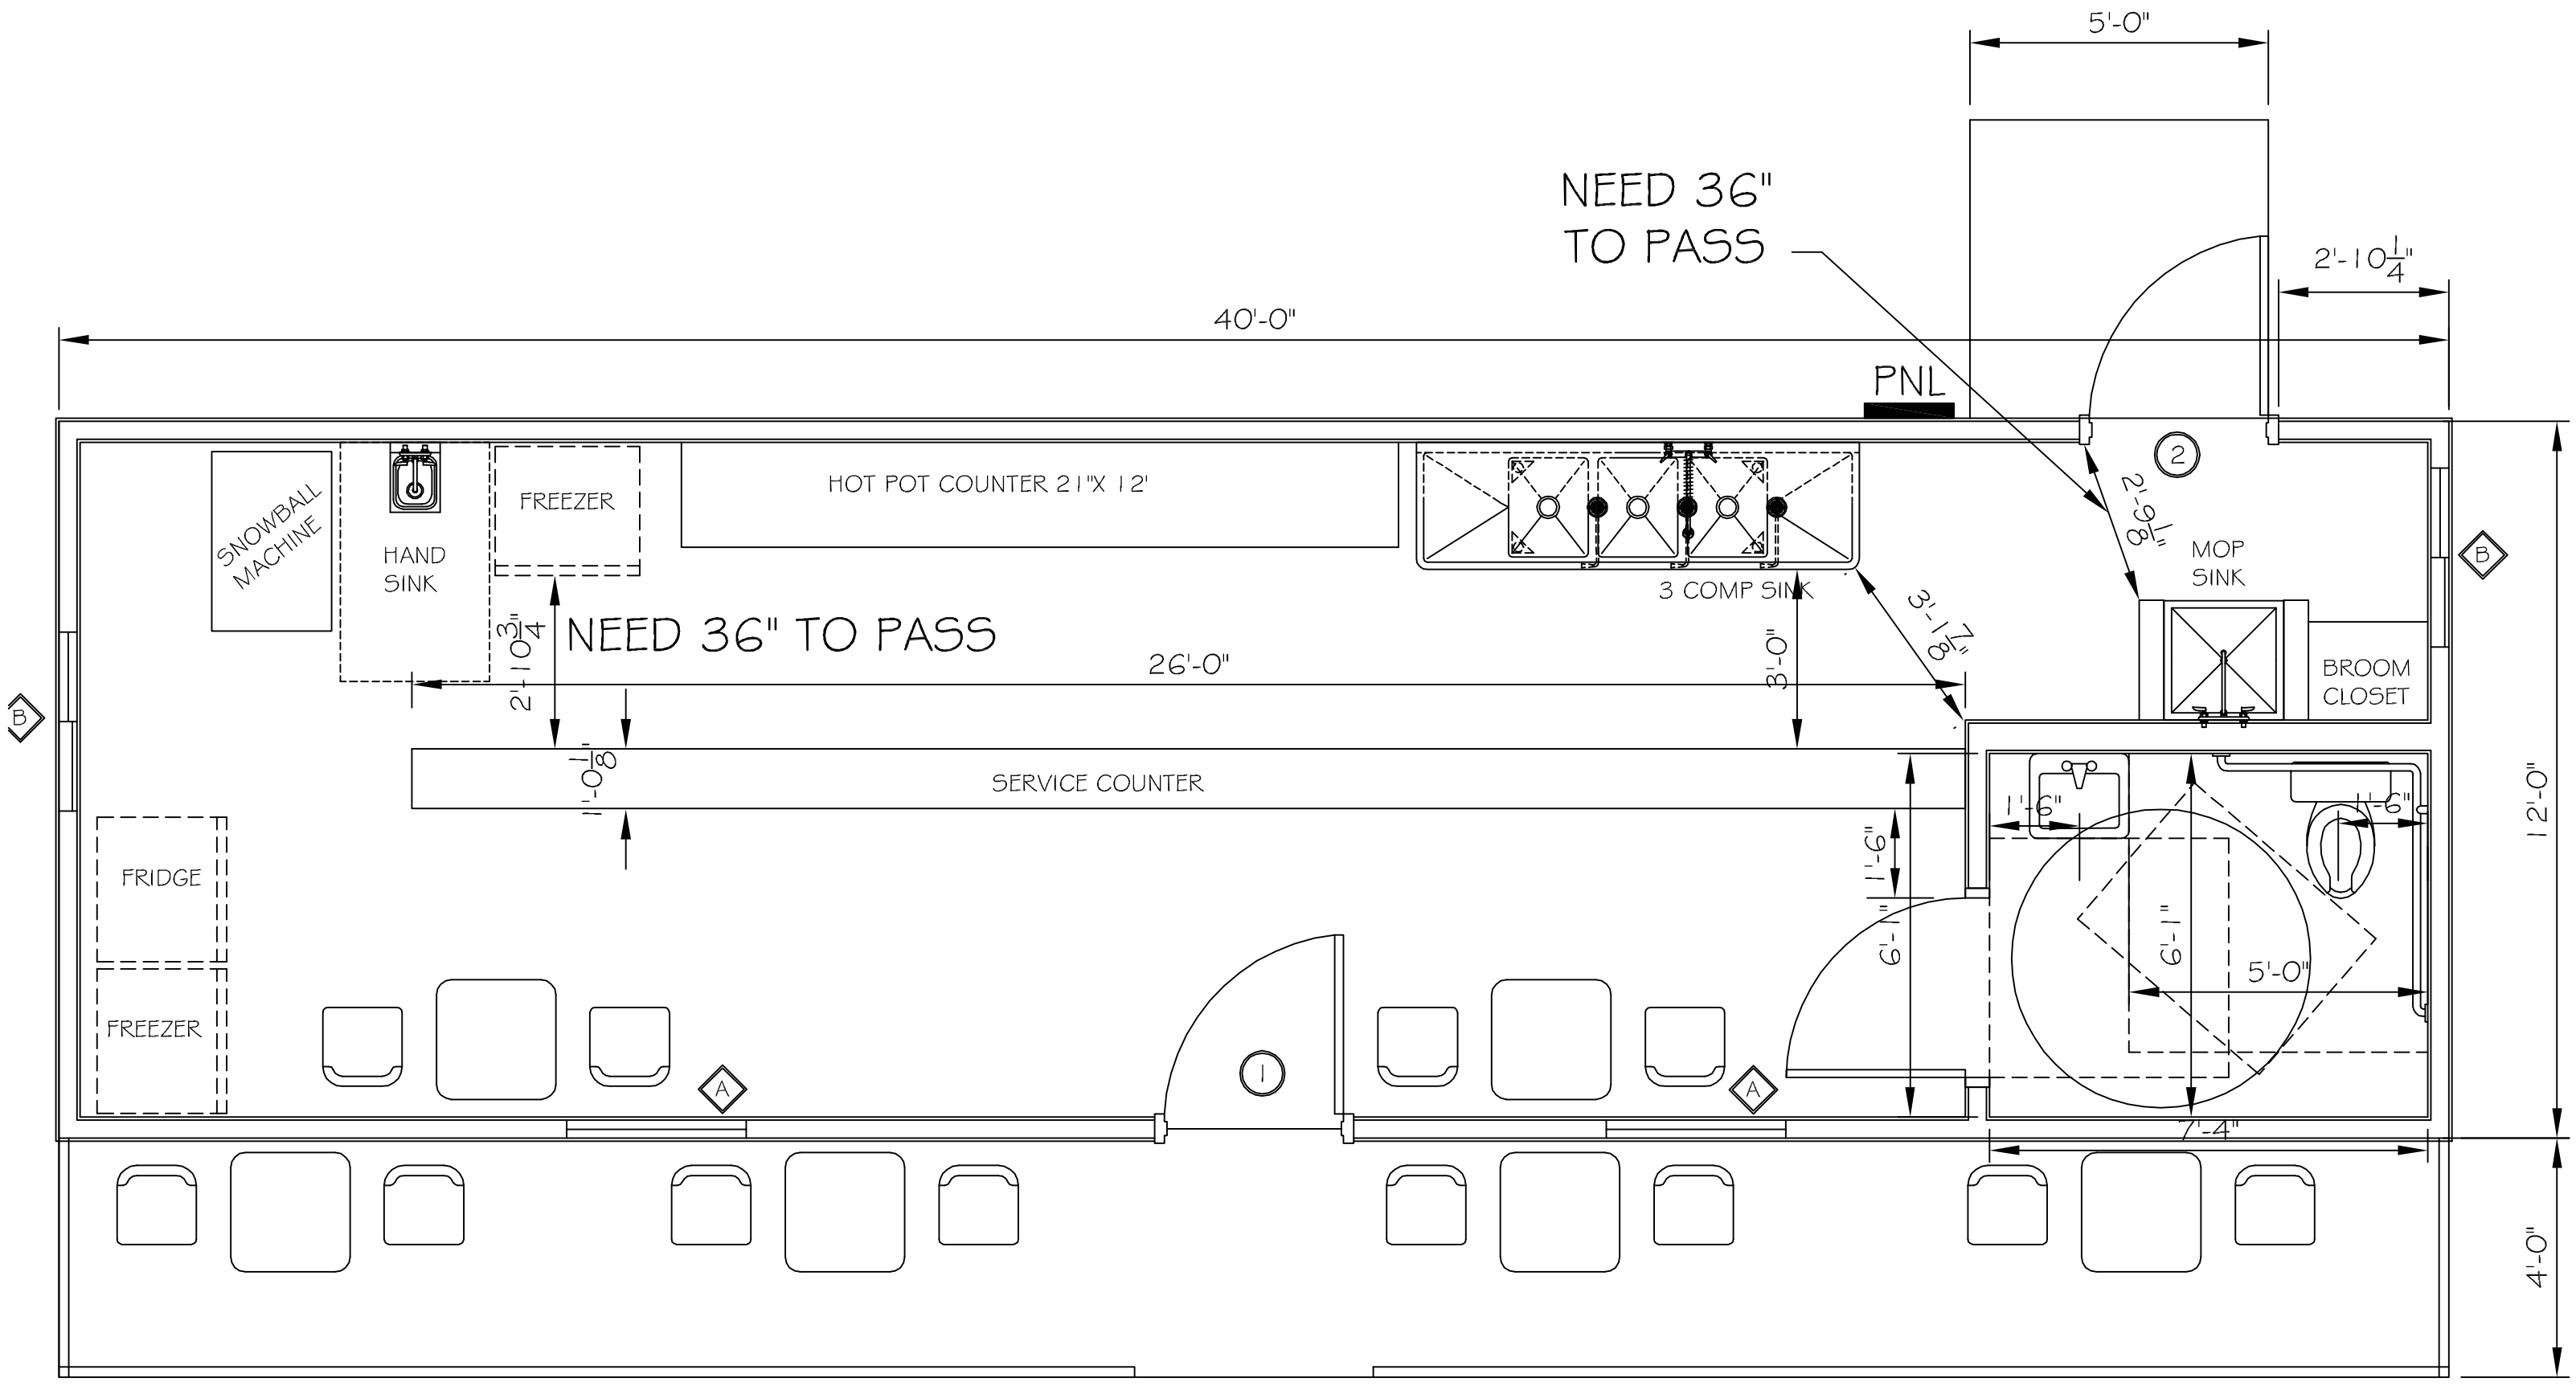
5'-0"
NEED 36"
TO PASS
2'-10 1/4"
40'-0"
PNL
2
SNOWBALL MACHINE
HAND SINK
FREEZER
HOT POT COUNTER 21"X 12'
3 COMP SINK
MOP SINK
3'-1 7/8"
NEED 36" TO PASS
2'-10 3/4"
26'-0"
3'-0"
BROOM CLOSET
B
B
1'-0 1/8"
SERVICE COUNTER
12'-0"
1'-6"
1'-6"
1'-6"
6'-1"
6'-1"
5'-0"
FRIDGE
FREEZER
1
A
A
7'-4"
4'-0"