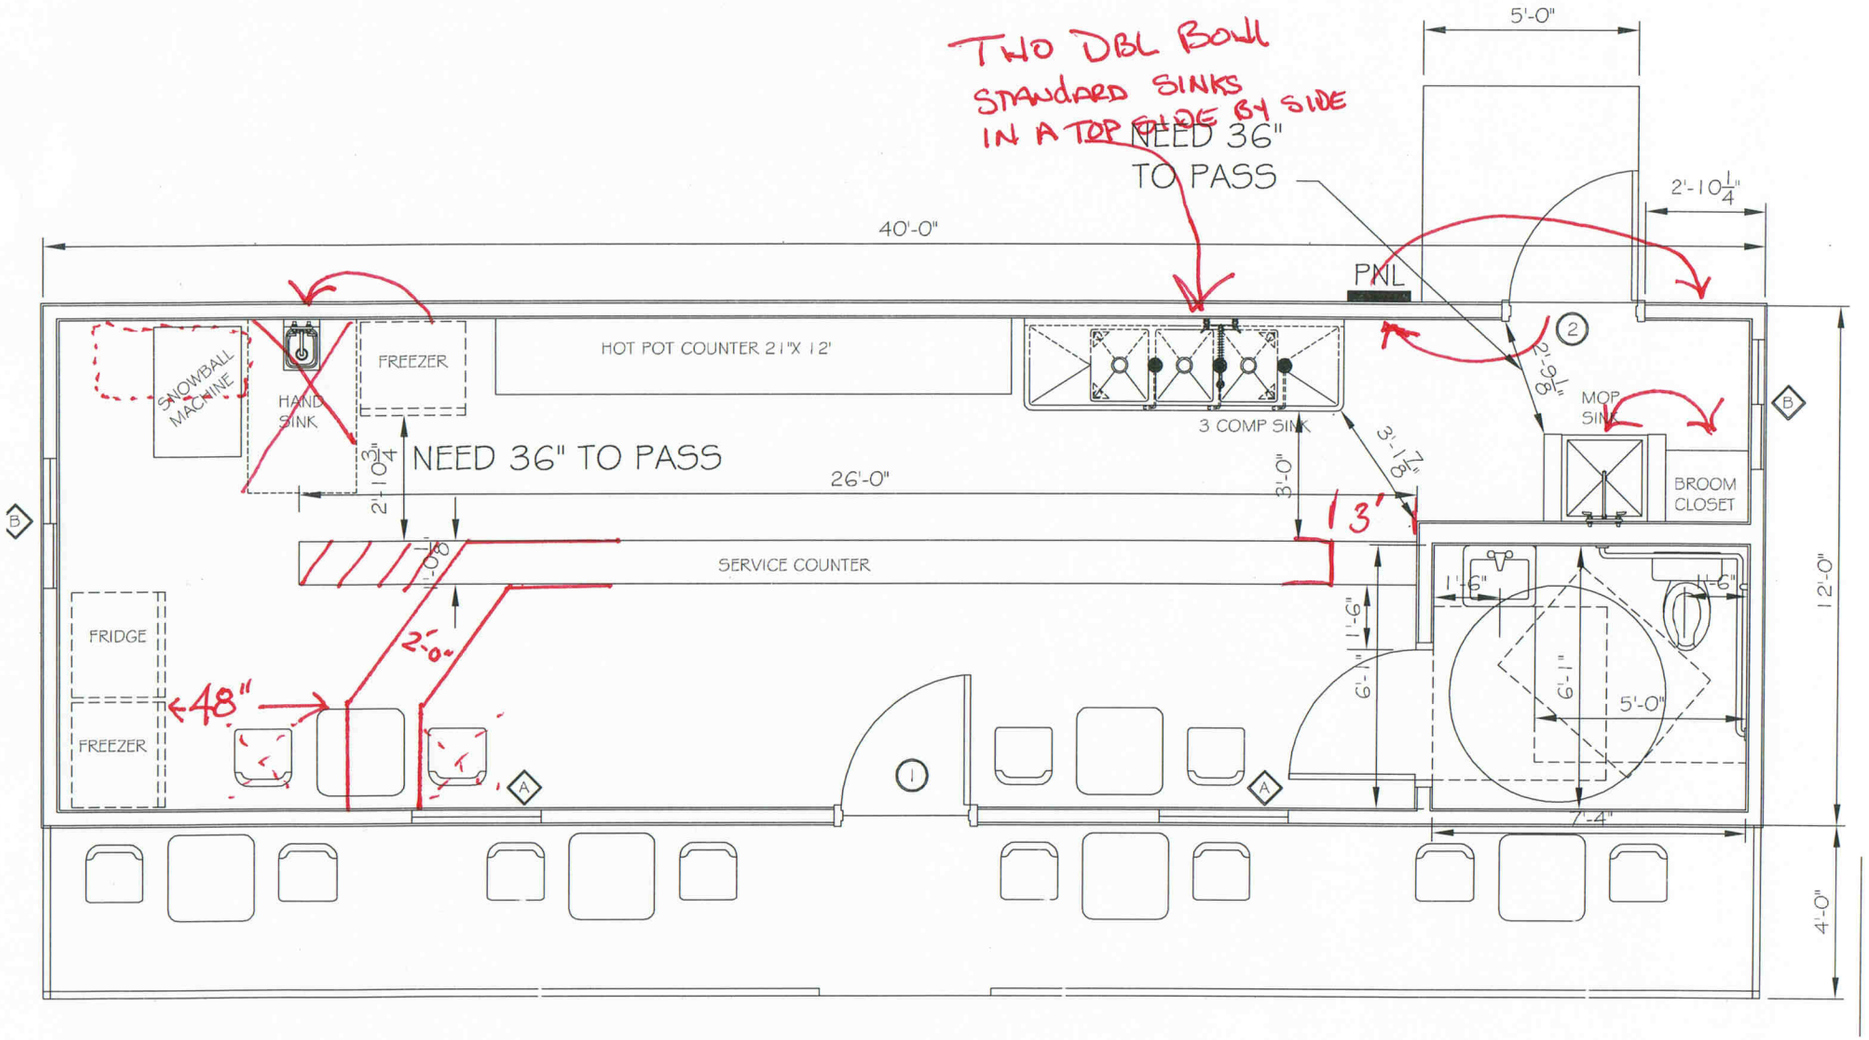
TWO DBL BOWL
STANDARD SINKS
IN A TOP SIDE BY SIDE
NEED 36"
TO PASS
5'-0"
2'-10 1/4"
40'-0"
PNL
SNOWBALL MACHINE
HAND SINK
FREEZER
HOT POT COUNTER 21"X 12'
3 COMP SINK
2'-9 1/8"
MOP SINK
BROOM CLOSET
NEED 36" TO PASS
2'-10 3/4"
26'-0"
3'-0"
3'-1 7/8"
3'
SERVICE COUNTER
1'-0"
2'-0"
48"
FRIDGE
FREEZER
1'-6"
1'-6"
9'-1"
6'-1"
6'-1"
5'-0"
12'-0"
7'-4"
4'-0"
A
B
1
2