

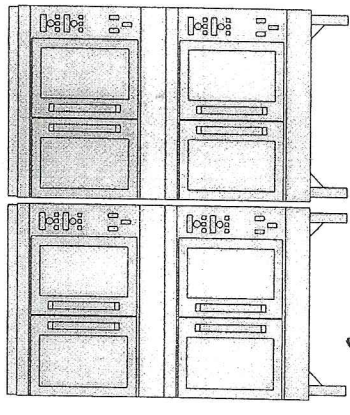


28 Hood



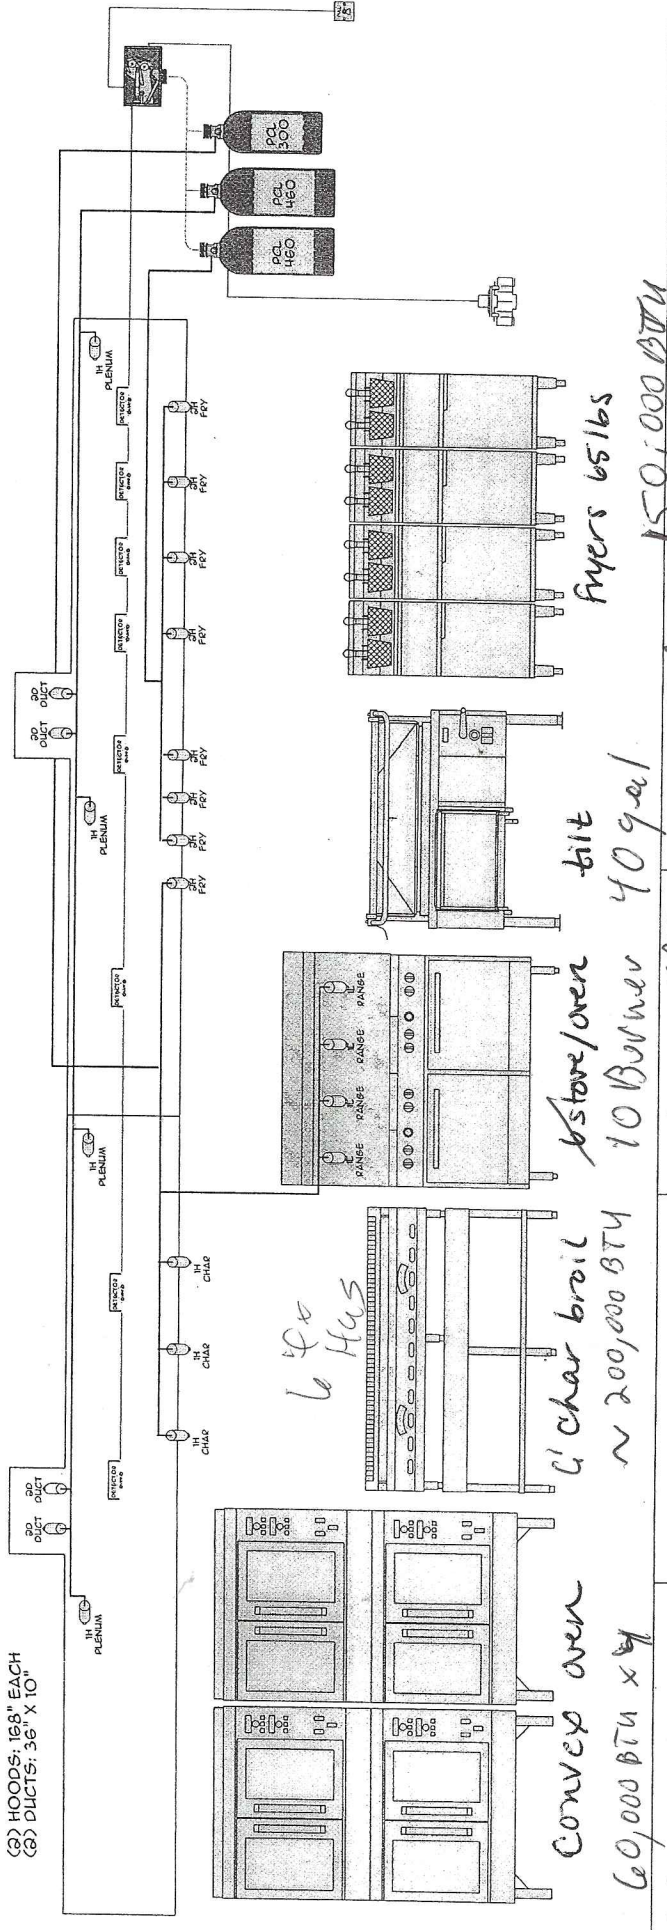


Convex oven  
60,000 BTU x 4

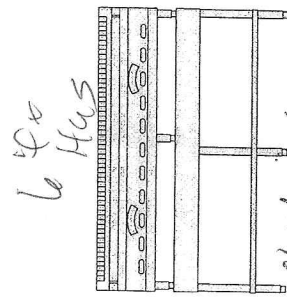


Char broil  
~ 200,000 BTU

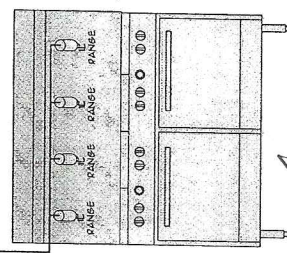

Store/oven  
10 Burner 40 gal

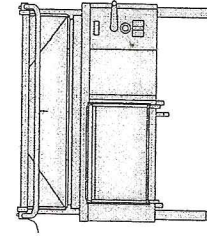

144,000 BTU

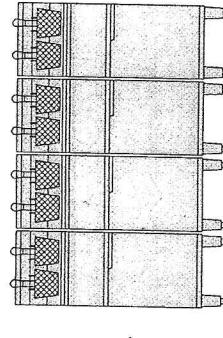

Fryer 65 lbs  
150,000 BTU

**GENERAL NOTES:**

- THIS SYSTEM SHALL BE INSTALLED IN ACCORDANCE WITH:
  - NFPA 17A
  - THE LOUISIANA STATE FIRE MARSHAL'S OFFICE
  - THE MANUFACTURER'S SPECIFICATIONS
  - ALL NOZZLES PROVIDED WITH NOZZLE CAPS
  - HOOD CANOPIES BY ACCUREX
  - DRAWING NOT TO SCALE
  - UTILIZING 35 OF 40 FLOW POINTS
  - ALL SUPPLY LINE TO BE 3/8" BLACK SCHEDULE 40 PIPE
  - ALL BRANCH LINE TO BE 3/8" BLACK SCHEDULE 40 PIPE


**PYRO CHEM KKII  
460+460+300  
WET CHEMICAL  
UL 300 LISTED**

**SYSTEM  
DETAIL**

**BILL OF MATERIALS**

- | QTY. | NAME                             |
|------|----------------------------------|
| 1    | ASCO GAS SHUT-OFF VALVE          |
| 4    | 1H PLENUM 10" HORIZ              |
| 4    | 2H PLENUM 10" HORIZ              |
| 8    | 2H FRYER 57"x51"x18" @ 2H"-H8"   |
| 4    | 1L RANGE 12"x26" @ 13"-2H"       |
| 3    | 1H CHARBROILER 26"x24" @ 2H"-H8" |
| 1    | PYRO CHEM NWHH-3 CONTROLHEAD     |
| 2    | PULL STATION                     |
| 1    | PYRO CHEM PCL 300                |
| 1    | PYRO CHEM PCL 460                |
| 4    | 3D DUCT LESS THAN 100' MAX       |

TIME OUT LOUNGE  
207 COUSIN ST.  
SLIDELL, LA 70458

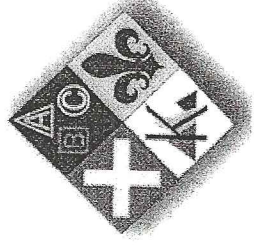

**FIRE AND SAFETY  
COMMODITIES, INC.**  
939 INDUSTRIAL RD.  
KENNER LA. 70069  
OFFICE: 504-465-5994  
FAX: 504-465-5998  
E-MAIL: SAGE@FIRESAFETYINC.NET  
FIRM: F58  
LIC. #: E379