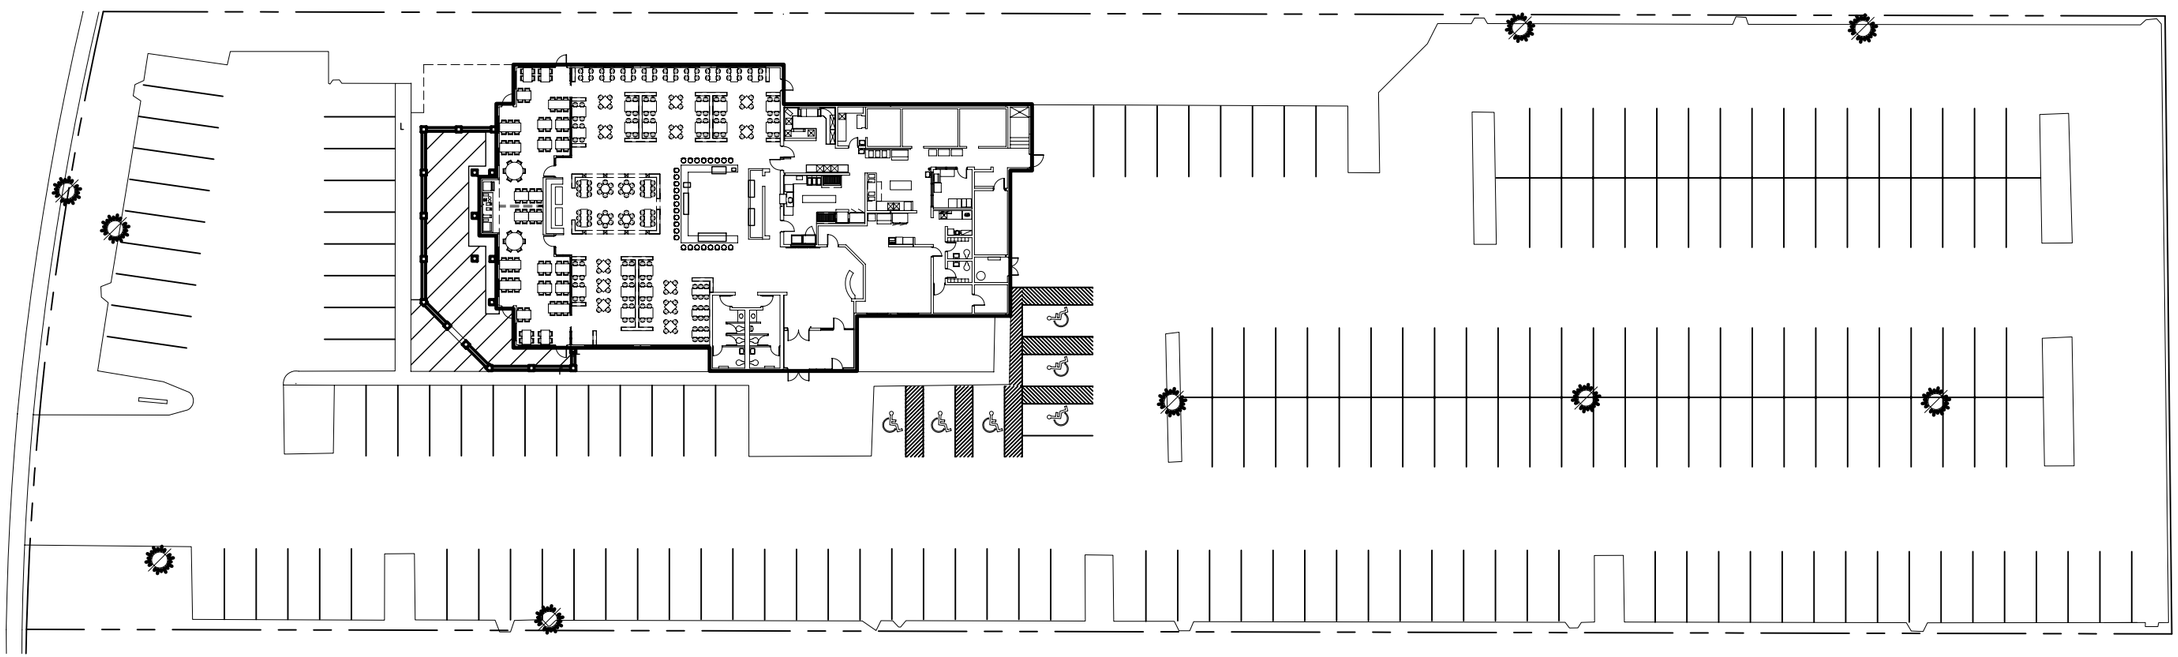

N

1 OVER ALL SITE PLAN WITH PARKING
SCALE: 1"=20'-0"

DAMMON ENGINEERING, INC.
Architects & Engineers
Chief Architect: Kevin J. Kincher, NCARB
Chief Engineer: Brian Mahon, PE
554 Old Spanish Trail
Slidell, LA 70458
www.dammonengineering.com
info@dammonengineering.com
PH: 985.649.5832
F: 985.641.5950

REVISIONS

#	DESCRIPTION	DATE

SEAL:

BUILDING RENOVATION PROJECT FOR

EL PASO RESTAURANT

1100 ROBERT BOULEVARD
SLIDELL, LA 70458

JOB No:	2242	DATE:	07-09-15
DRAWN BY:	CKD	CHECKED BY:	BAM

The above drawings and specifications, designs and arrangements represented herein, are and shall remain the property of Dammon Engineering, and no part thereof shall be copied, disclosed to others, or used in connection with any work or project other than the specified project for which they have been prepared and developed without the written consent of Dammon Engineering. These drawings and specifications shall remain the property of Dammon Engineering. Visual contact with these drawings or specifications shall constitute proof of subscription to the above restrictions.

SHEET TITLE:
OVER ALL SITE PLAN WITH PARKING

DRAWING NUMBER:

C102

SHEET No: 1 of #2

FILE NAME: J:\-- RESTAURANT\2242 - ELPASO IN SLIDELL LA\Drawings\Current Drawings\C102-Site parking Plan.dwg PLOT DATE & TIME: Tuesday, June 16, 2015 10:07:54 AM

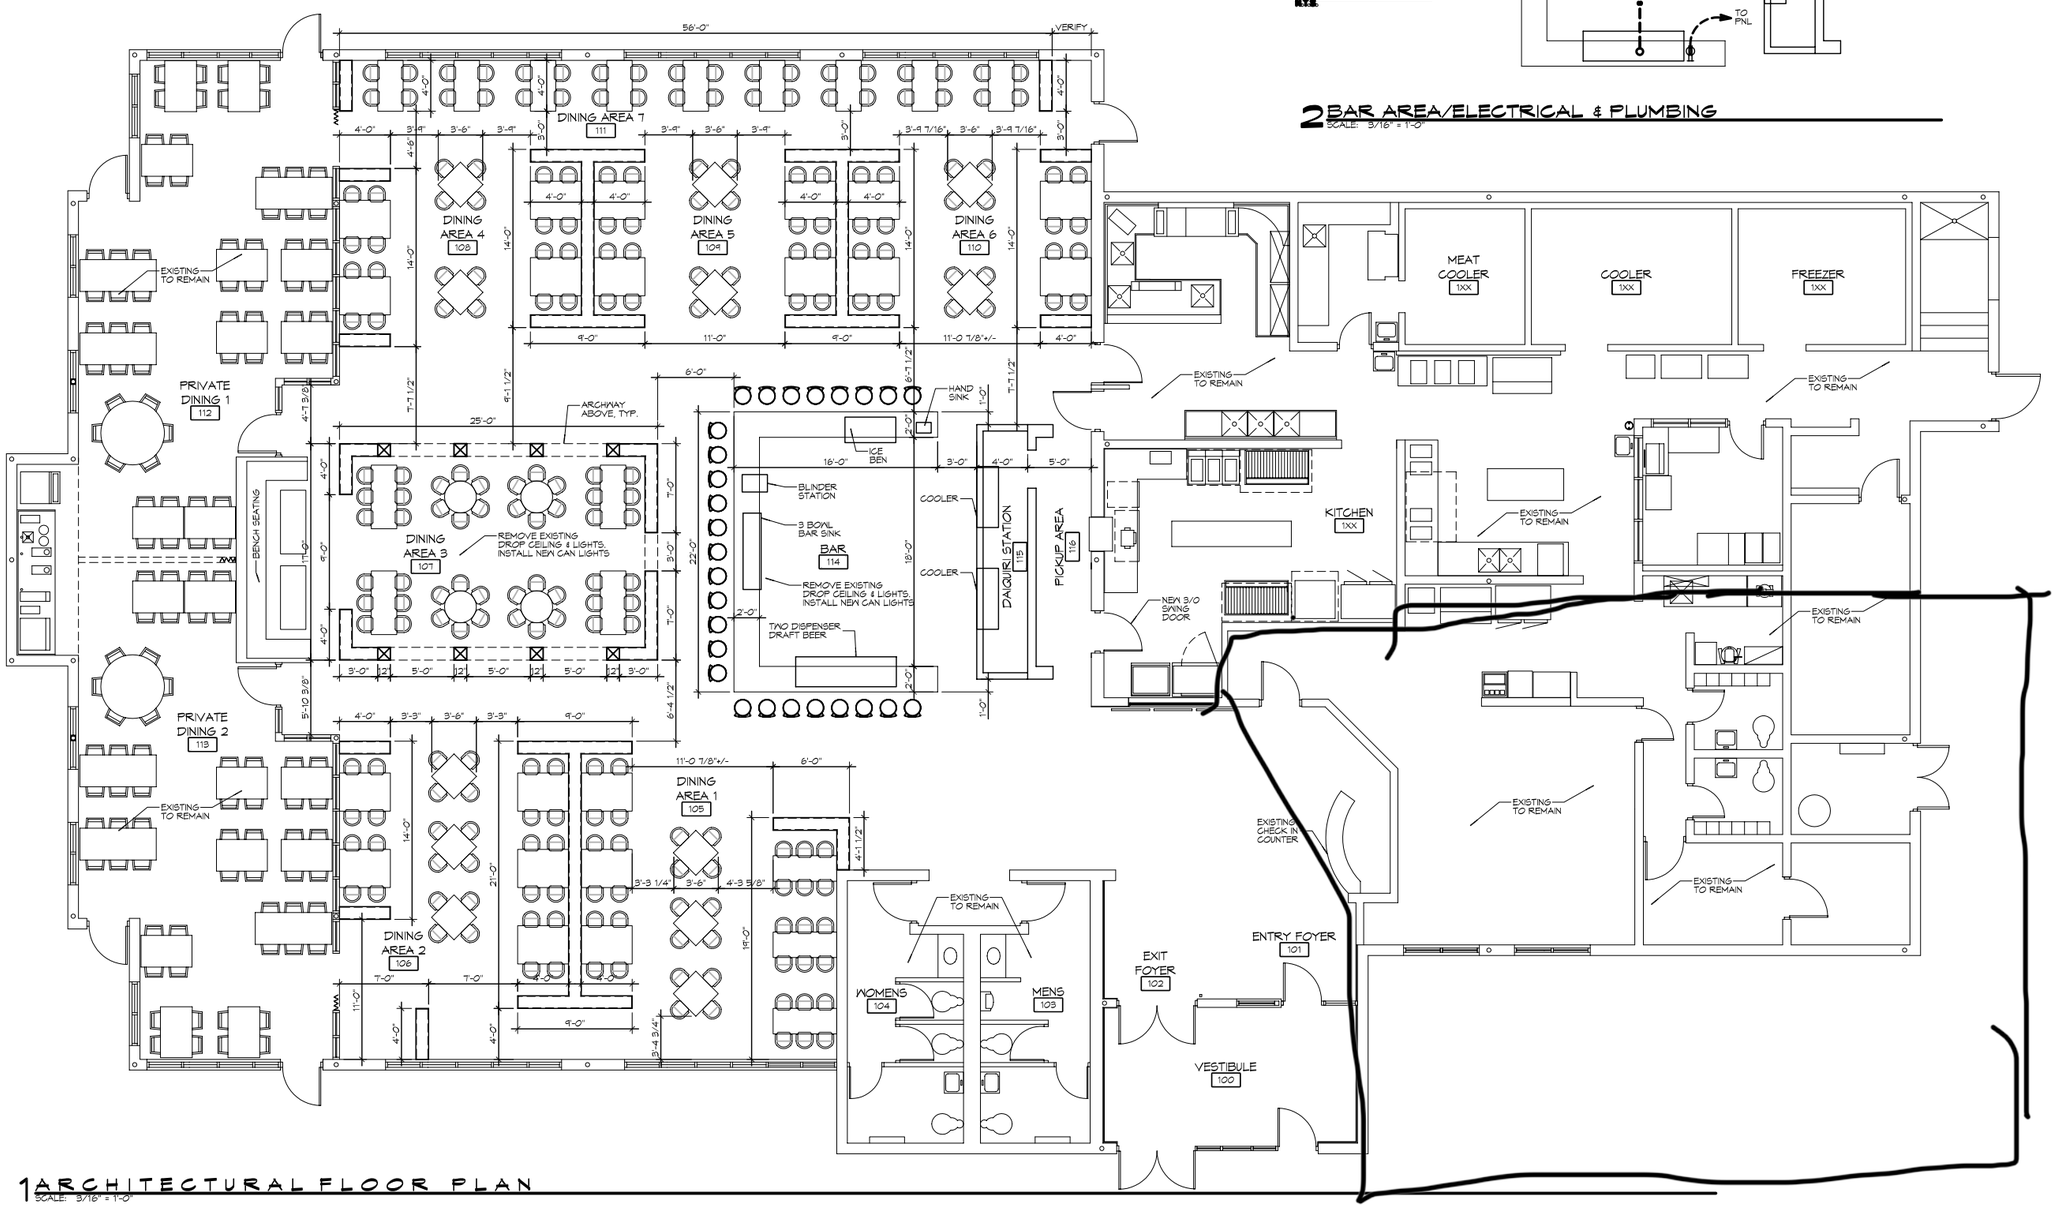

1 ARCHITECTURAL FLOOR PLAN
SCALE: 3/16" = 1'-0"

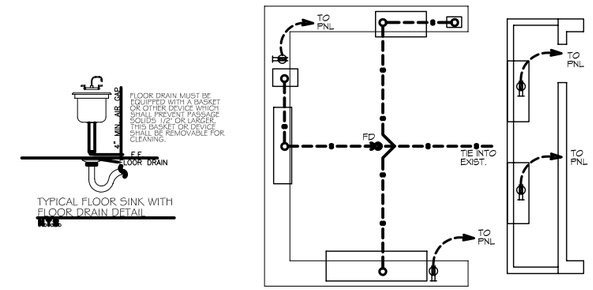

2 BAR AREA/ELECTRICAL & PLUMBING
SCALE: 3/16" = 1'-0"

DAMMON ENGINEERING, INC.
Architects & Engineers
www.dammonengineering.com
info@dammonengineering.com
PH: 985.649.5832
F: 985.641.5950
Chief Architect: Kevin J. Kinchen, NCARB
Chief Engineer: Brian Mistich, PE
554 Old Spanish Trail
Slidell, LA 70458

#	DESCRIPTION	DATE

REVISIONS

SEAL:

BUILDING RENOVATION PROJECT FOR

EL PASO RESTAURANT

1100 ROBERT BOULEVARD
SLIDELL, LA 70458

JOB No: 2242 | DATE: 5-27-15
DRAWN BY: JTL | CHECKED BY: CKD

The design shown, described and represented herein, in the drawings, renderings and photographs is the property of Dammon Engineering, Inc. and may not be used in whole or in part without the express written consent of Dammon Engineering, Inc. Any use or re-use of these plans without the express written consent of Dammon Engineering, Inc. is prohibited.

SHEET TITLE:
ARCHITECTURAL FLOOR PLAN

DRAWING NUMBER:
A101

SHEET No: ? of #