


Lighting Plan
 1st Floor
 1/4" = 1'-0"

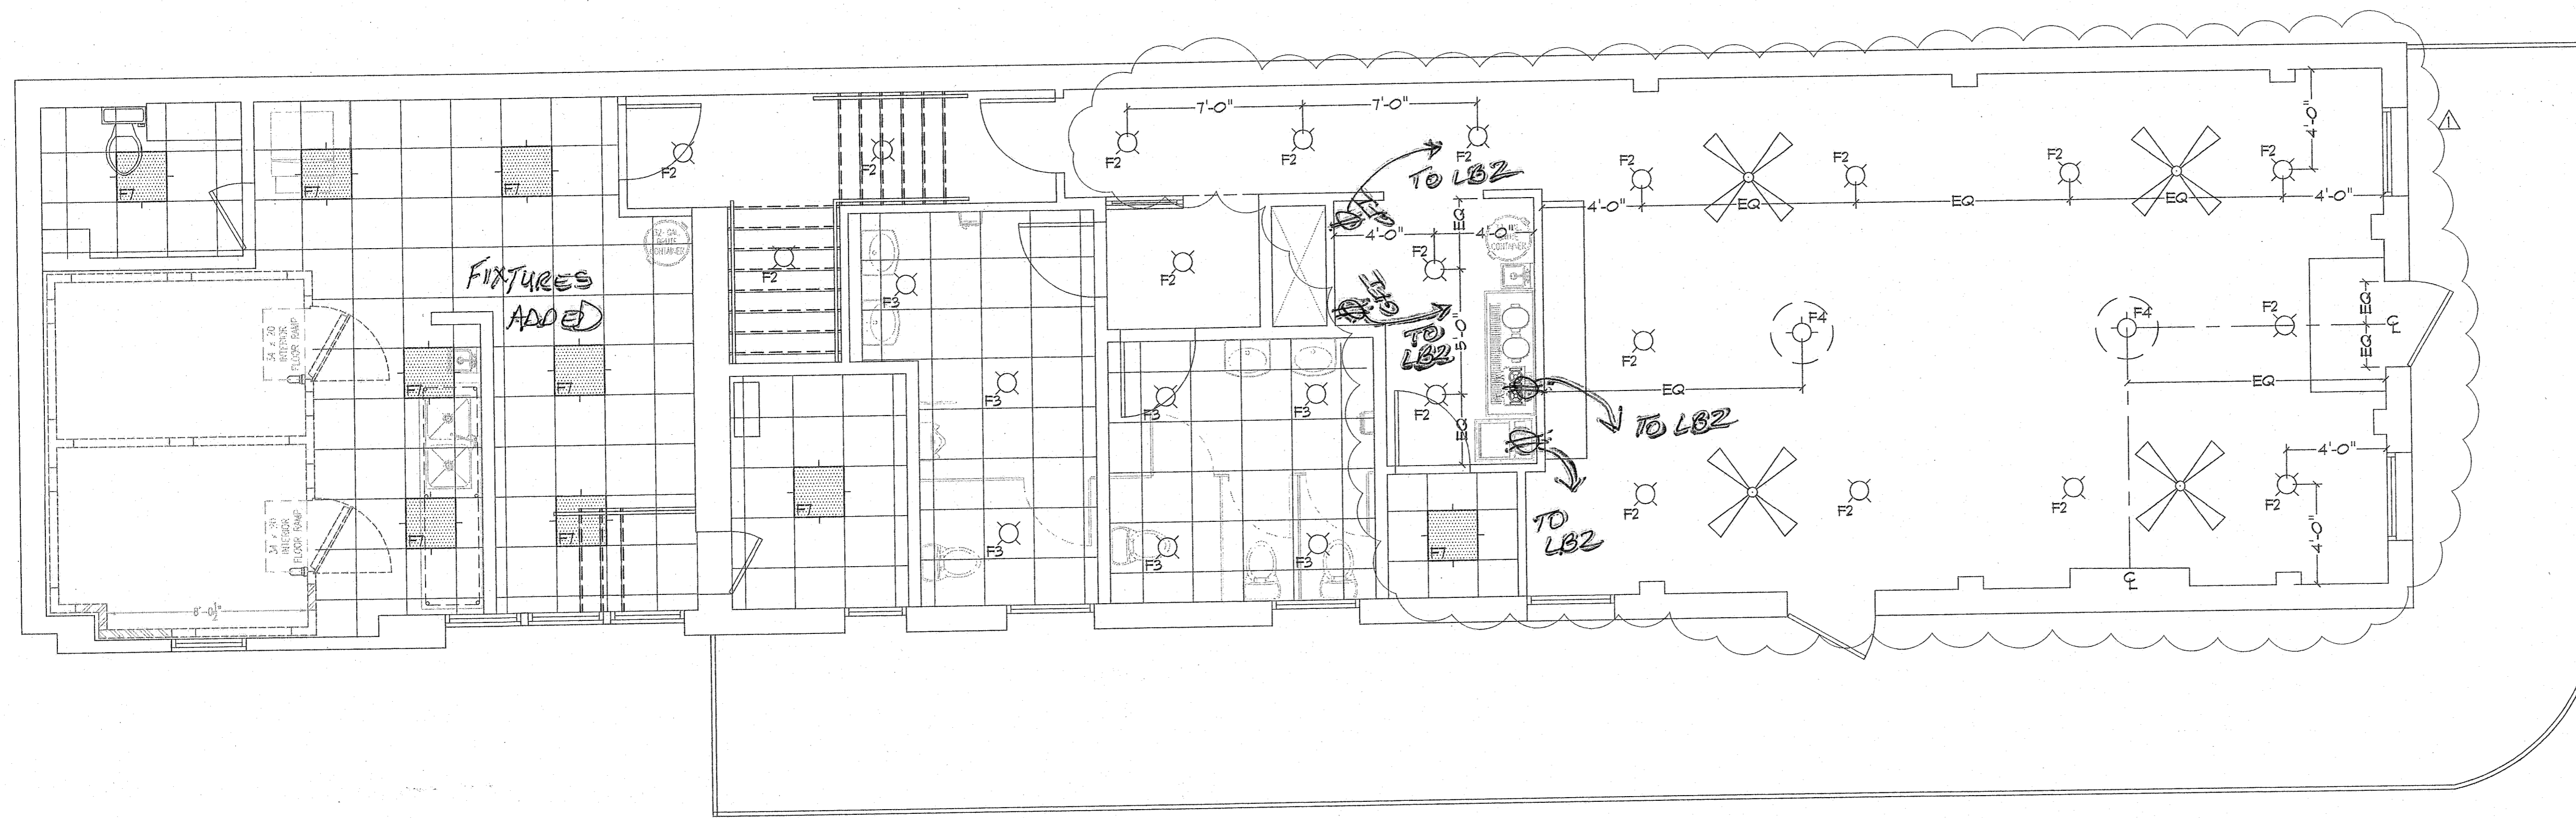

Lighting Plan
 2nd Floor
 1/4" = 1'-0"

LIGHTING LEGEND	
	ACOUSTICAL CEILING TILE AS SCHEDULED
	NOT USED
	PHILIPS LIGHTOLIER LYTEPROFILE 4" 2700K LED DIMMABLE DOWNLIGHT, 1600 LUMENS PHILIPS SUNRISE ELECTRONIC WALL DIMMER FRAME N KIT: P-4-R-D-15-N-ZIO-U-VB LIGHT ENGINE: P-4-R-D-8-21-VB REFLECTOR: P-4-R-D-CL ALTERNATE: DIMMABLE RECESSED INCANDESCENT DOWNLIGHT W/2700K LED BULB. OWNER TO APPROVE SAMPLE BULB & LUMEN OUTPUT PRIOR TO CONTRACTOR ORDERING.
	PHILIPS LIGHTOLIER LYTEPROFILE 4" 2700K LED DOWNLIGHT, 1000 LUMENS FRAME N KIT: P-4-R-D-15-N-ZIO-U-VB LIGHT ENGINE: P-4-R-D-8-21-VB REFLECTOR: P-4-R-D-CL ALTERNATE: RECESSED INCANDESCENT DOWNLIGHT W/2700K LED BULB. OWNER TO APPROVE SAMPLE BULB & LUMEN OUTPUT PRIOR TO CONTRACTOR ORDERING.
	TROY LIGHTING ANDROMEDA F4826 42"W x 37"H x 9" MAX HGT. OWNER SUPPLIED, CONTRACTOR INSTALLED.
	TROY LIGHTING ANDROMEDA INTERIOR SCONCE, B4822, 5 1/4" x 13 1/4" x 6 1/2" PROJ. OWNER SUPPLIED, CONTRACTOR INSTALLED
	NOT USED
	METALUX ZEN LED 2X2' TROFFER LED MODULE 3400 LUMENS, 3800K ZENLDI-34-UNV-L835-CDHJ
	JESCO LIGHTING INFINA LED FLEXIBLE LINEAR DL-FLEX STATIC SERIES, DRIVERLESS, 2700K DL-AC-FLEX-27 MOUNTING: DL-AC-FLEX-MC. VERIFY MOUNTING W/ ETAGERE FABRICATOR ALAN TUDURY
	CALIFORNIA FAN COMPANY RAINDANCE TRADITIONAL 52" BLADE CEILING FAN, BLACK BLADES, ROTARY SPEED CONTROL, 24" DOWNROD OWNER SUPPLIED, CONTRACTOR INSTALLED

ALL STAR ELECTRIC
 PROJECT RECORD
 12/17

301 Royal Street
 New Orleans, Louisiana

Plans